COUNTY SURVEYORS FILE DATA
DO NOT REMOVE FROM OFFICE

FILED
RECEIVED KB
OCT 1 1979
COUNTY SURVEYOR
DOUGLAS COUNTY, ORE.

MAP FILE M80-16

SURVEY IN SECTION 9, TOWNSHIP 25 SOUTH, RANGE 4 WEST, W.M.
Surveyed for Taxco Corporation by Landline Development Company
September, 1979 Scale 1" = 100'

○ Set 5/8" Iron Rods
● Found 5/8" Iron Rods unless otherwise noted

REGISTERED
OREGON
LAND SURVEYOR
Bruce R. Rogers
JULY 10, 1964
BRUCE R. ROGERS
660

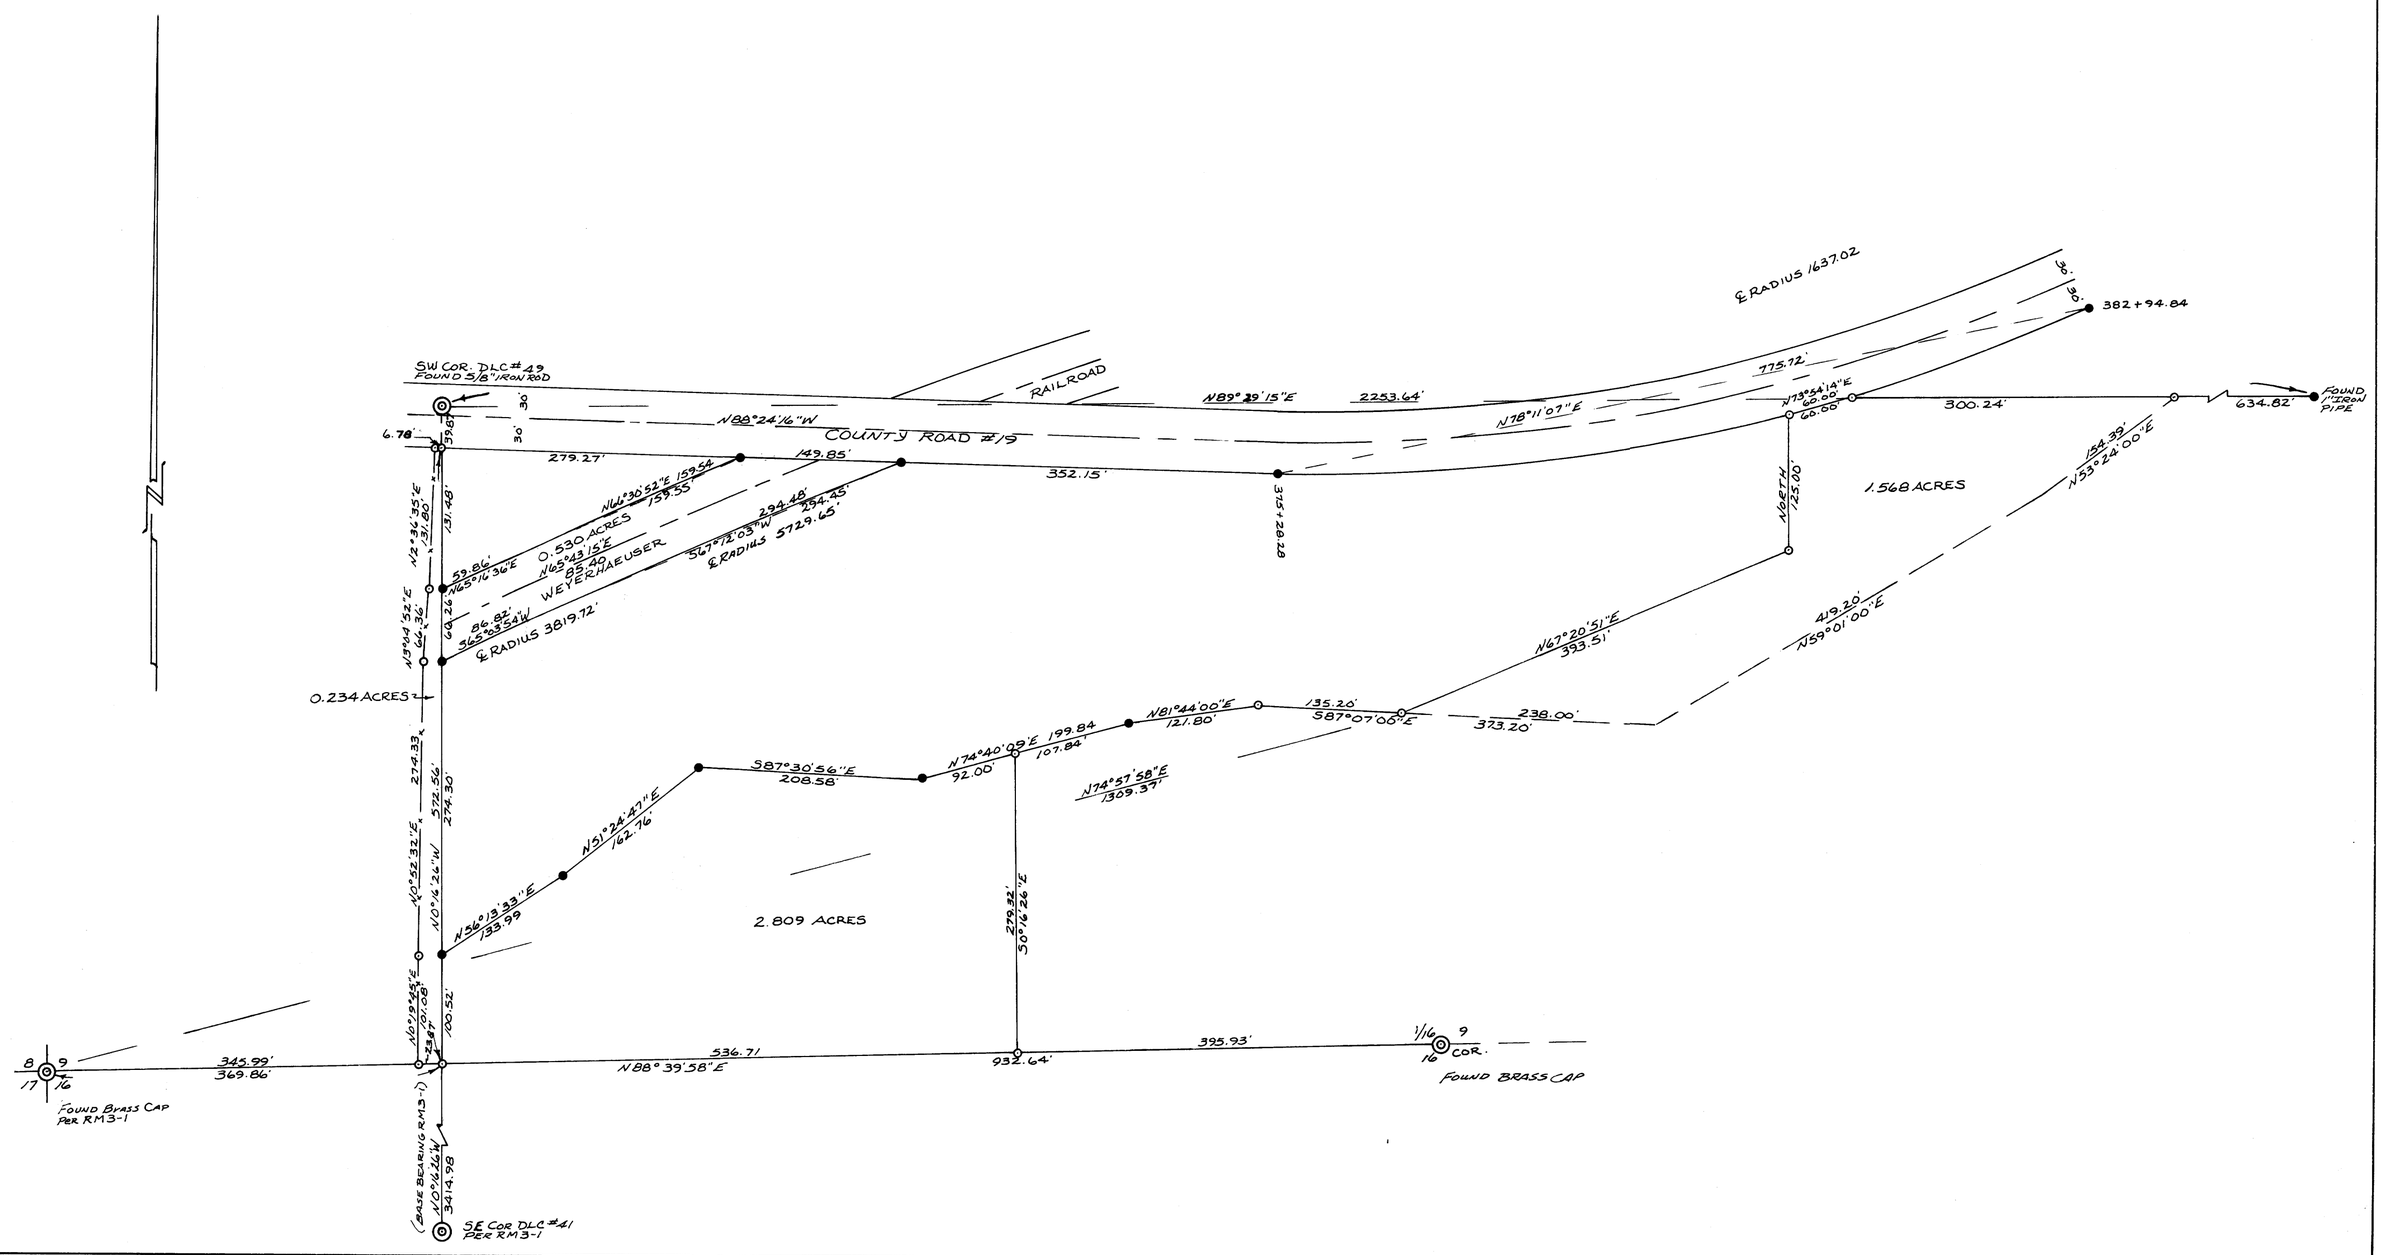

MAP FILE M80-16