COUNTY SURVEYORS FILE DATA
DO NOT REMOVE FROM OFFICE

SURVEY OF PROPERTY DESCRIPTION

IN THE NE 1/4 OF SECTION 17, T.29S. R.7W. W.M.

FILED
RECEIVED
COUNTY SURVEYOR
LANE COUNTY, ORE.

FOR: DAN FUGATE

BY: A A SURVEYING SERVICE, INC.

OCTOBER 1979 SCALE: 1" = 200'

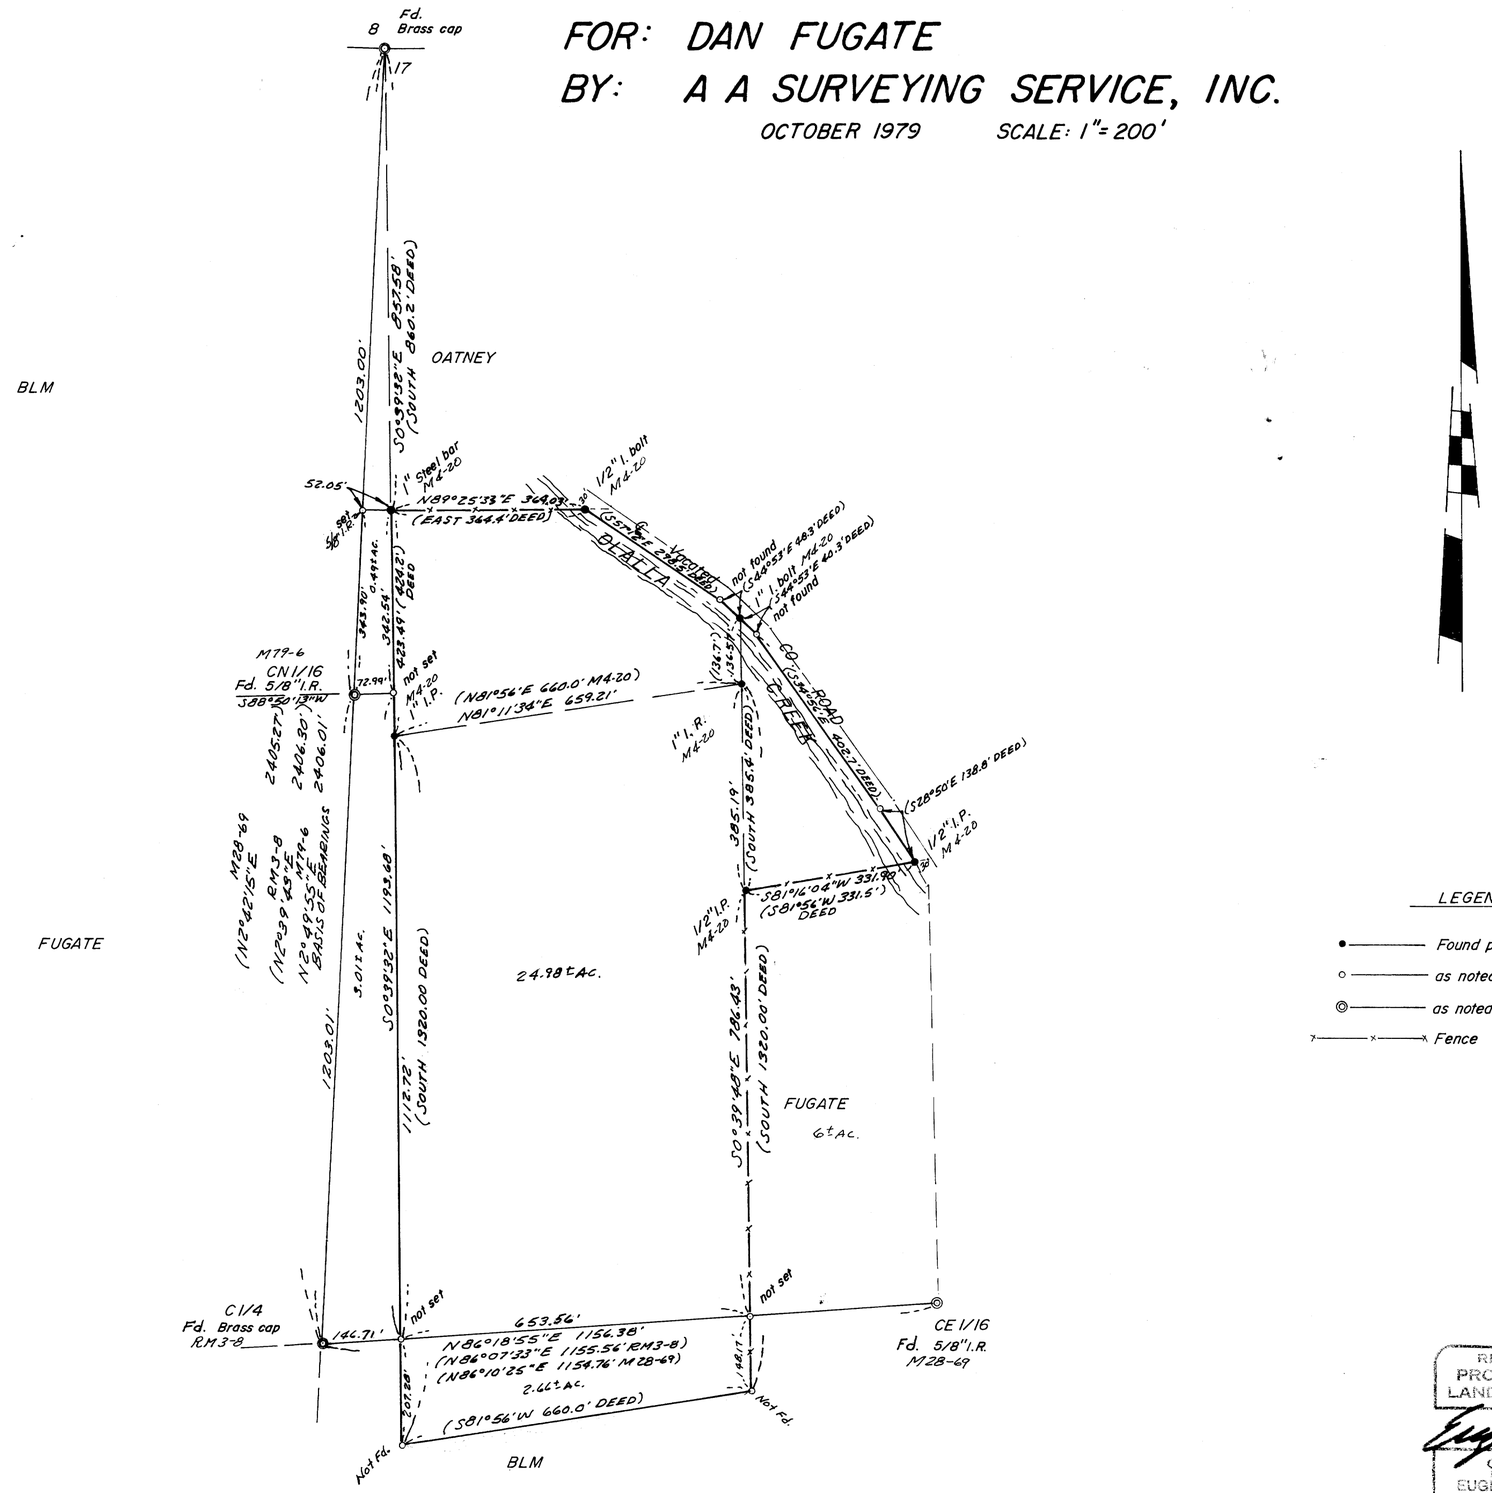

LEGEND

- Found point, as noted hereon (M4-20)
- as noted hereon
- as noted hereon
- Fence

REGISTERED
PROFESSIONAL
LAND SURVEYOR
OREGON
MAY 13, 1980
EUGENE A. BLOOM
492

MAP FILE M80-58

MAP FILE M80-58

112A-79 FB 20