MAP FILE 80-6

Survey in Block 4, Plat "M," Sutherlin Land & Water Co. Section 24, T25S, R6W, W.M.

COUNTY SURVEYORS FILE DATA
DO NOT REMOVE FROM OFFICE

FILED
RECEIVED
SEP 24 1979
COUNTY SURVEYOR
DOUGLAS COUNTY, ORE.

For: Gene Rodgers

By: BHW Engineering & Surveying

Scale: 1" = 200'
August 1979

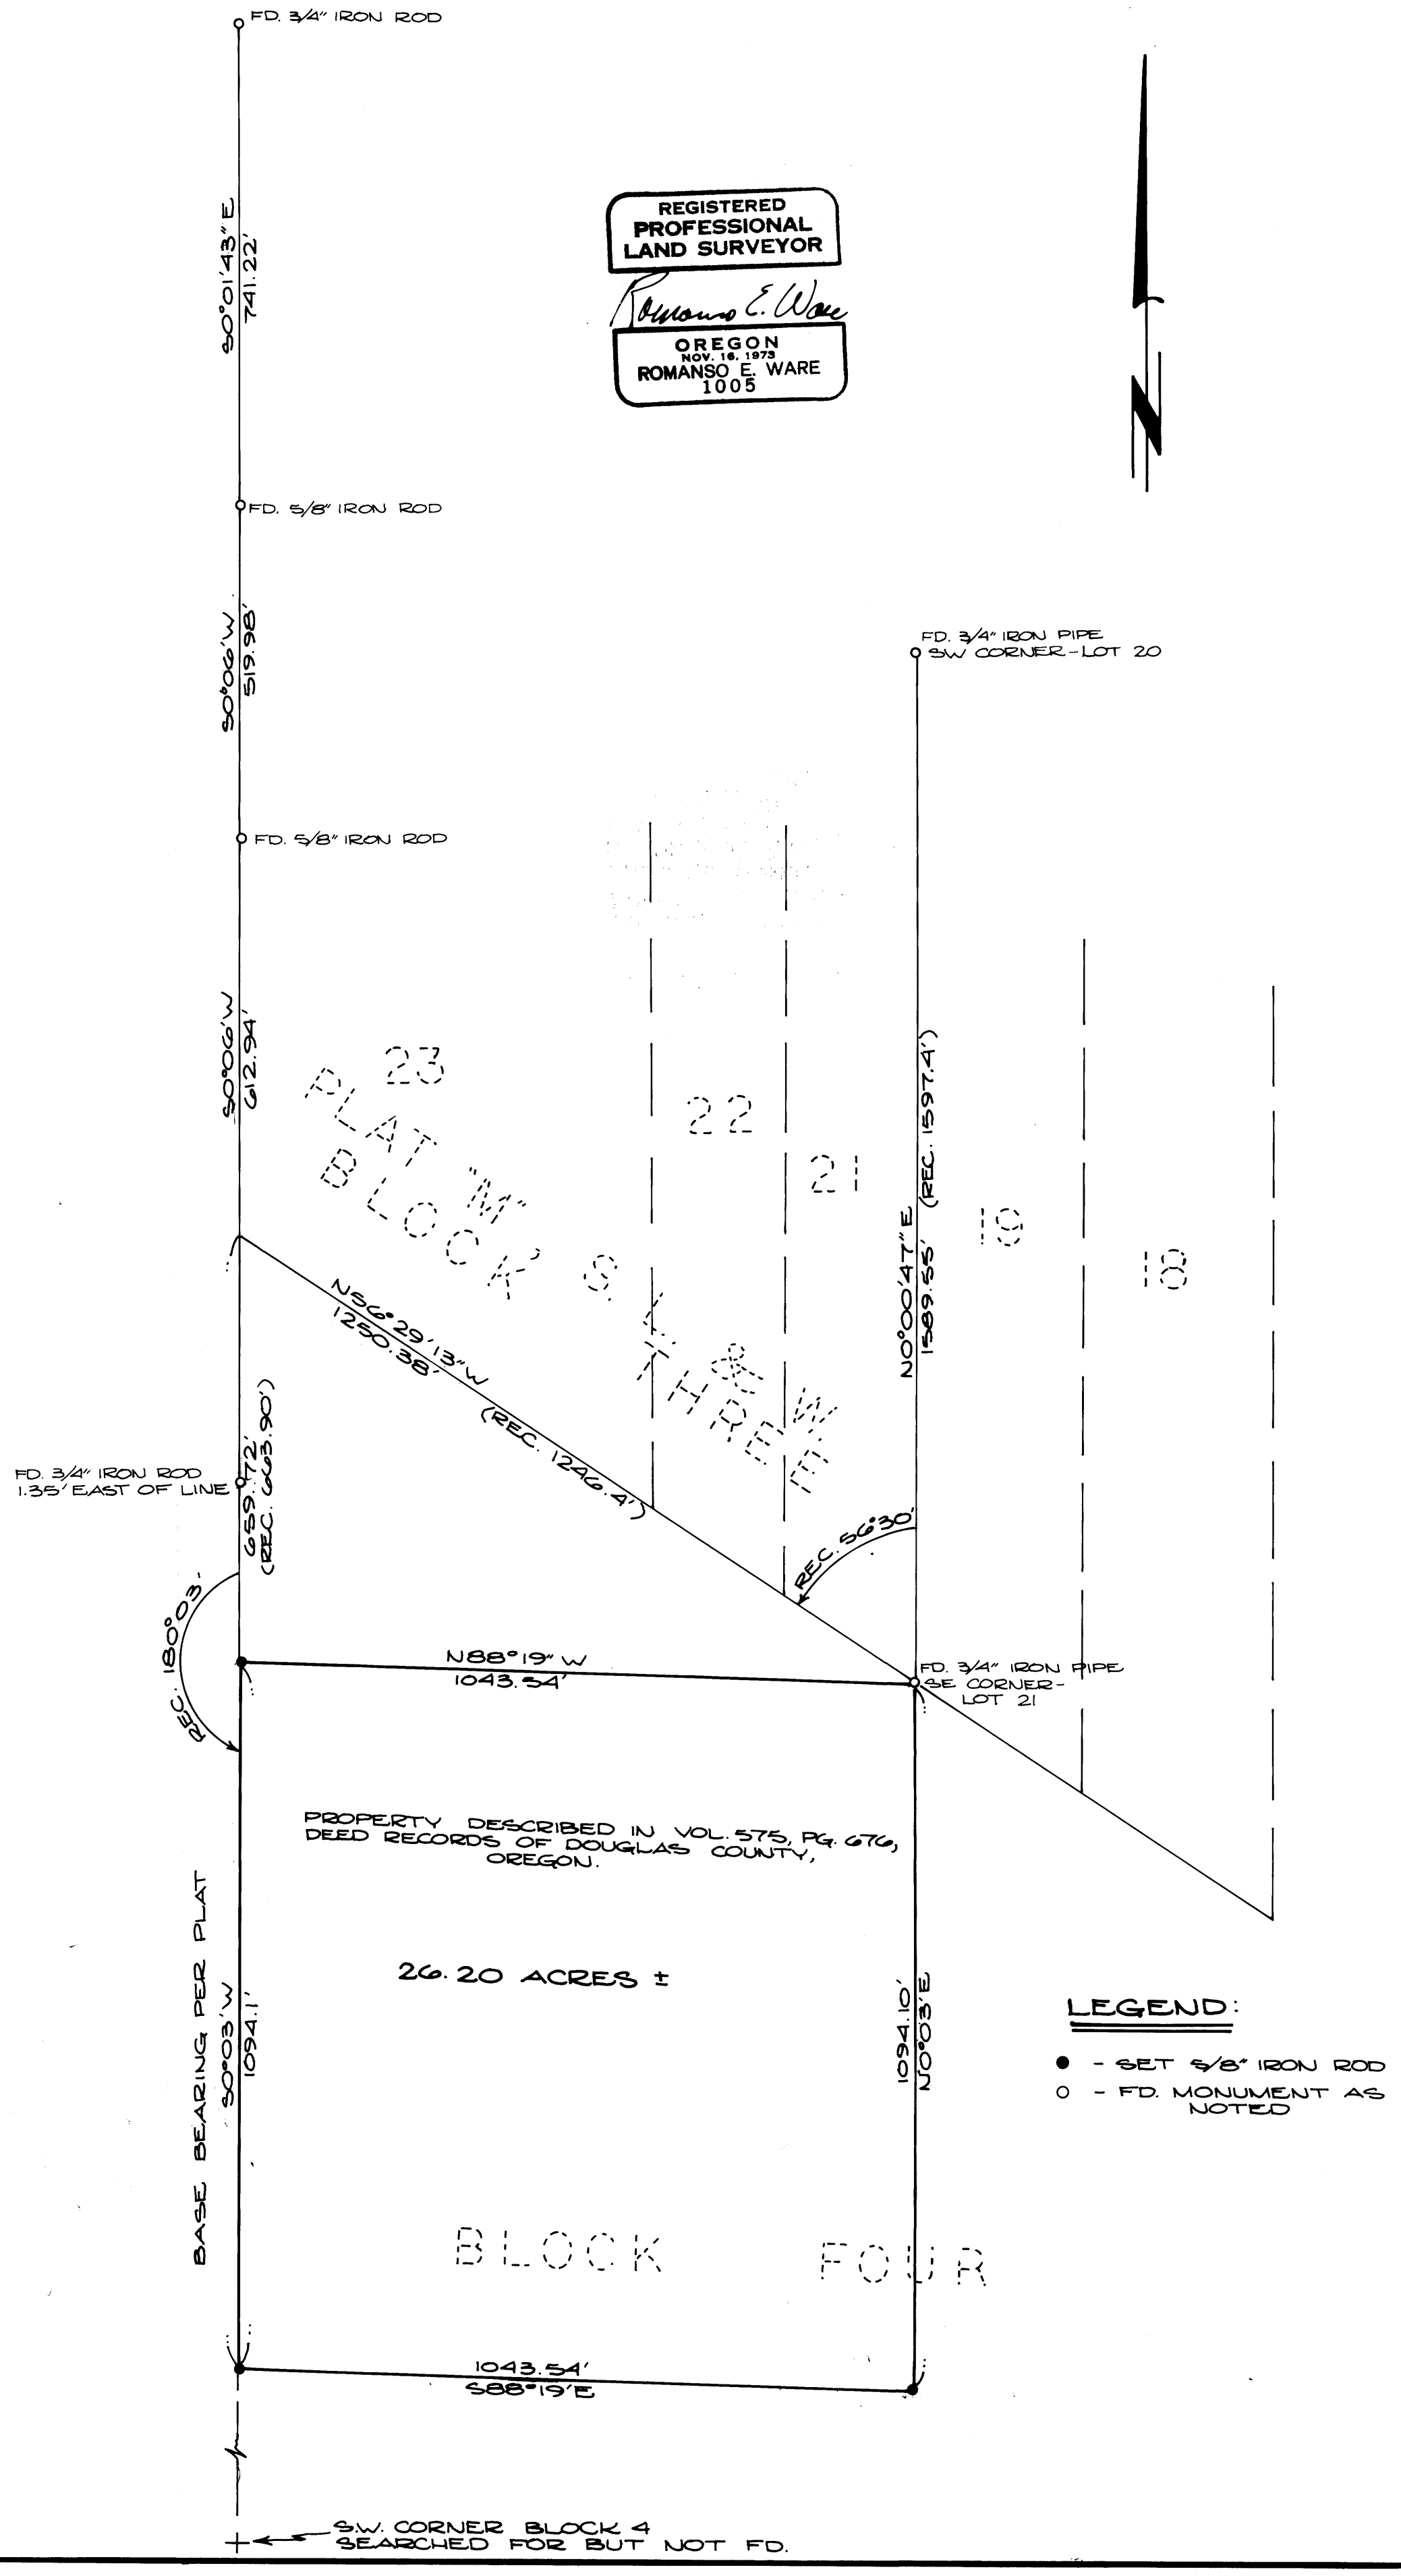

MAP FILE 80-6