MAP FILE M80-60

COUNTY SURVEYORS FILE DATA
DO NOT REMOVE FROM OFFICE

FILED 4
RECEIVED 12
NOV 13 1979
COUNTY SURVEYOR
DOUGLAS COUNTY, ORE.
4

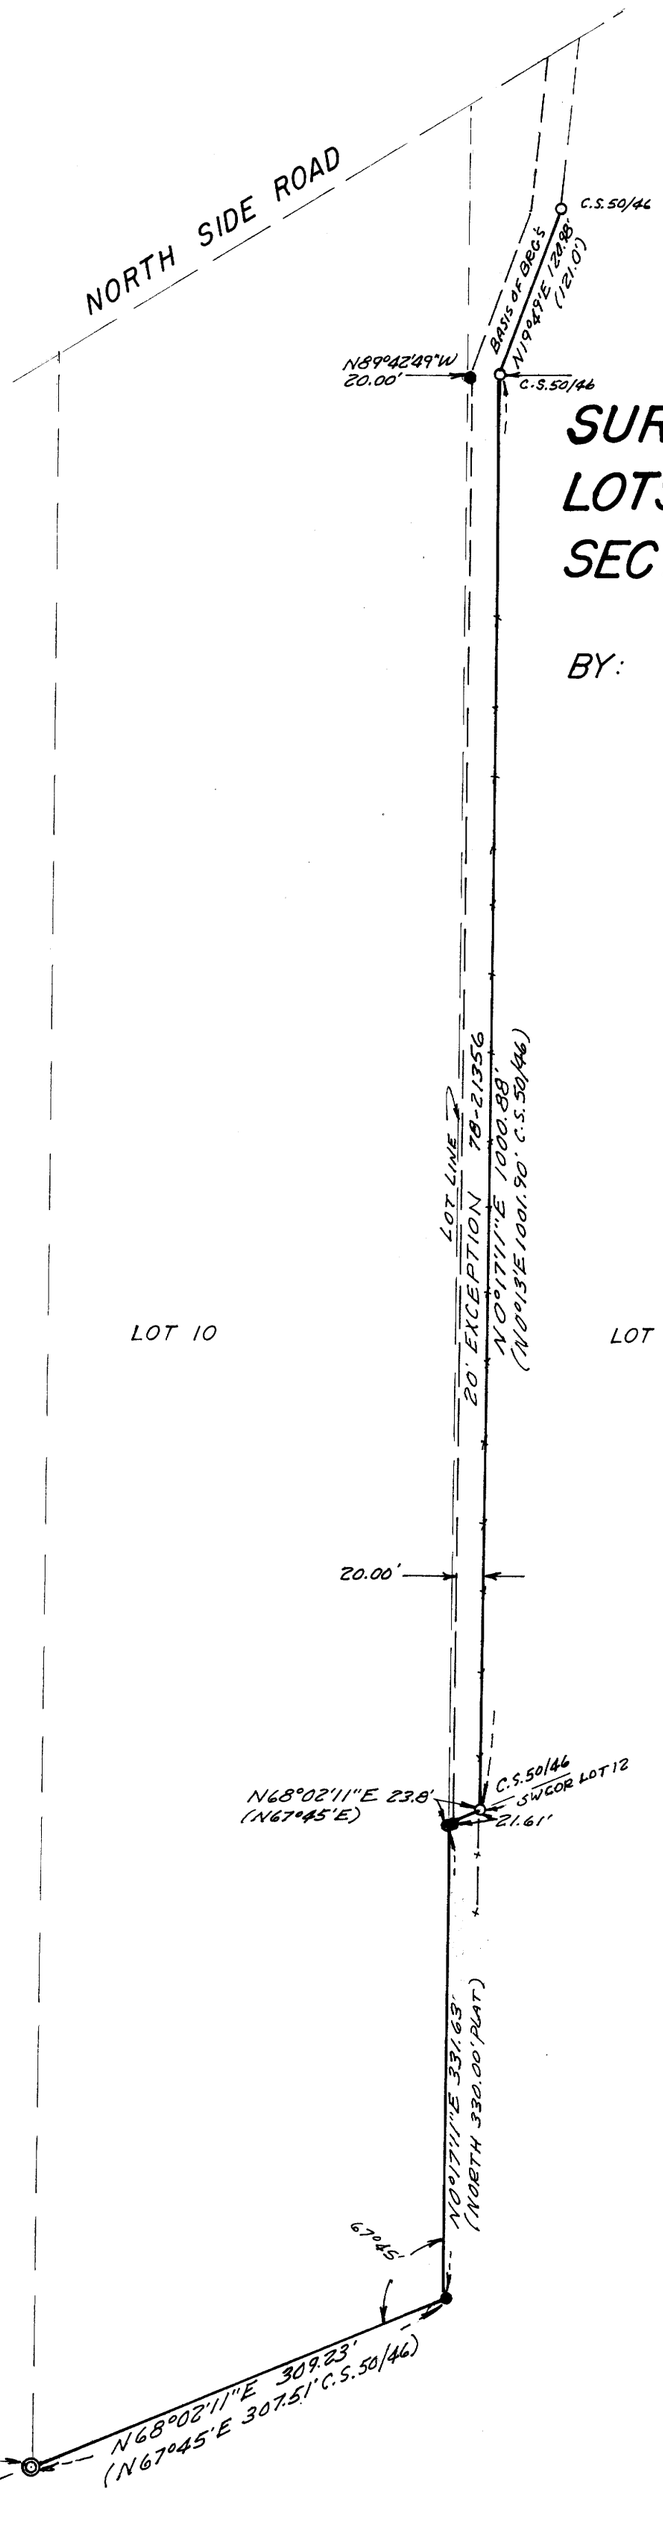

SURVEY FOR IVAN HOLM – SITUATED IN LOTS 10 & 12 BLOCK 3, PLAT "D" S.L. & W.C. SECTION 11 T.25S. R.5W. W.M.

BY: A A SURVEYING SERVICE, INC.
P.O. BOX 454 ROSEBURG, OREGON

NOVEMBER 1979 SCALE: 1" = 100'

REGISTERED
PROFESSIONAL
LAND SURVEYOR
Eugene A Bloom
OREGON
MAY 13, 1960
EUGENE A. BLOOM
492

LEGEND

- o ——— Found 3/4" iron pipe
- ● ——— Set 5/8" iron rod
- ◎ ——— Found 2" iron pipe

132-79 FB 22

MAP FILE M80-60