TOWNSHIP 24 SOUTH, RANGE 4 WEST, OF THE WILLAMETTE MERIDIAN, OREGON

ADMINISTRATIVE SURVEY

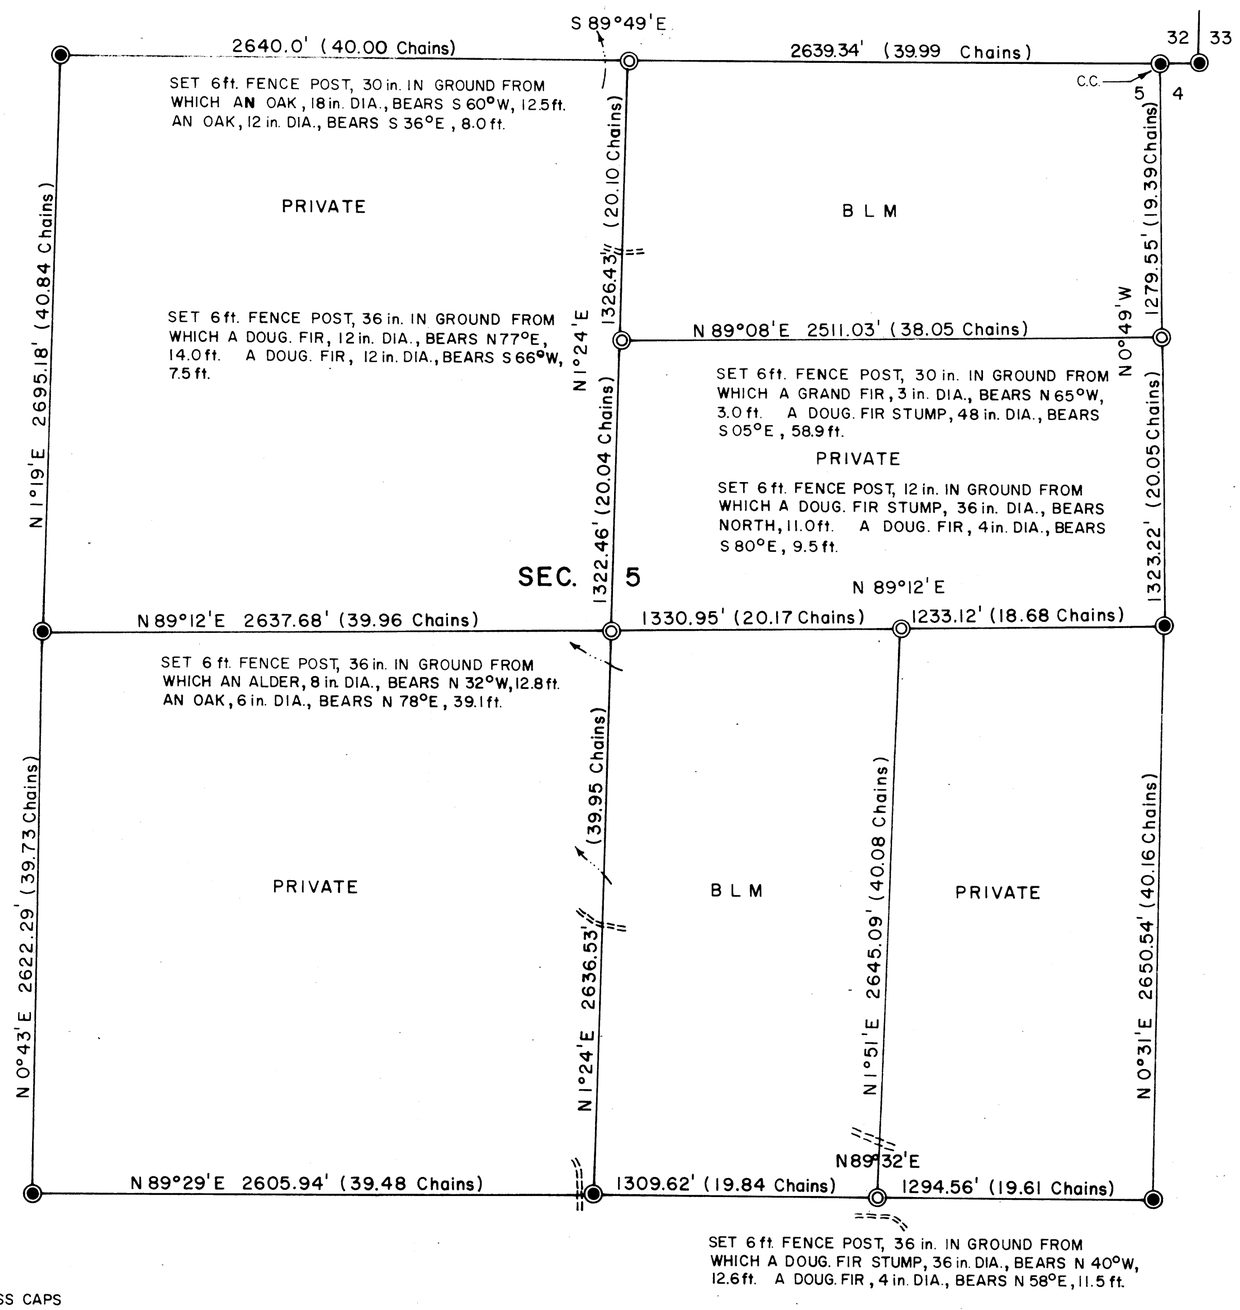

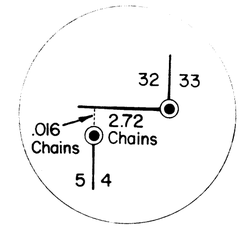

FILED & RECEIVED
NOV 26 1979
COUNTY SURVEYOR
DOUGLAS COUNTY, ORE.

THIS PLAT REPRESENTS AN ADMINISTRATIVE SURVEY OF T24S, R4W, SEC. 5, WILLAMETTE MERIDIAN. BEARINGS ARE DETERMINED BY DIRECT OBSERVATION OF THE SUN AND ALL BLM PROPERTY LINES ARE TAGGED. BEARING TREE DISTANCE IS TO FACE OF TREE.

APPROXIMATELY 1700 ft. OF FENCE ON SOUTH HALF OF NORTH/SOUTH CENTER LINE IS ON BLM. APPROXIMATELY 400 TO 500 ft. OF FENCE ON EAST HALF OF THE NORTH BOUNDARY OF SEC. 5, IS ON BLM.

COUNTY SURVEYORS FILE DATA DO NOT REMOVE FROM OFFICE

LEGEND

- CORNERS FOUND ALL CO. BRASS CAPS
- CORNERS SET
- INTERMITTENT STREAM
- ROADS

500 0 500 1000
SCALE IN FEET

U.S. BUREAU OF LAND MANAGEMENT

ROSEBURG DISTRICT — OREGON

DRAWN BY KURT DONNELLY — DATE 7-19-78

SURVEYED BY ALEX TUPYI — DATE JANUARY 1978

APPROVED BY Bruce P. Chambers, DISTRICT ENGINEER — DATE 8-28-78

MAP FILE MAP-74

MAP FILE MAP-74