COUNTY SURVEYORS FILE DATA
DO NOT REMOVE FROM OFFICE

SURVEY FOR DESCRIPTION

IN SECTION 31, T.28S.R.7W.W.M.

FOR: JIMMIE HANNA

BY: A A SURVEYING SERVICE INC

P.O. BOX 454, ROSEBURG, OREGON 97470

NOVEMBER 1979 SCALE: 1"=100'

FILED
RECEIVED JHH
NOV 29 1979
COUNTY SURVEYOR
DOUGLAS COUNTY, ORE.

MAP FILE M81-30

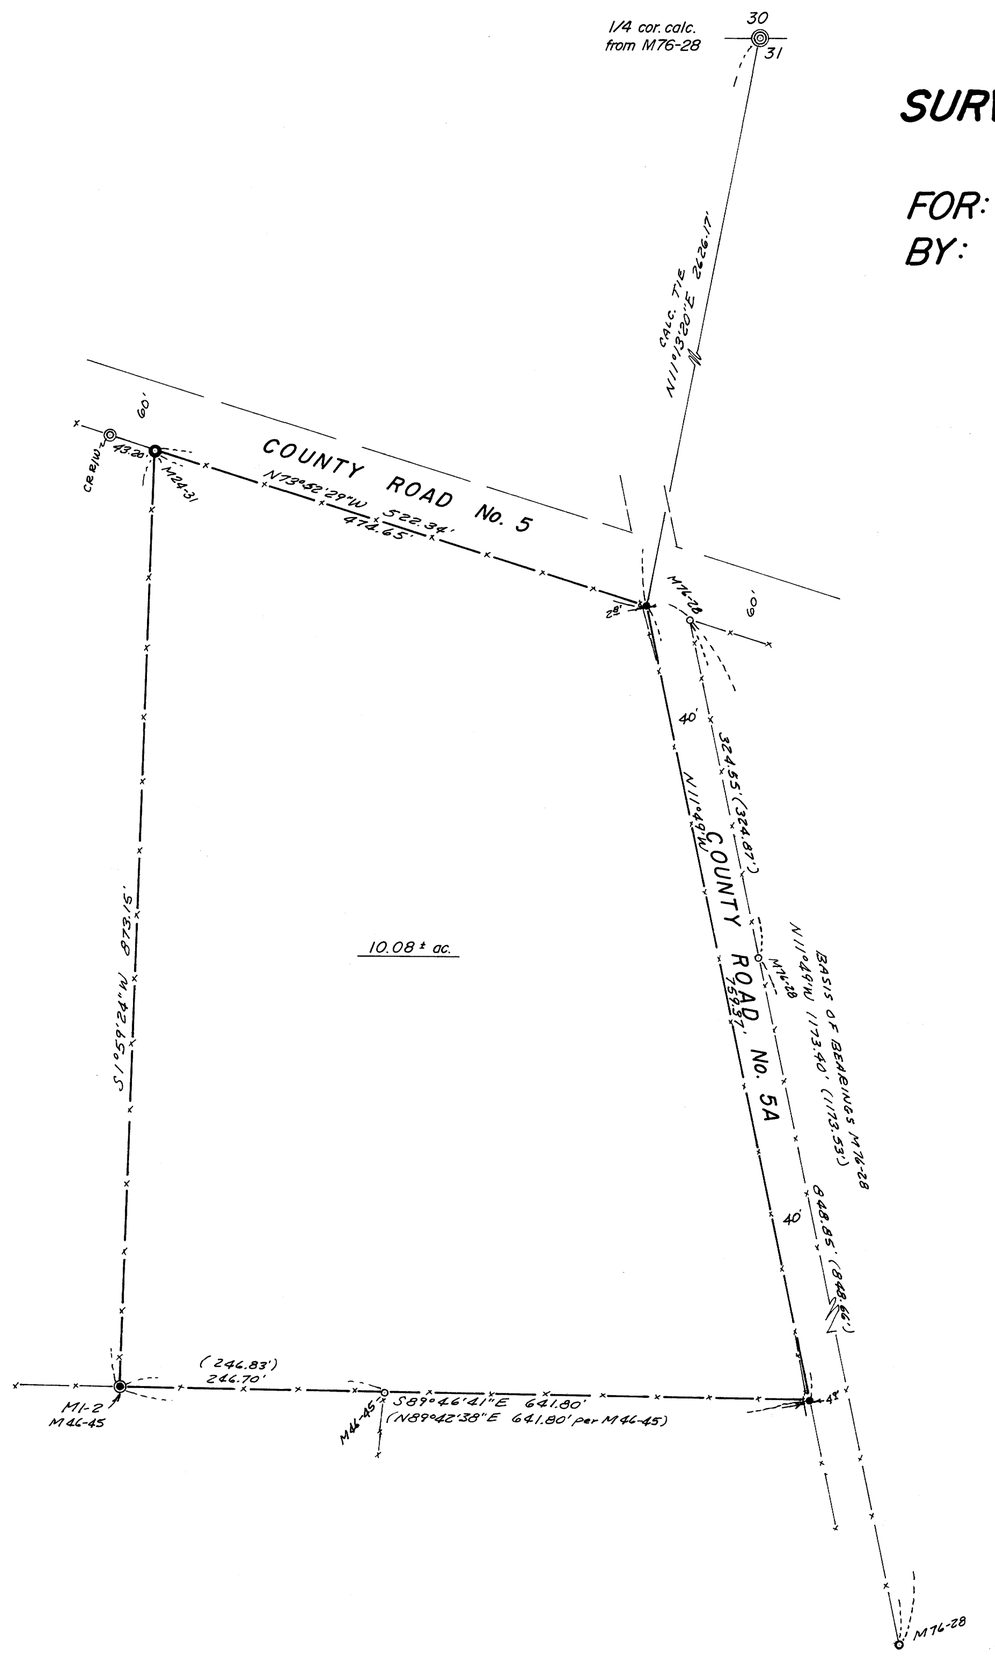

LEGEND

- Set 5/8" iron rod
- Found 5/8" iron rod
- Found 1" iron pipe
- Found 3/4" iron rod
- Found 1" axle

REGISTERED
PROFESSIONAL
LAND SURVEYOR

Eugene A. Bloom

OREGON
MAY 13, 1980
EUGENE A. BLOOM
492

134-79 FB 25

MAP FILE M81-30