COUNTY SURVEYORS FILE DATA
DO NOT REMOVE FROM OFFICE

MAP FILE M81 -33-

FILED
RECEIVED
DEC 1979
COUNTY SURVEYOR
DOUGLAS

SURVEY OF
SEC. 22 T24S R8W W.M.

SURVEYED FOR: CHAMPION INTERNATIONAL CORP.

SURVEYED BY: T. E. SHRUM, JR. REGISTERED LAND SURVEYOR 1706

DATE: 11/29/79 SCALE: 1" = 500' BEARINGS BASED ON SOLAR OBSERVATION

N

FOUND: ○
SET: ●

REGISTERED
PROFESSIONAL
LAND SURVEYOR
OREGON
OCT. 6, 1978
THOMAS E. SHRUM, JR.
1706

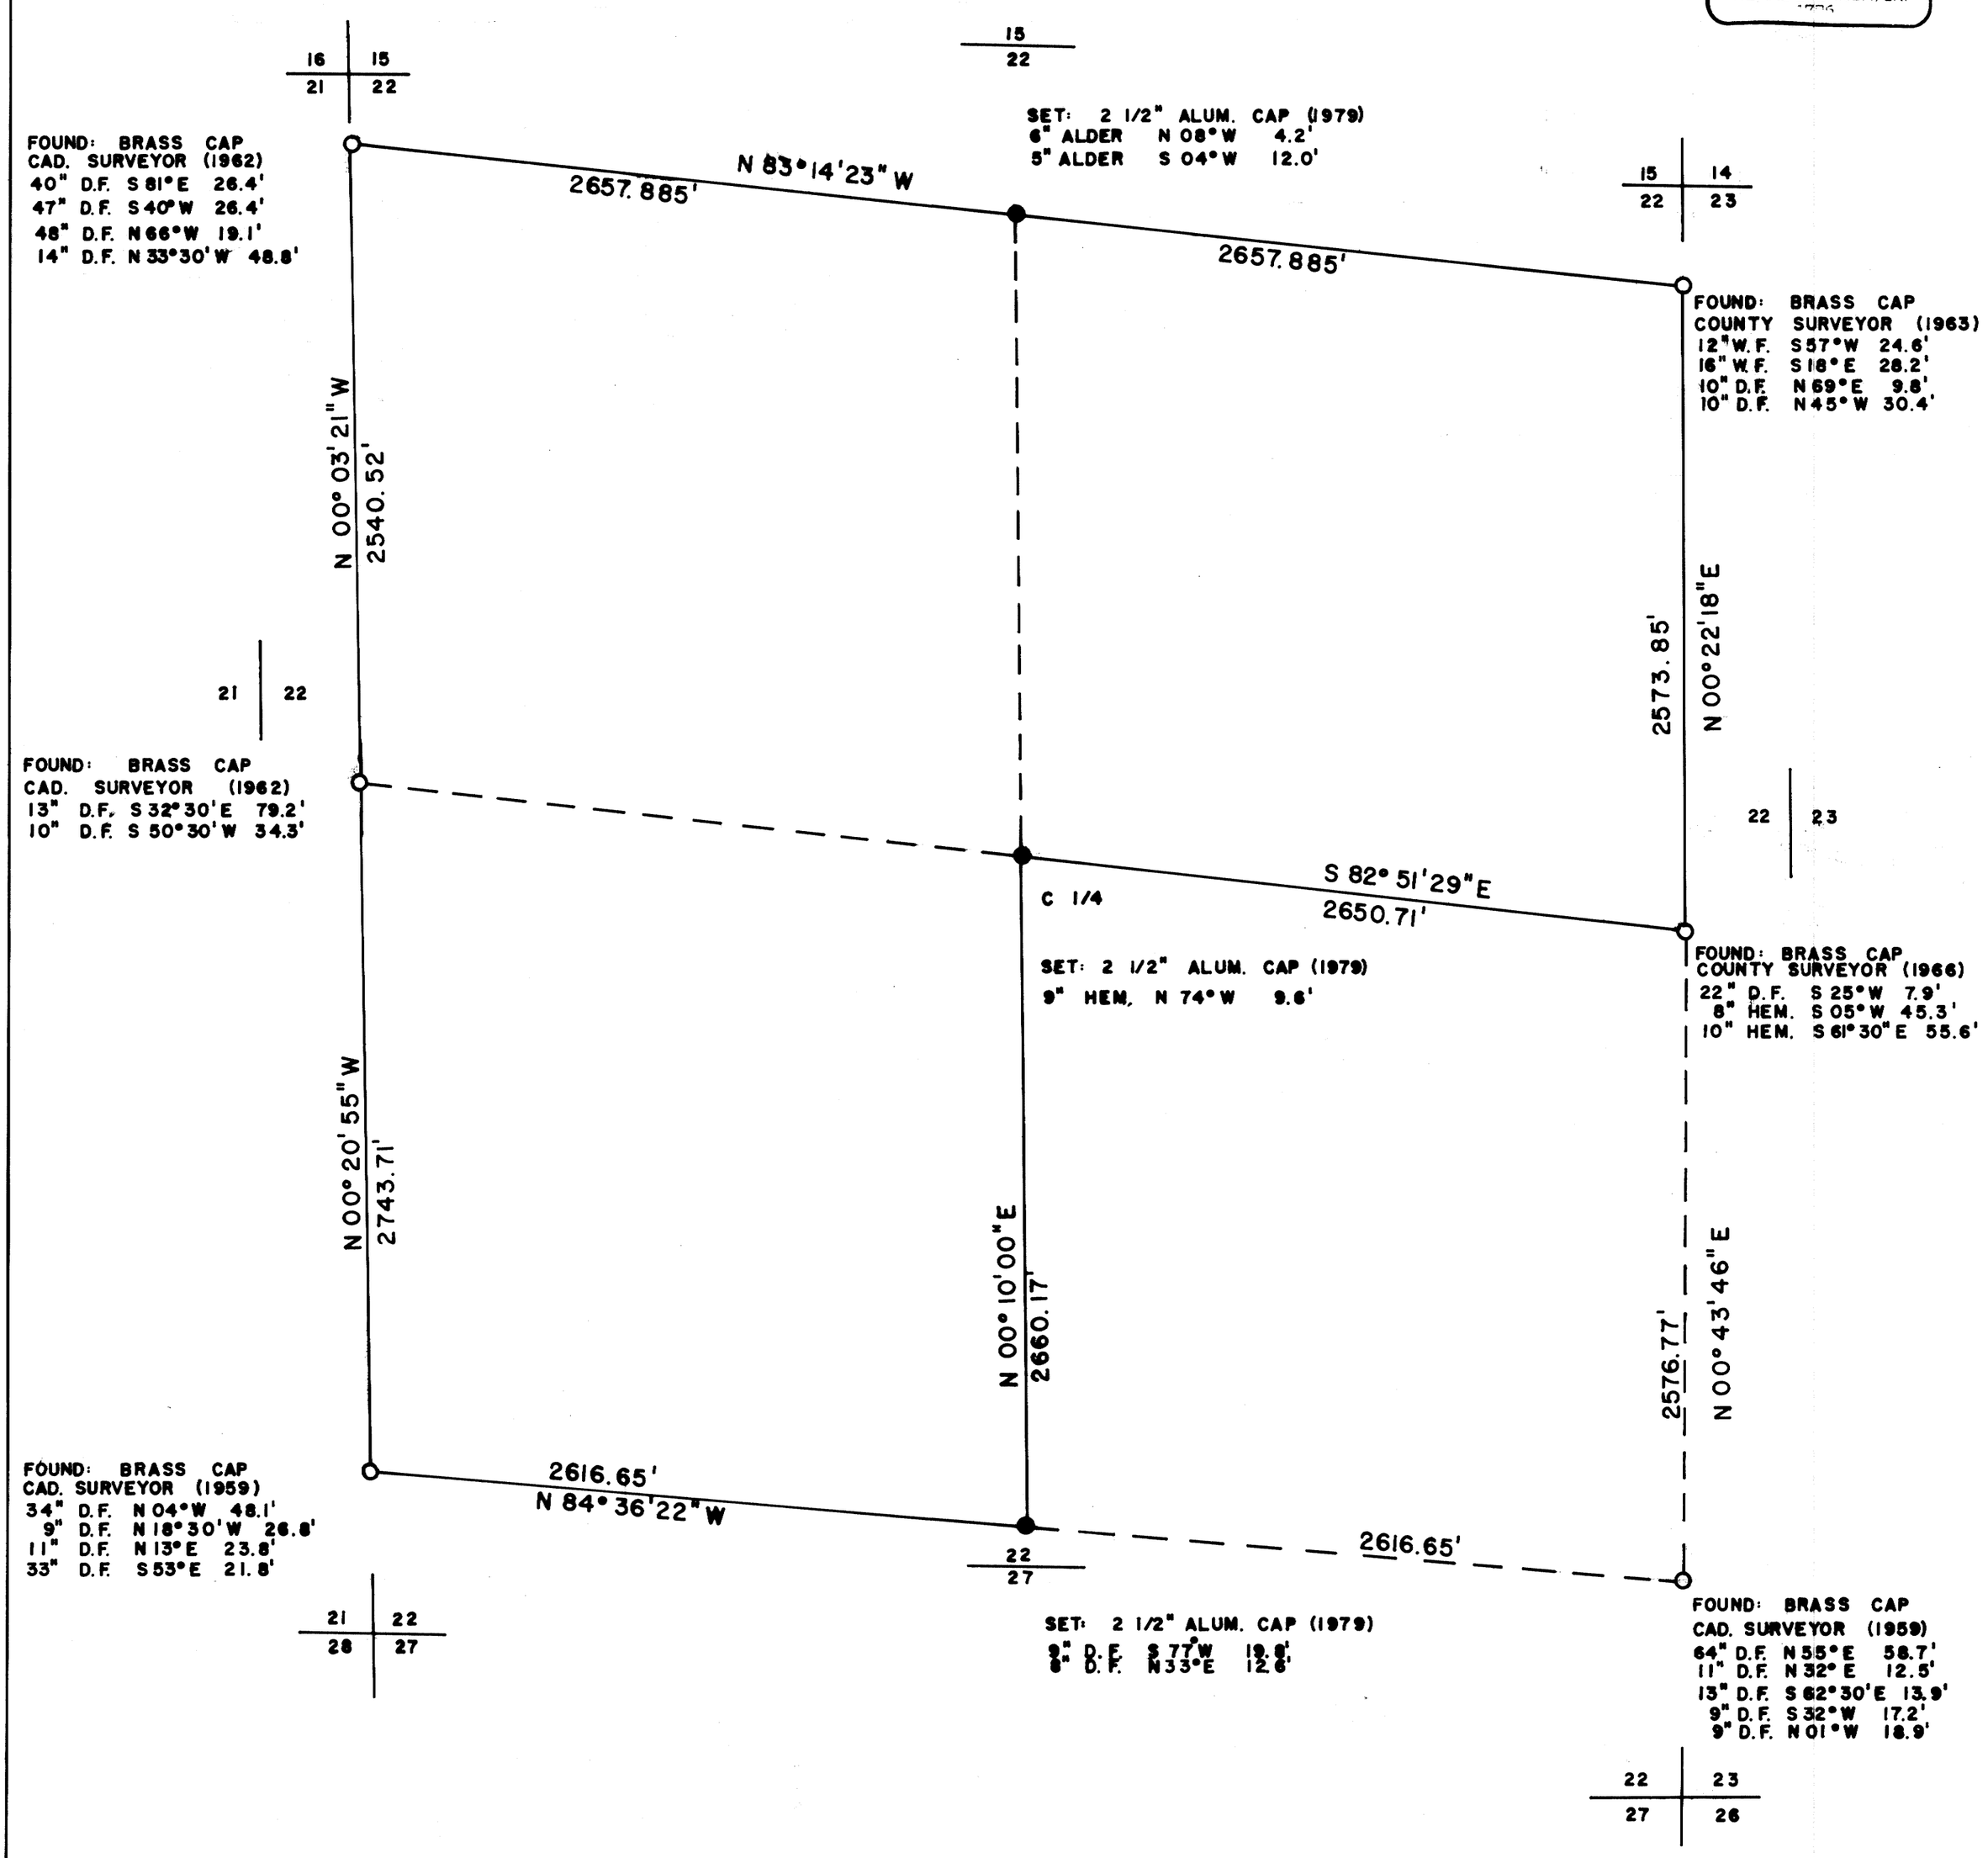

MAP FILE M 81 -33-