MAP FILE M81-38

SURVEY FOR PROPERTY CORNERS

IN LOTS 17 & 18, DE BOLT SECOND HOMESITES - SE 1/4 SEC. 19 T.25S. R.5W.W.M.

FOR: JEFF LATIMER
BY: A A SURVEYING SERVICE INC.
P.O. BOX 454, ROSEBURG, OREGON 97470

DECEMBER 1979 SCALE: 1"=40'

COUNTY SURVEYORS FILE DATA
DO NOT REMOVE FROM OFFICE

FILED
RECEIVED
DEC 7 1979
COUNTY SURVEYOR
DOUGLAS COUNTY, ORE.

NARRATIVE:

Set property corners as shown hereon, from existing corners, on 12/6/79.

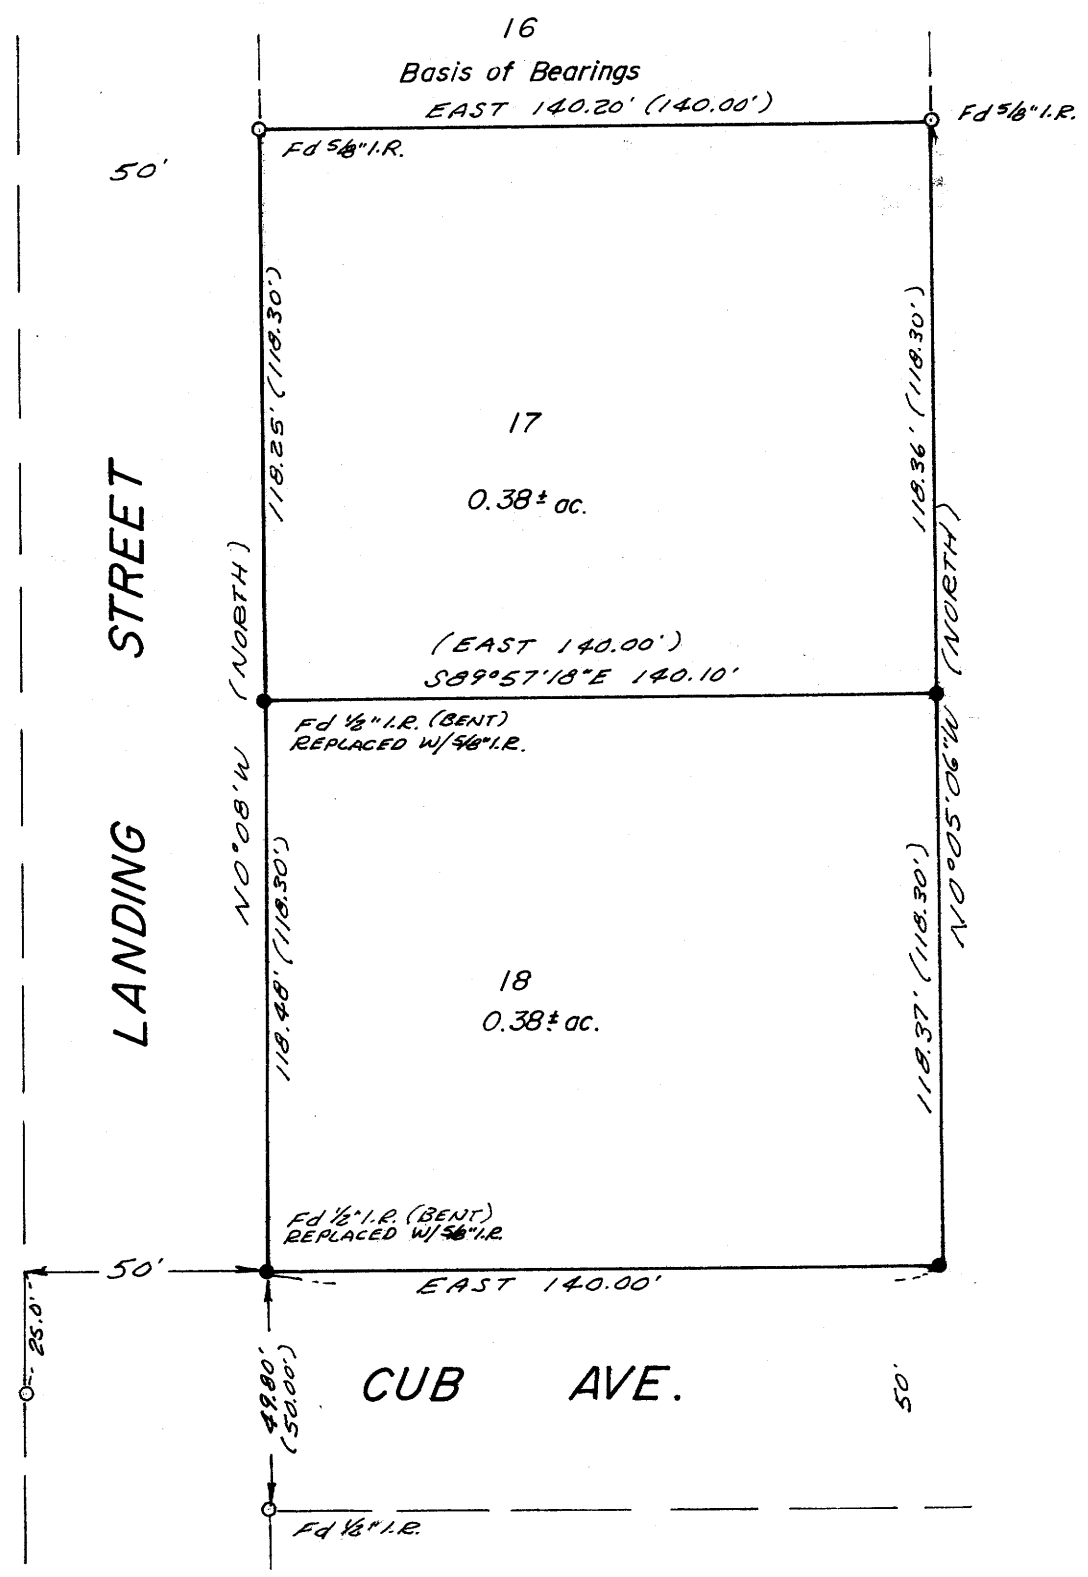

LEGEND

● ——— Set 5/8" iron rod

○ ——— Found point, as noted

REGISTERED
PROFESSIONAL
LAND SURVEYOR

OREGON
MAY 13, 1960
EUGENE A. BLOOM
492

139-79 FB 27

MAP FILE M81-38