COUNTY SURVEYORS FILE DATA
DO NOT REMOVE FROM OFFICE

FILED
RECEIVED
FEB 19 1980
COUNTY SURVEYOR
DOUGLAS COUNTY, ORE.

MAP FILE M 82-22

SURVEY IN LOT 11, VIRGILINE SUBDIVISION, NE 1/4
Section 13, Twp. 27 S., Rng. 6 W., W.M.
Surveyed for Gary Helbling by Landline Dev. Co.
February, 1980 Scale 1' = 50'

o Set 5/8" Iron Rod

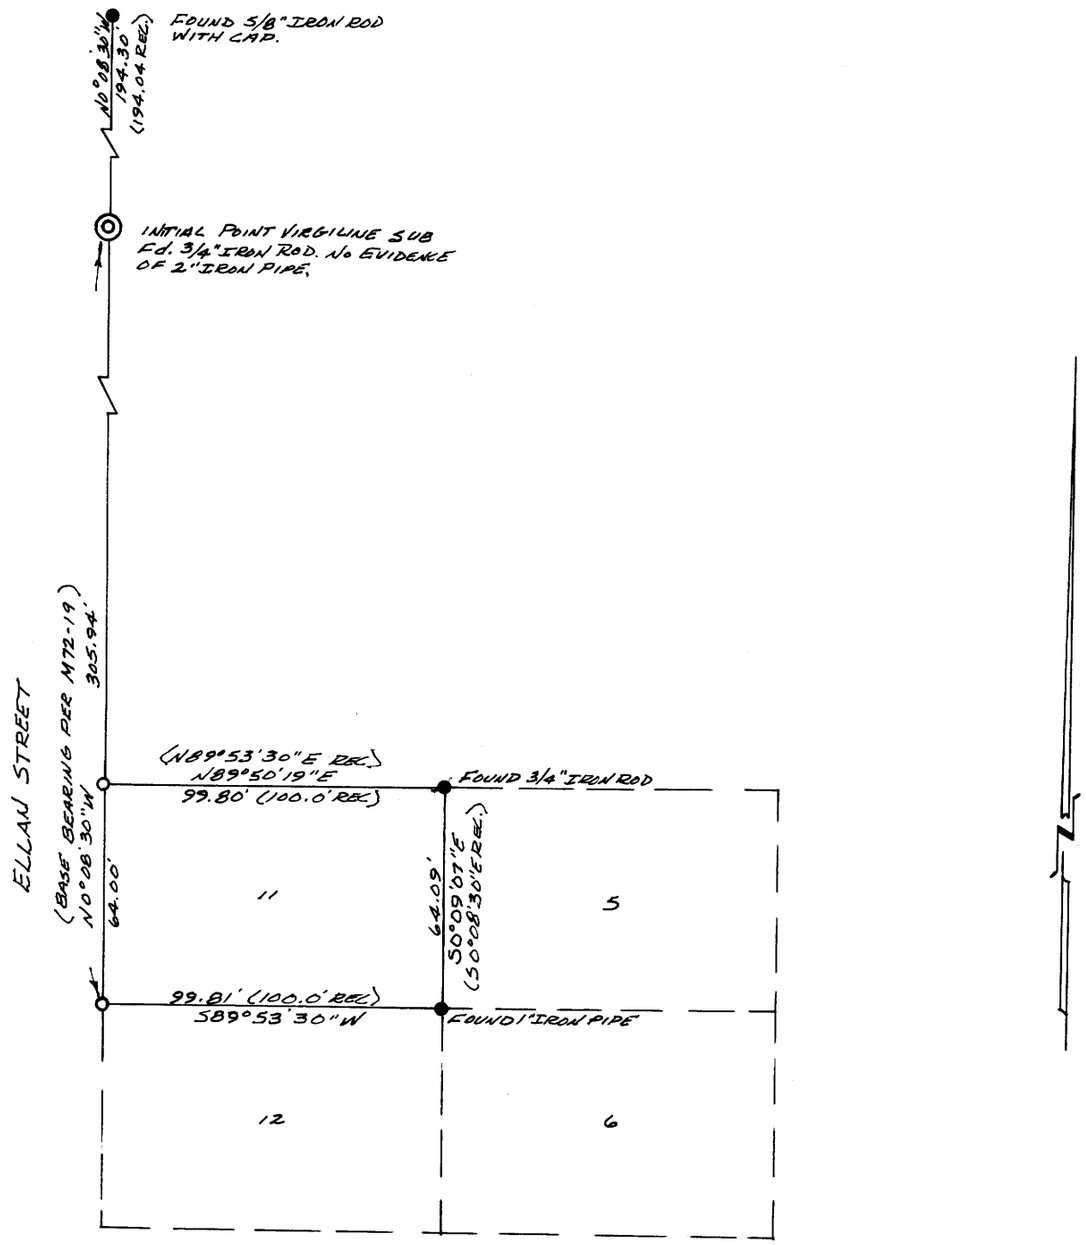

The purpose of this survey was to re-establish the corners of Lot 11, Virgiline Subdivison. All angles were turned with a 20' kern theodolite and all distances were measured with a H-P distance meter and a 300' steel chain. The corners were reset using proportionate measurement.

Surveyed by: Bruce Rogers
2734 Calkins Road
Roseburg, Or. 97470

REGISTERED
OREGON
LAND SURVEYOR

Bruce L. Rogers

JULY 10, 1964
BRUCE R. ROGERS
660

MAP FILE M 82-22