MAP FILE M 82-3

FILED
RECEIVED JHH
JAN 28 1980
COUNTY SURVEYOR
DOUGLAS COUNTY, ORE.

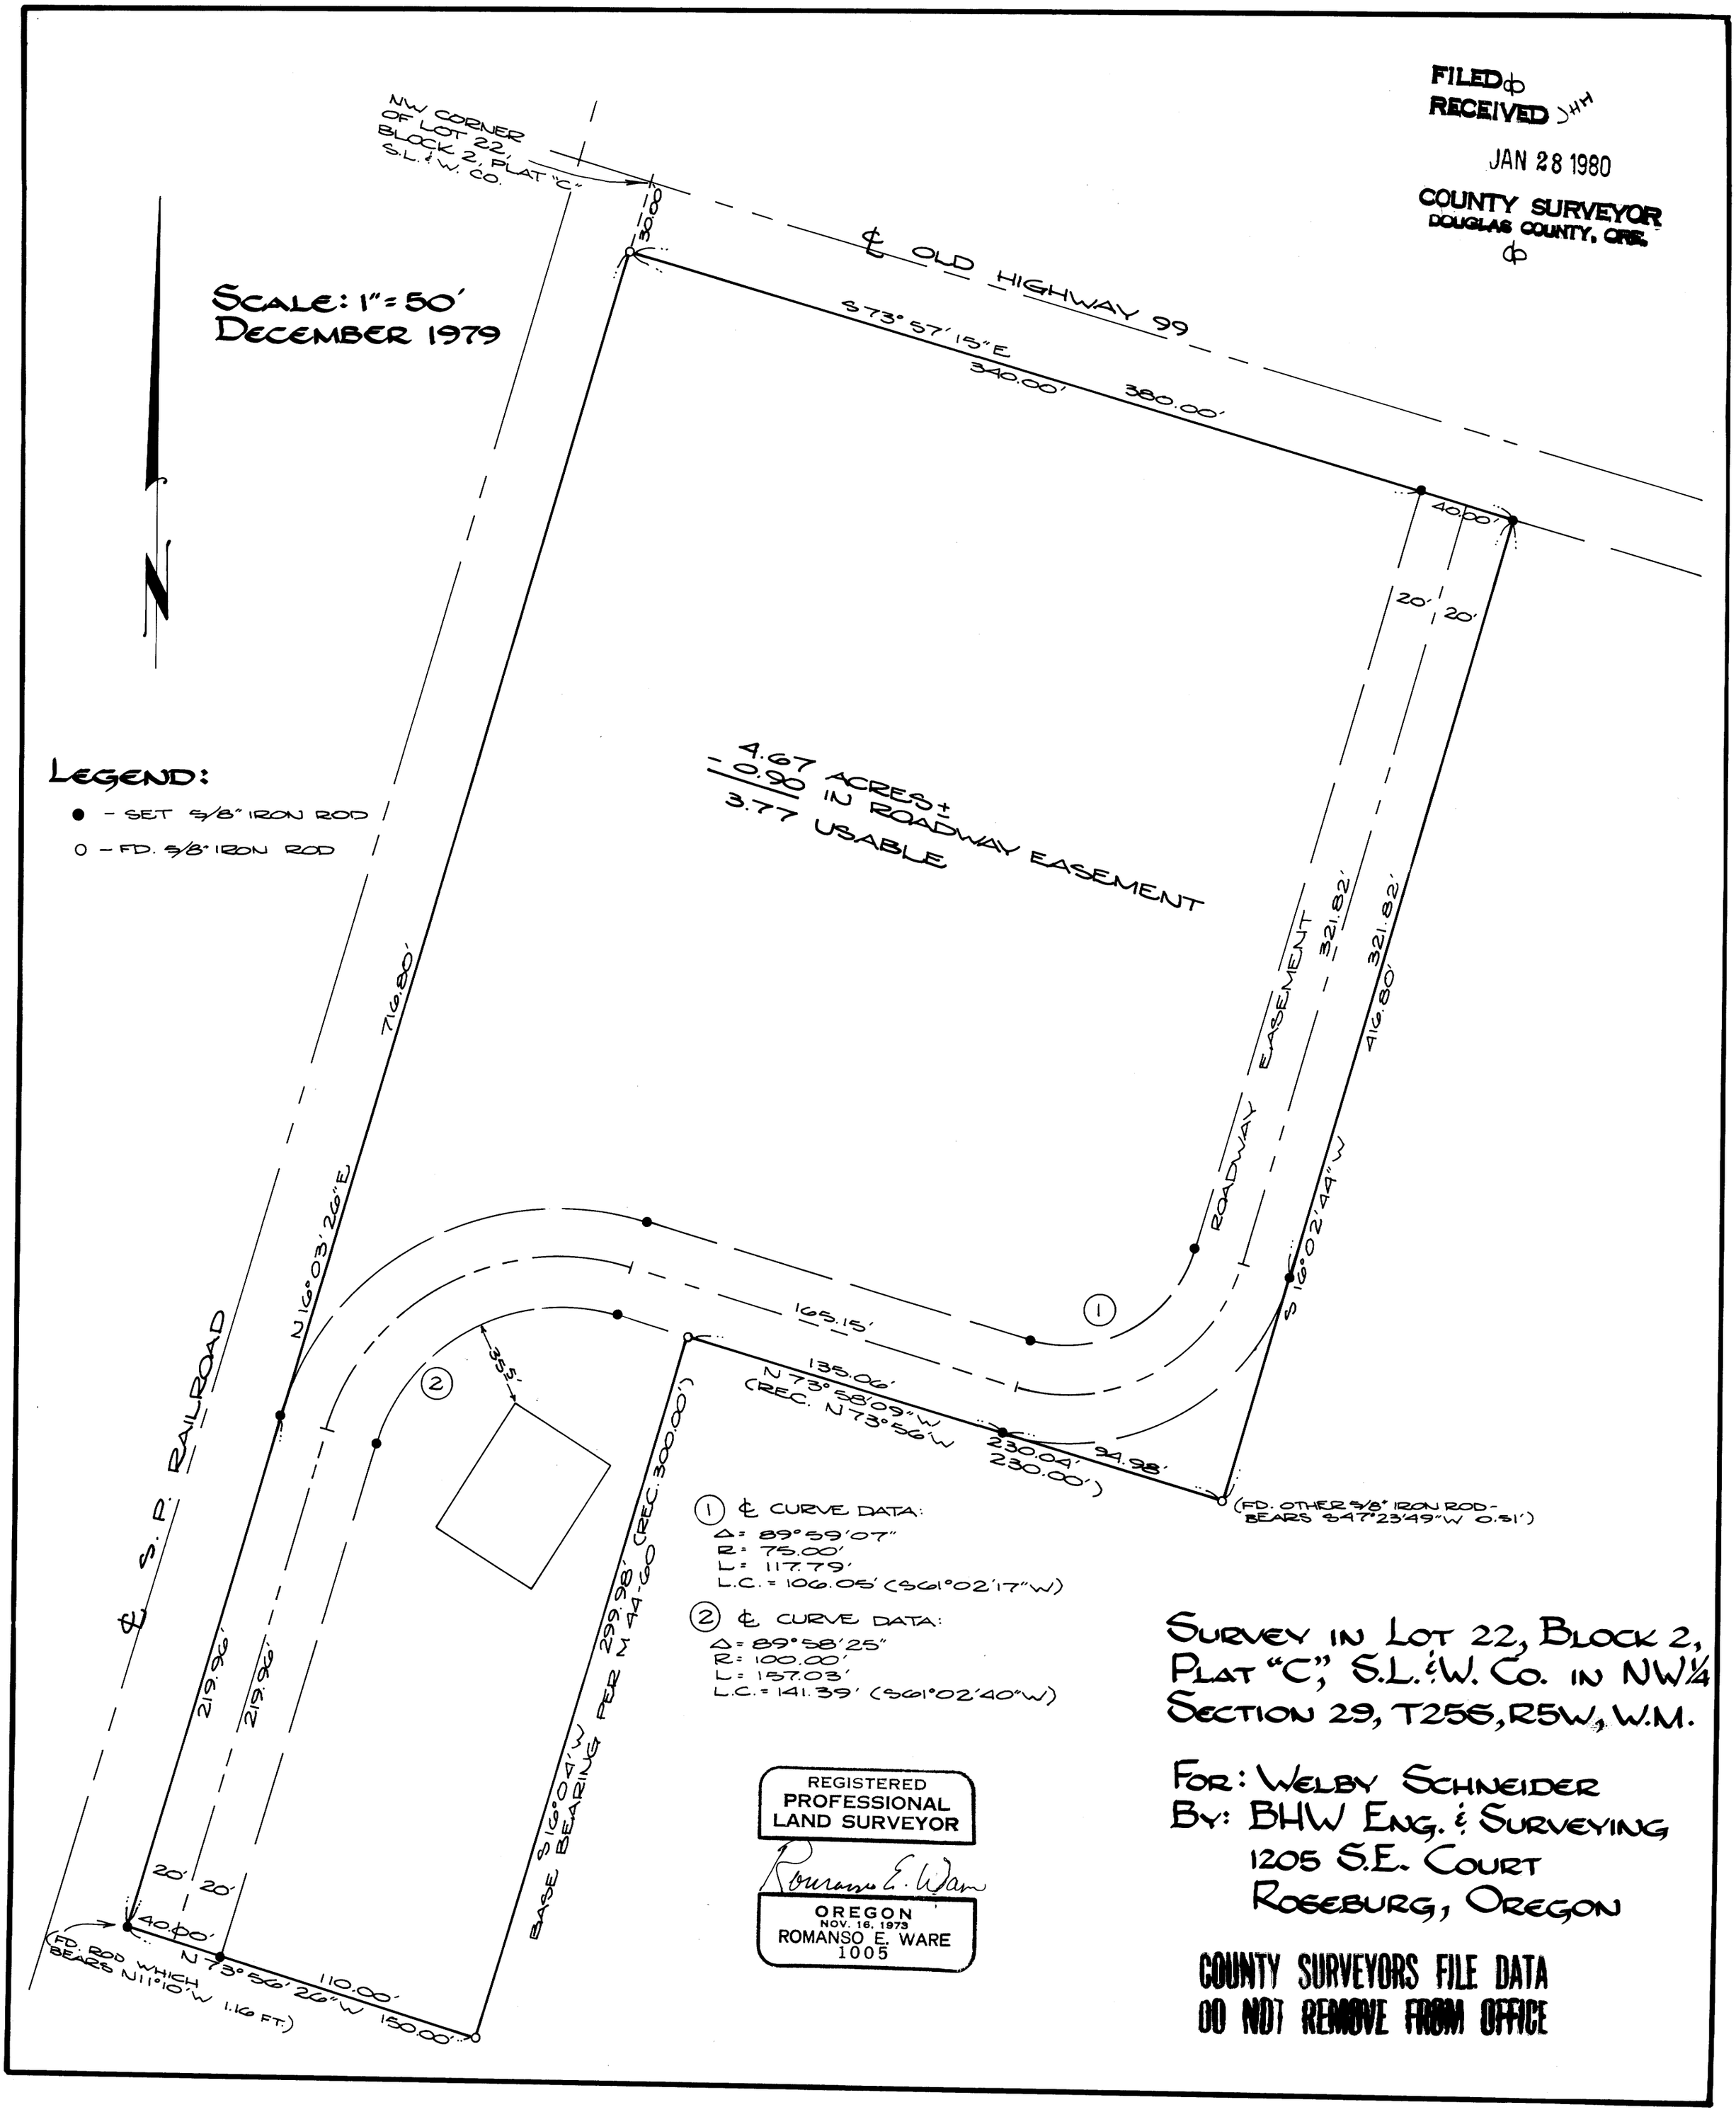

SURVEY IN LOT 22, BLOCK 2, PLAT "C", S.L.&W. CO. IN NW¼ SECTION 29, T25S, R5W, W.M.

FOR: WELBY SCHNEIDER
BY: BHW ENG. & SURVEYING
1205 S.E. COURT
ROSEBURG, OREGON

COUNTY SURVEYORS FILE DATA
DO NOT REMOVE FROM OFFICE

MAP FILE M 82-3