FILED
RECEIVED
MAR 14 1980
COUNTY SURVEYOR
DOUGLAS COUNTY, ORE.

MAP FILE M82-48

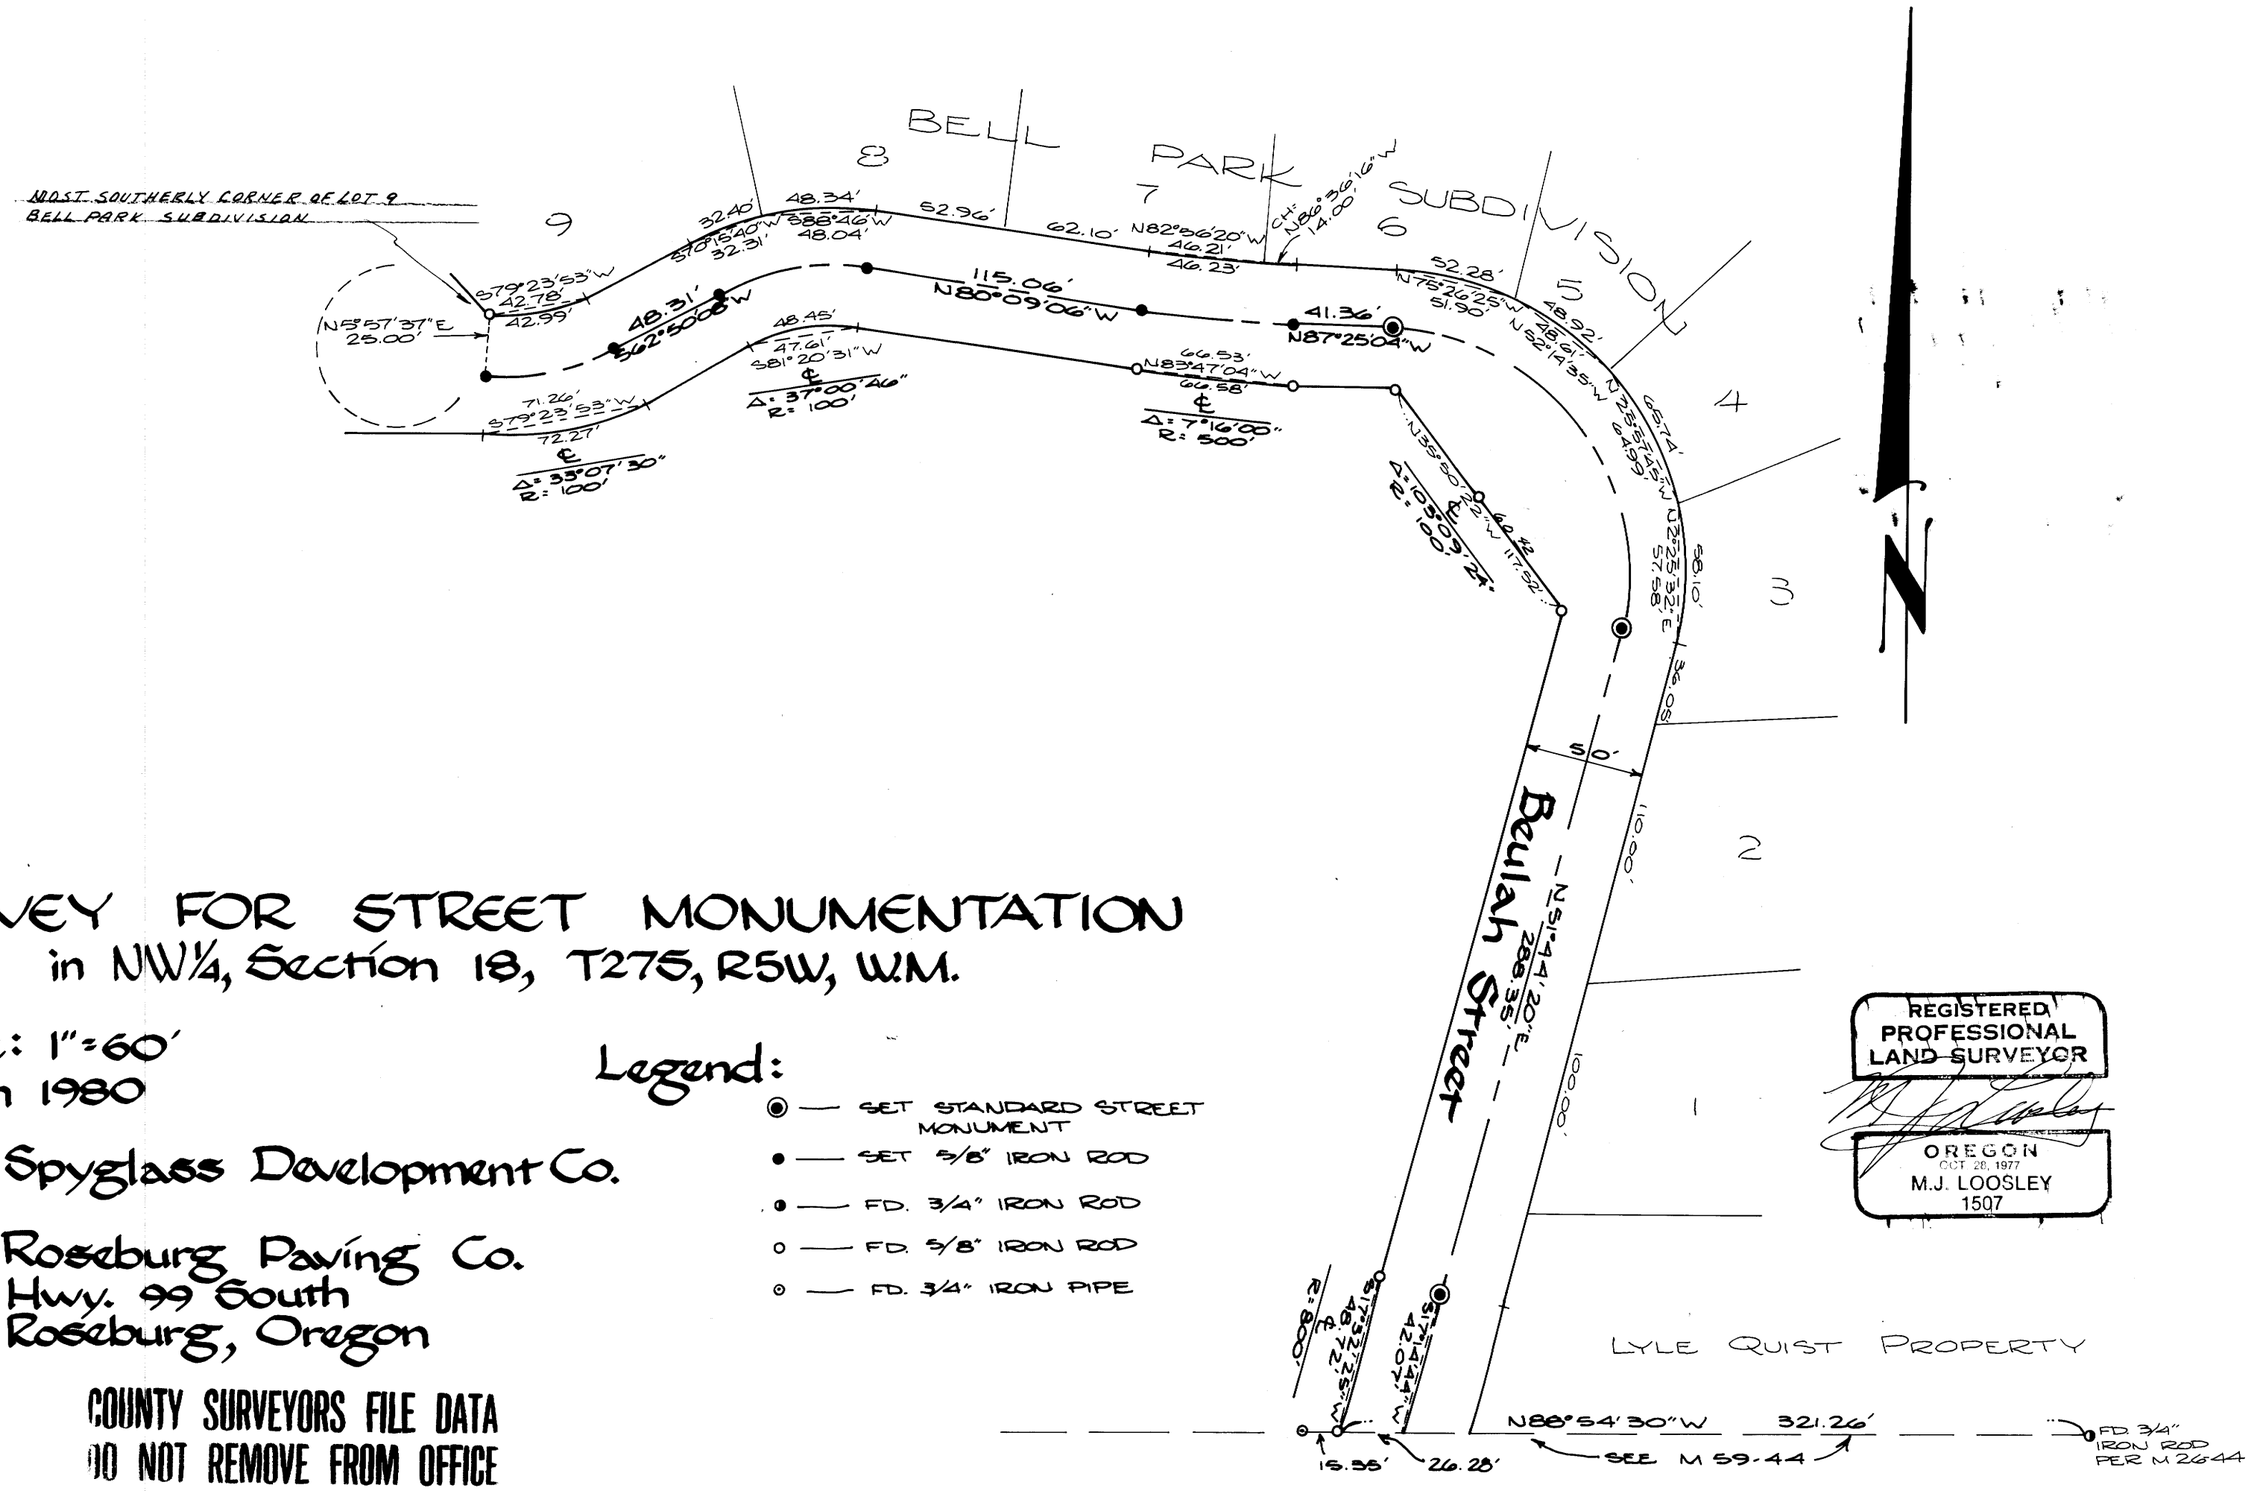

SURVEY FOR STREET MONUMENTATION
in NW¼, Section 18, T27S, R5W, W.M.

Scale: 1" = 60'
March 1980

For: Spyglass Development Co.

By: Roseburg Paving Co.
Hwy. 99 South
Roseburg, Oregon

Legend:

- ◉ — SET STANDARD STREET MONUMENT
- • — SET 5/8" IRON ROD
- ◐ — FD. 3/4" IRON ROD
- ○ — FD. 5/8" IRON ROD
- ⊙ — FD. 3/4" IRON PIPE

REGISTERED PROFESSIONAL LAND SURVEYOR
OREGON
OCT 28, 1977
M.J. LOOSLEY
1507

COUNTY SURVEYORS FILE DATA
DO NOT REMOVE FROM OFFICE

BASE BEARING PER PLAT OF "BELL PARK SUBDIVISION" AS RECORDED IN VOL. 15, PG. 69, DOUGLAS COUNTY SURVEYOR'S OFFICE.

MAP FILE M82-48