COUNTY SURVEYORS FILE DATA
DO NOT REMOVE FROM OFFICE

FILED
RECEIVED JHH

APR 7 1980

COUNTY SURVEYOR
DOUGLAS COUNTY, ORE.

FILE M82-75

SURVEY IN LOT 15 BLOCK 2 "DEVORE'S ADDITION TO YONCALLA" LYING SE 1/4 SECTION 4, T23S, R5W, W.M.

FOR: BILL DUNCAN BY: BHW ENGINEERING & SURVEYING

LEGEND:
- ● SET 5/8" IRON ROD
- o FD. MONUMENT AS NOTED

SCALE: 1" = 50'

MARCH 1980

BASE BEARING PER C.S. 58/147

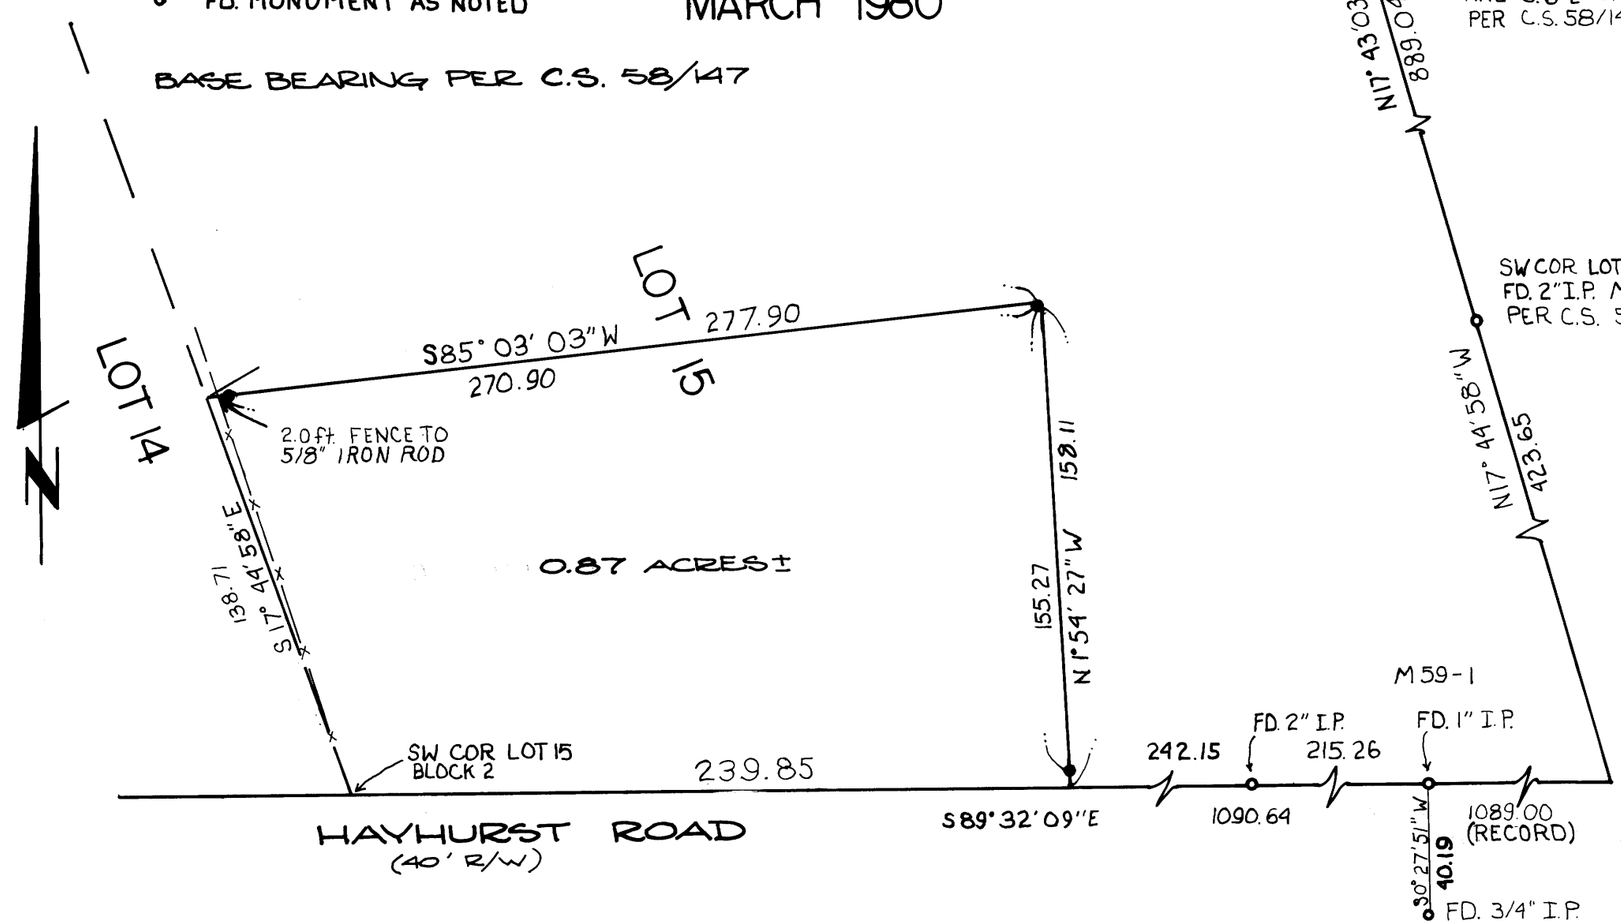

NARRATIVE

EQUIPMENT USED - WILD T-2, EDM.
WEATHER - CLEAR, WARM.
PURPOSE OF SURVEY - TO ESTABLISH EXCLUSION FROM PROPERTY PURCHASED BY BILL AND BOB DUNCAN. PARCEL CONTAINS RESIDENCE OF OWNER.

REGISTERED PROFESSIONAL LAND SURVEYOR

OREGON
JULY 12, 1975
DONALD A. BENTZ
839

BHW ENGINEERING & SURVEYING, INC.
1205 S.E. Court St.
Roseburg, Oregon 97470

FILE M82-75