SURVEY IN S½, SECTION 15, T30S, R9W, W.M.

For: Roseburg Lumber

COUNTY SURVEYORS FILE DATA
DO NOT REMOVE FROM OFFICE

By: BHW Engineering & Surveying, Inc.

Scale: 1" = 400'

April 1980

FILED DP
RECEIVED ϕ
APR 11 1980
COUNTY SURVEYOR
DOUGLAS COUNTY, ORE.
KS

MAP FILE M 82 - 72

REGISTERED
PROFESSIONAL
LAND SURVEYOR
OREGON
JULY 12, 1958
DONALD A. BENTZ
839

BHW ENGINEERING & SURVEYING, INC.
1205 S.E. Court St.
Roseburg, Oregon 97470

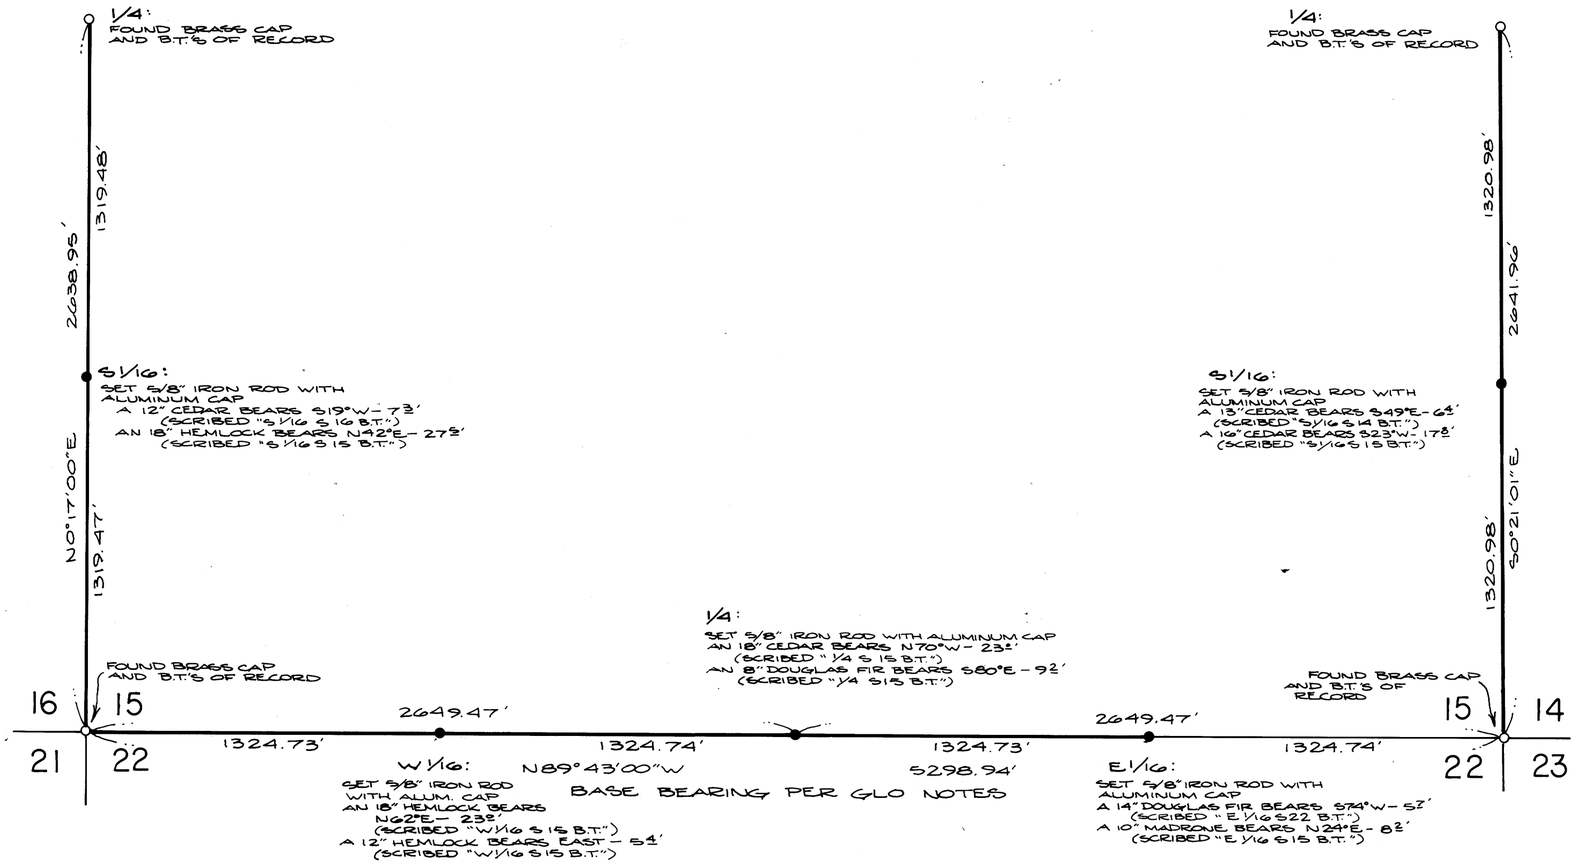

LEGEND:

- o — FOUND BRASS CAP AS NOTED
- ● — SET 5/8" IRON ROD WITH ALUMINUM CAP
- ▬ — LINES DESIGNATED IN THE FIELD BY RED RIBBON, TREES BLAZED AND PAINTED (YELLOW).

NARRATIVE:
MEASURING ACCOMPLISHED BY A COMBINATION OF CHAINING/THEODOLITE AND EDM/THEODOLITE.

MAP FILE M 82 - 72