MAP FILE M83-26

COUNTY SURVEYORS FILE DATA
DO NOT REMOVE FROM OFFICE

FILED
RECEIVED
APR 30 1980
COUNTY SURVEYOR
DOUGLAS COUNTY, ORE.

Resurvey & Subdivision of Section 2, T32S, R8W, W.M.

Roseburg Lumber Company Scale: 1" = 400' April 16, 1980

Legend

- ○ Monument Found
- ● Monument Set
- —— Section or Property Line
- Line Blazed
- Line Marked With BLM Tags

Bearing based on 1975 Cadastral resurvey of the line between Sec. 3 & Sec. 2

I ran a closed traverse around the exterior and through the interior of Section 2 with a Jena 1 second theodolite and a Mac IE EDM. I achieved a precision of 1:14041 on the exterior and 1:15446 on the interior and adjusted by the Crandall method. I set the corners by standard subdivision procedure based on the location of the existing corner monuments.

Howard W. Johnstone PO Box 1088 Roseburg, Oregon

REGISTERED PROFESSIONAL LAND SURVEYOR
Howard W Johnstone
OREGON
MAY 13, 1960
HOWARD W. JOHNSTONE
498

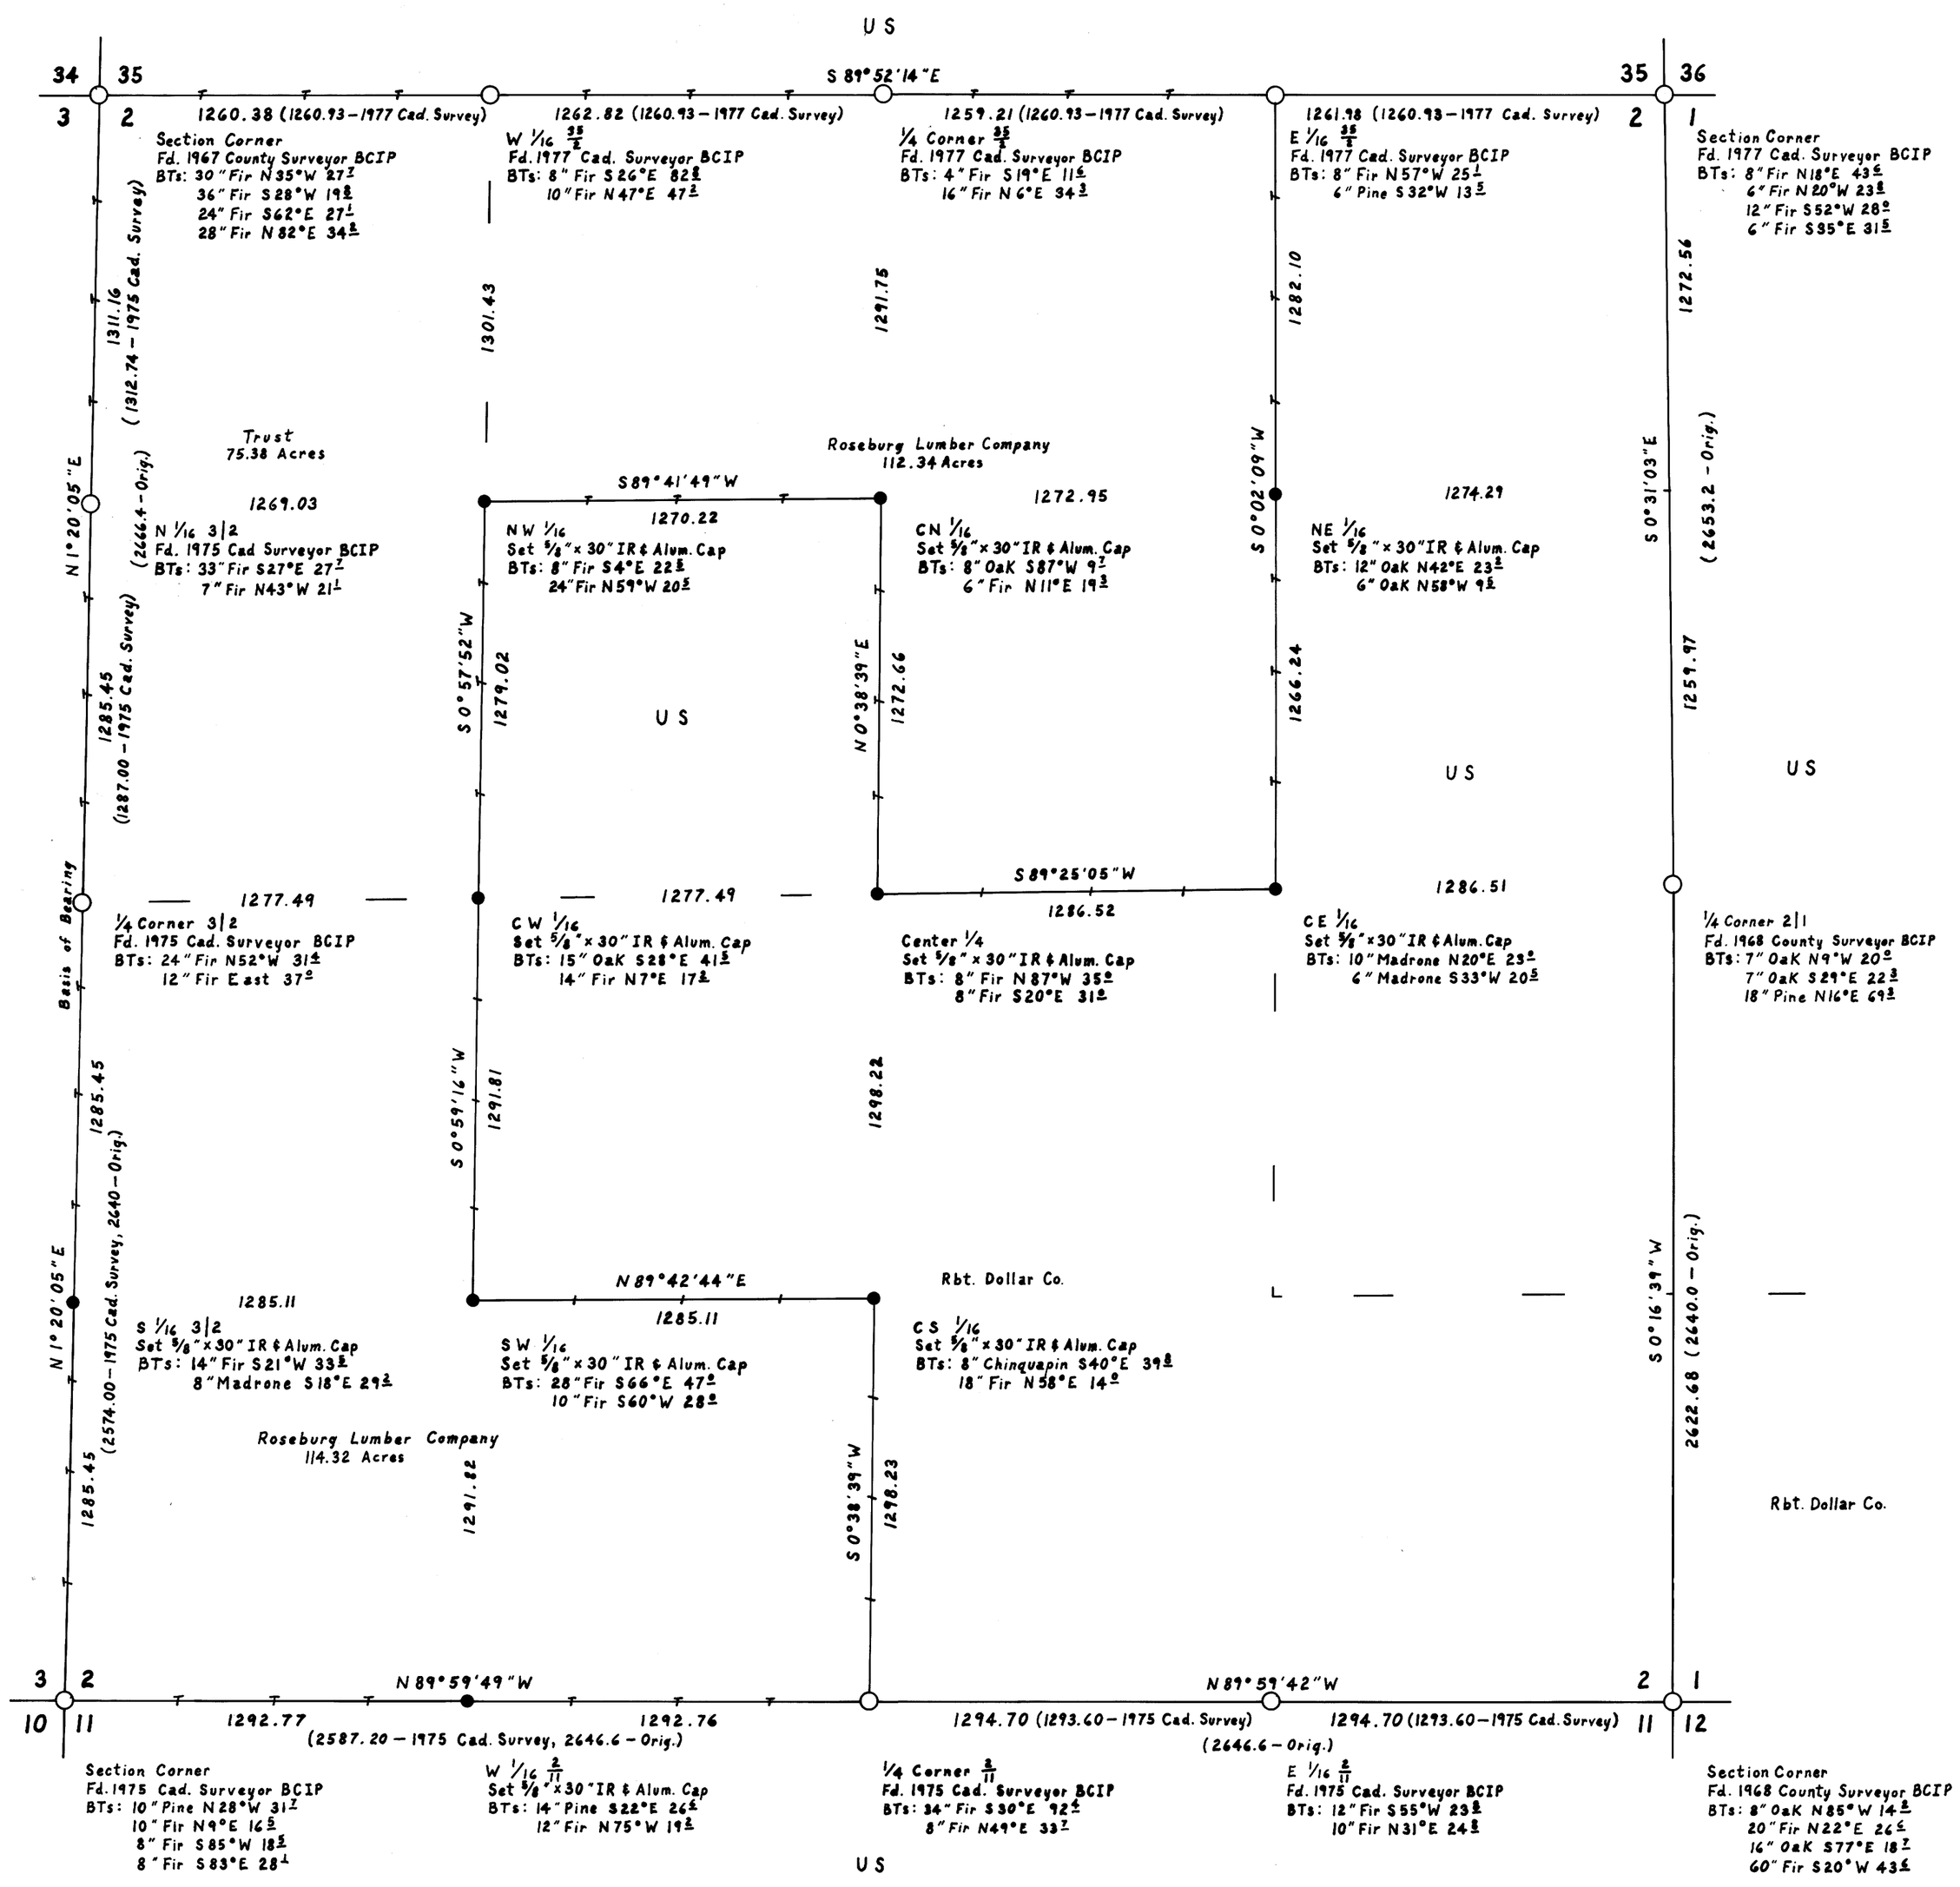

MAP FILE M83-26