MAP FILE M83-28

SURVEY LOCATED IN SW 1/4 SECTION 15 T22S R9W WM DOUGLAS COUNTY ORE

FILED
RECEIVED
MAY 1 1980
COUNTY SURVEYOR
DOUGLAS COUNTY, ORE.

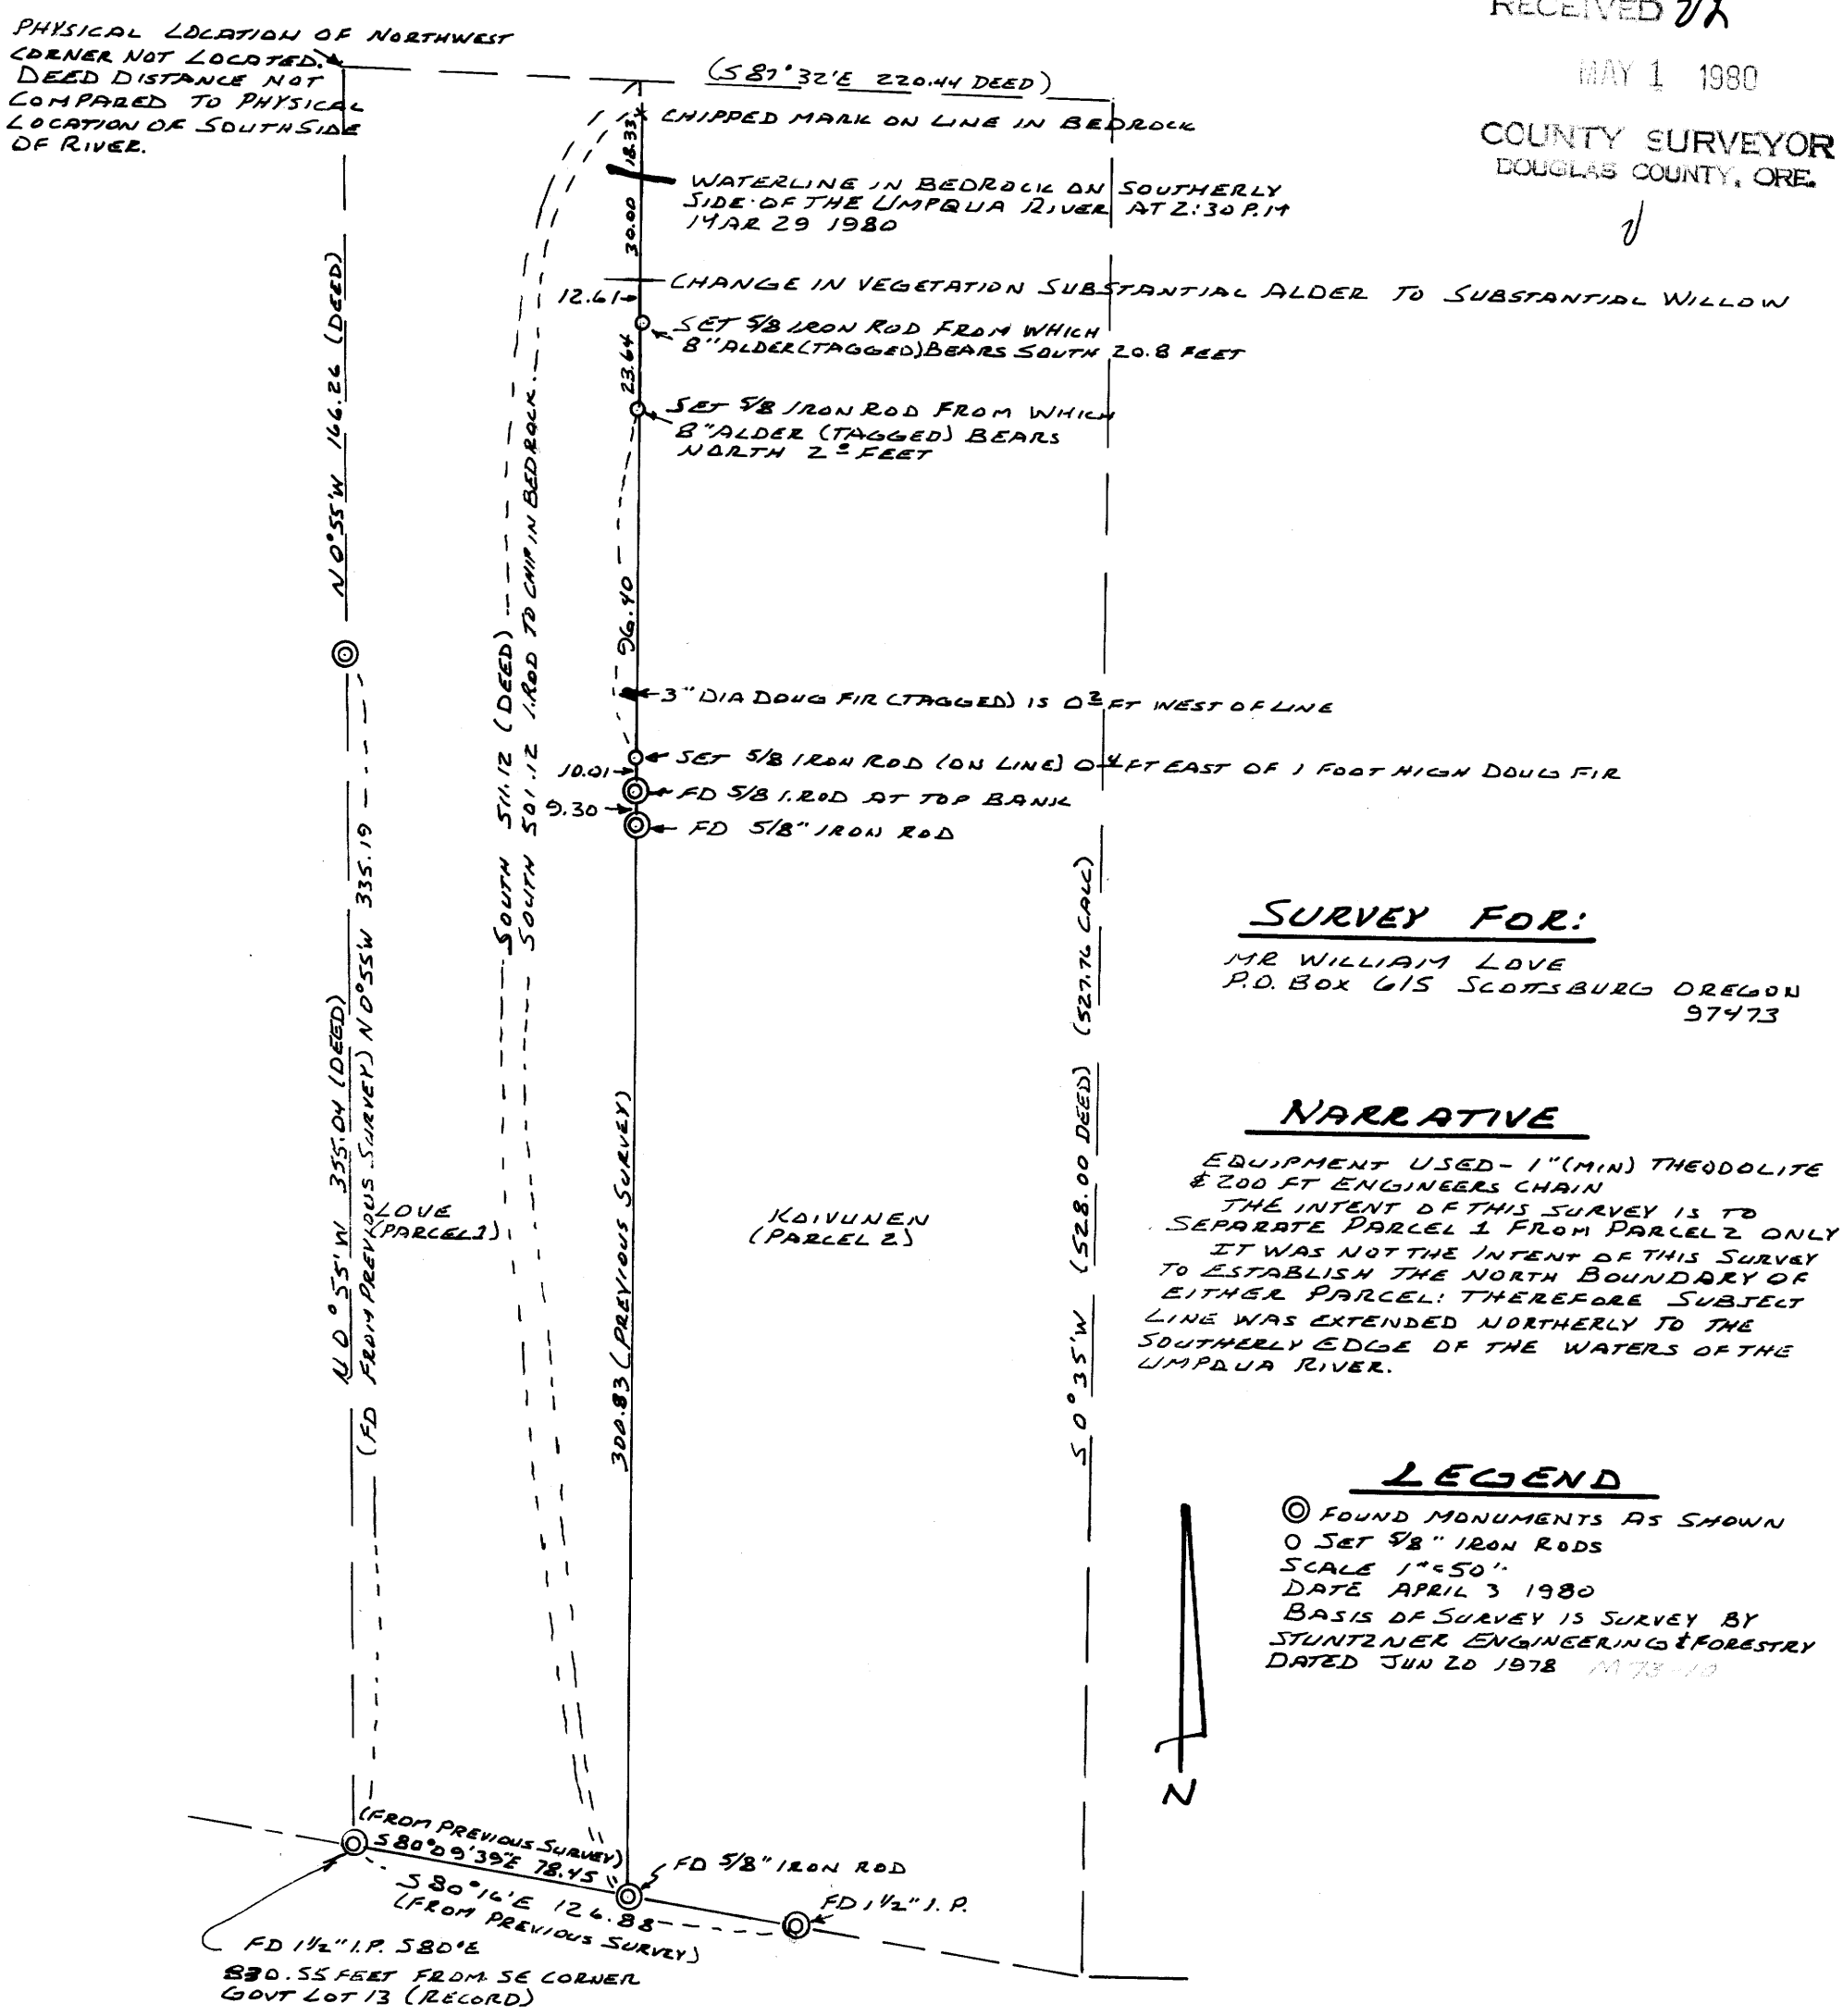

SURVEY FOR:

MR WILLIAM LOVE
P.O. BOX 615 SCOTTSBURG OREGON 97473

NARRATIVE

EQUIPMENT USED - 1" (MIN) THEODOLITE & 200 FT ENGINEERS CHAIN

THE INTENT OF THIS SURVEY IS TO SEPARATE PARCEL 1 FROM PARCEL 2 ONLY

IT WAS NOT THE INTENT OF THIS SURVEY TO ESTABLISH THE NORTH BOUNDARY OF EITHER PARCEL: THEREFORE SUBJECT LINE WAS EXTENDED NORTHERLY TO THE SOUTHERLY EDGE OF THE WATERS OF THE UMPQUA RIVER.

LEGEND

◎ FOUND MONUMENTS AS SHOWN
O SET 5/8" IRON RODS
SCALE 1" = 50'
DATE APRIL 3 1980
BASIS OF SURVEY IS SURVEY BY STUNTZNER ENGINEERING & FORESTRY DATED JUN 20 1978 M78-40

NOTE PARCELS 1 & 2 ARE PARCELS PARTITIONED FROM THAT LAND DESCRIBED IN VOL 425 PAGE 124 DEED RECORDS DOUGLAS COUNTY OREGON

SURVEY BY:

STUNTZNER ENGINEERING & FORESTRY
375 PARK . . . P.O. BOX 98 . . . COOS BAY OREGON 97420
PHONE (503) 267-2872

REGISTERED PROFESSIONAL LAND SURVEYOR
Ronald E. Stuntz
OREGON
SEPTEMBER 23, 1977
RONALD E. STUNTZNER
1342

COUNTY SURVEYORS FILE DATA
DO NOT REMOVE FROM OFFICE

MAP FILE M83-28