COUNTY SURVEYORS FILE DATA
DO NOT REMOVE FROM OFFICE

FILED
RECEIVED
MAY 9 1980
COUNTY SURVEYOR
DOUGLAS COUNTY, OREG.

MAP FILE M82-34

FD. G.L.O. BRASS CAP, 1931
(CAP BURIED 24" IN GROUND)
12" W. OAK , N 4° W , 238.9' , 1931 B.T.
24" W. OAK , S 52 1/4° E , 909.6' , 1931 B.T.
21" W. OAK STUMP , N 35° W , 216.7' , 1963 B.T.

FD. G.L.O. BRASS CAP, 1931
26" FIR , N 56° W , 28.4' , ORIG. B.T.
38" FIR , S 9° E , 4.6' , ORIG. B.T.
14" FIR , N 83° E , 21.8' , 1931 B.T.
15" FIR , S 8 1/4° W , 15.2' , 1931 B.T.
60" FIR , S 19° E , 50.2' , 1931 B.T.

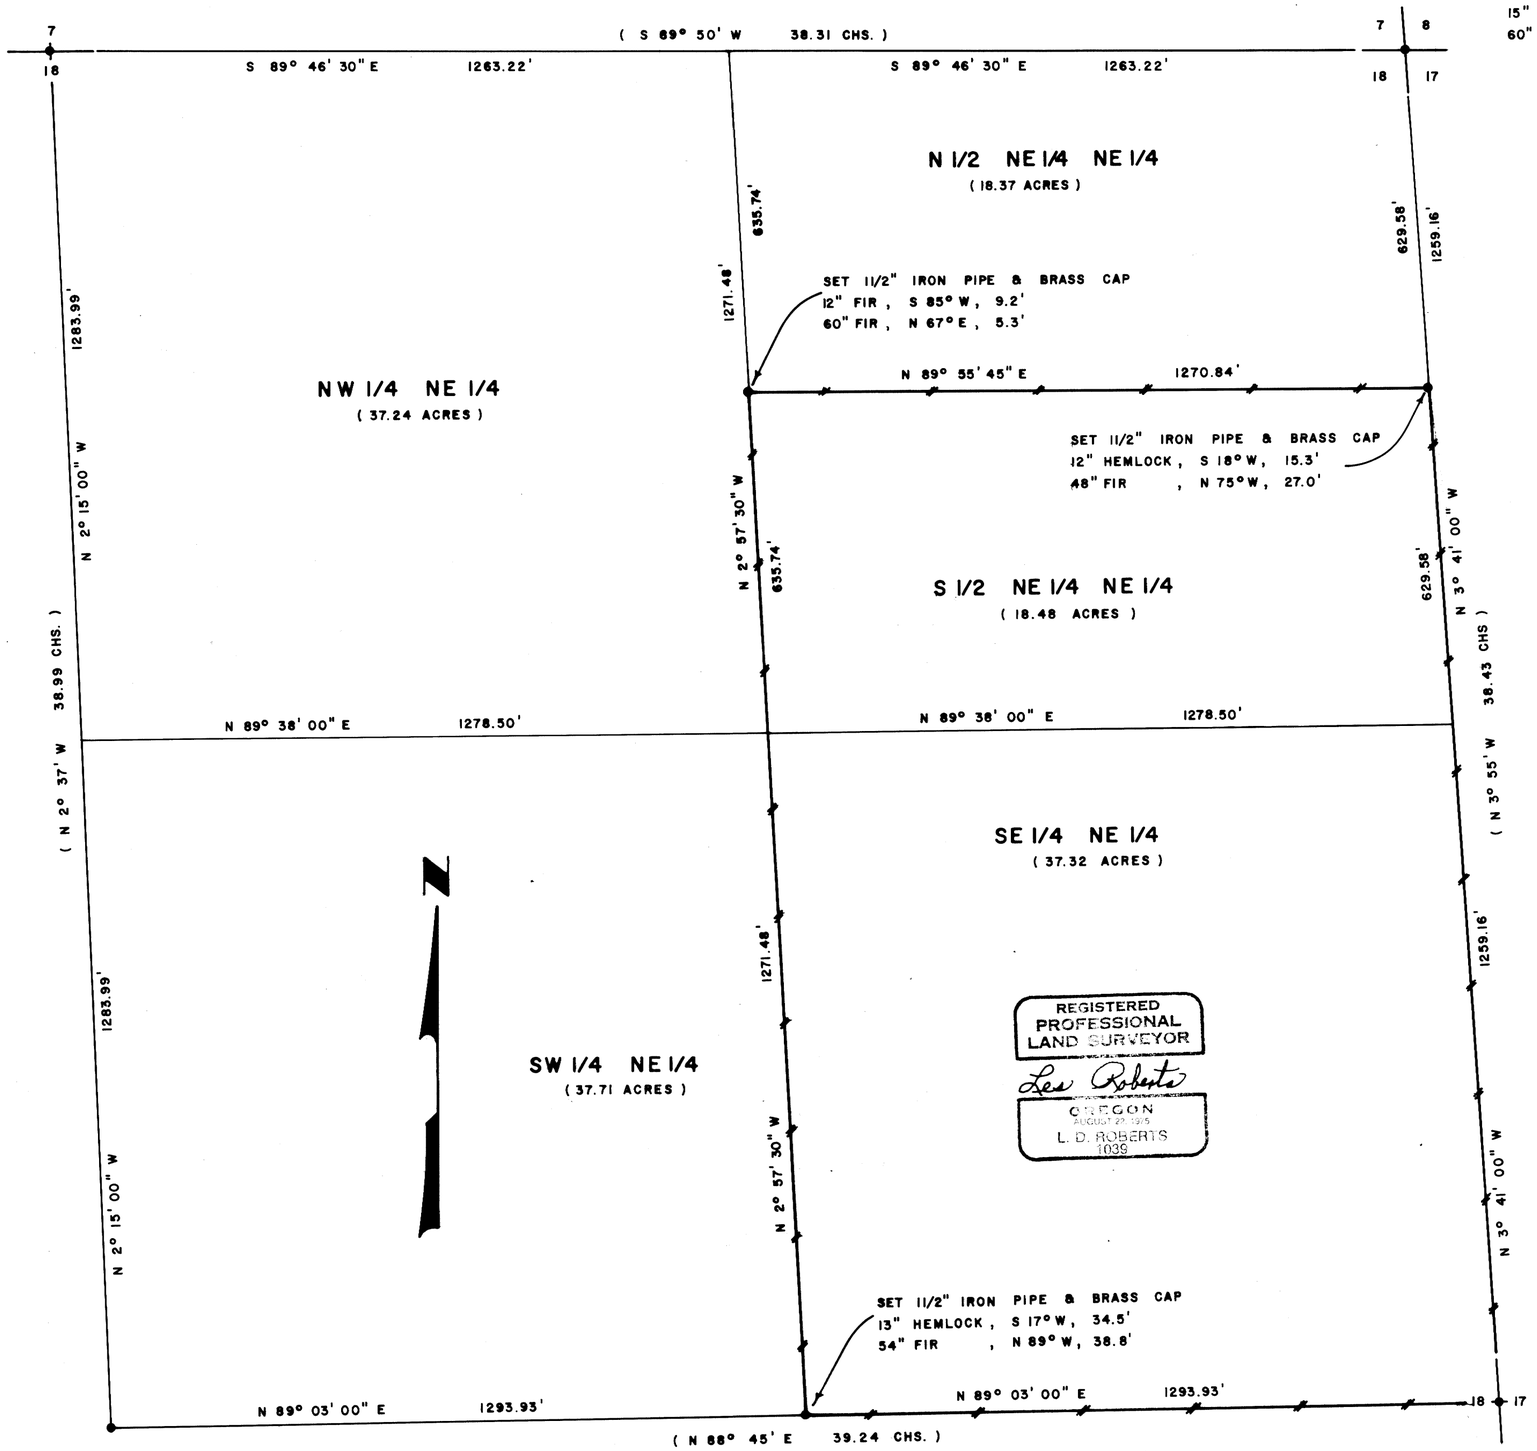

I, LESLIE D. ROBERTS, REGISTERED PROFESSIONAL LAND SURVEYOR DO CERTIFY THAT I HAVE CORRECTLY SURVEYED SAID SECTION 18 IN ACCORDANCE TO THE MANUAL OF INSTRUCTIONS FOR THE SURVEY OF THE PUBLIC LANDS OF THE UNITED STATES. THE C-E 1/16 CORNER WAS SET HALF-WAY BETWEEN THE CENTER 1/4 CORNER AND THE EAST 1/4 CORNER. THE N-N 1/64 CORNER WAS SET HALF-WAY BETWEEN THE NORTH 1/16 CORNER AND THE N.E. SECTION CORNER. THE C-N N.E. 1/64 CORNER WAS SET HALF-WAY BETWEEN THE N.E. 1/16 CORNER AND THE EAST 1/16 CORNER. CLOSED TRANSIT TRAVERSES, WITH A MINIMUM ERROR OF CLOSURE OF 1'/5000', WERE RAN FOR CONTROL. OFFSETS TO THE TRUE LINE WERE CALCULATED AND USED TO MARK THE TRUE PROPERTY LINE.

SURVEY OF
SECTION 18, T22S, R8W, W.M.
DOUGLAS COUNTY, OREGON
FOR
INTERNATIONAL PAPER COMPANY
BY
TRIANGLE ENGINEERING COMPANY
1262 LAWRENCE STREET
EUGENE, OREGON 97401
MARCH 1980

LEGEND

- ● CORNERS FOUND AND USED FOR CONTROL
- ○ CORNERS SET
- LINES MARKED WITH 1/2" x 60" IRON RODS AND INTERNATIONAL PAPER COMPANY PROPERTY SIGNS

SCALE 1" = 200'

BASIS OF BEARING, SOLAR OBSERVATION

DISTANCE TO BEARING TREES ARE CENTER MEASURE

ALL BEARING TREES ARE SCRIBED

DATA OF RECORD ( )

CENTER 1/4 CORNER
FD. B.L.M. BRASS CAP, 1963
40" FIR STUMP , S 66° W , 16.5' , 1931 B.T.
12" FIR , S 16 1/2° E , 59.4 , 1963 B.T.
20" FIR , N 34° W , 97.0 , 1963 B.T.

FD. G.L.O. BRASS CAP, 1931
34" FIR STUMP , N 48 1/4° E , 11.9' , 1931 B.T.
22" FIR STUMP , S 56° W , 21.1' , 1931 B.T.
14" W. FIR , N 15° E , 136.6' , 1963 B.T.
12" W. FIR , S 40° W , 120.8' , 1963 B.T.

MAP FILE M82-34