COUNTY SURVEYORS FILE DATA
DO NOT REMOVE FROM OFFICE

FILED
RECEIVED
MAY 15 1980
COUNTY SURVEYOR
DOUGLAS COUNTY, ORE.
DP

MAP FILE M83-43

SURVEY IN THE N 1/2 OF SEC. 26, TWP. 27 S., RNG. 5 W., W.M.
Surveyed for Darrell Sanders by Landline Development Co.
April, 1980 Scale 1" = 200'

o Set 5/8" Iron Rod
● Found 5/8" Iron Rod

Landline Development Co.
P.O. Box 2191
Roseburg, Or. 672-5840

REGISTERED
OREGON
LAND SURVEYOR
Bruce R. Rogers
JULY 10, 1964
BRUCE R. ROGERS
660

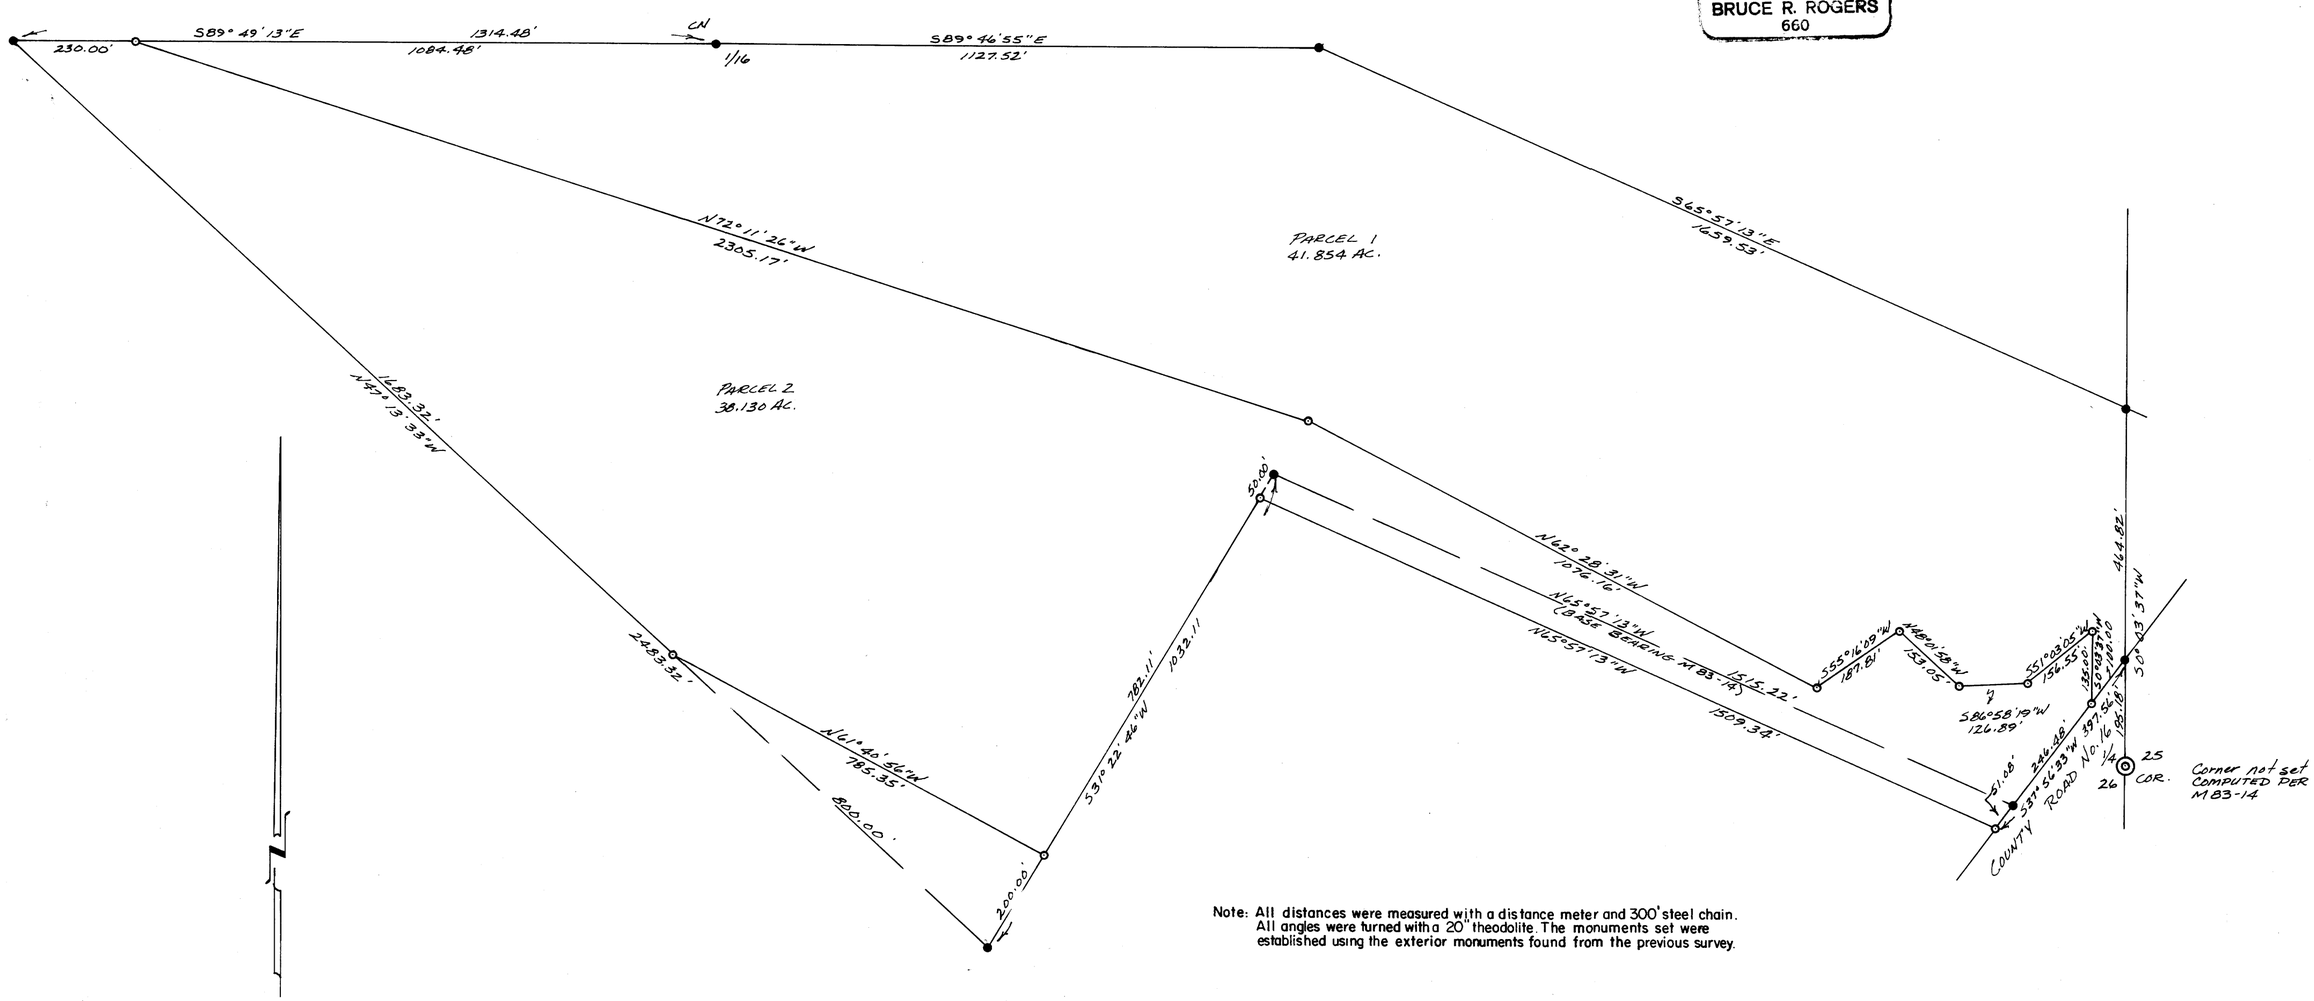

Note: All distances were measured with a distance meter and 300' steel chain. All angles were turned with a 20" theodolite. The monuments set were established using the exterior monuments found from the previous survey.

MAP FILE M83-43