MAP FILE M83-50
H-221

COUNTY SURVEYORS FILE COPY
DO NOT REMOVE FROM OFFICE

FILED
RECEIVED
MAY 8 1980
COUNTY SURVEYOR
DOUGLAS COUNTY, ORE.

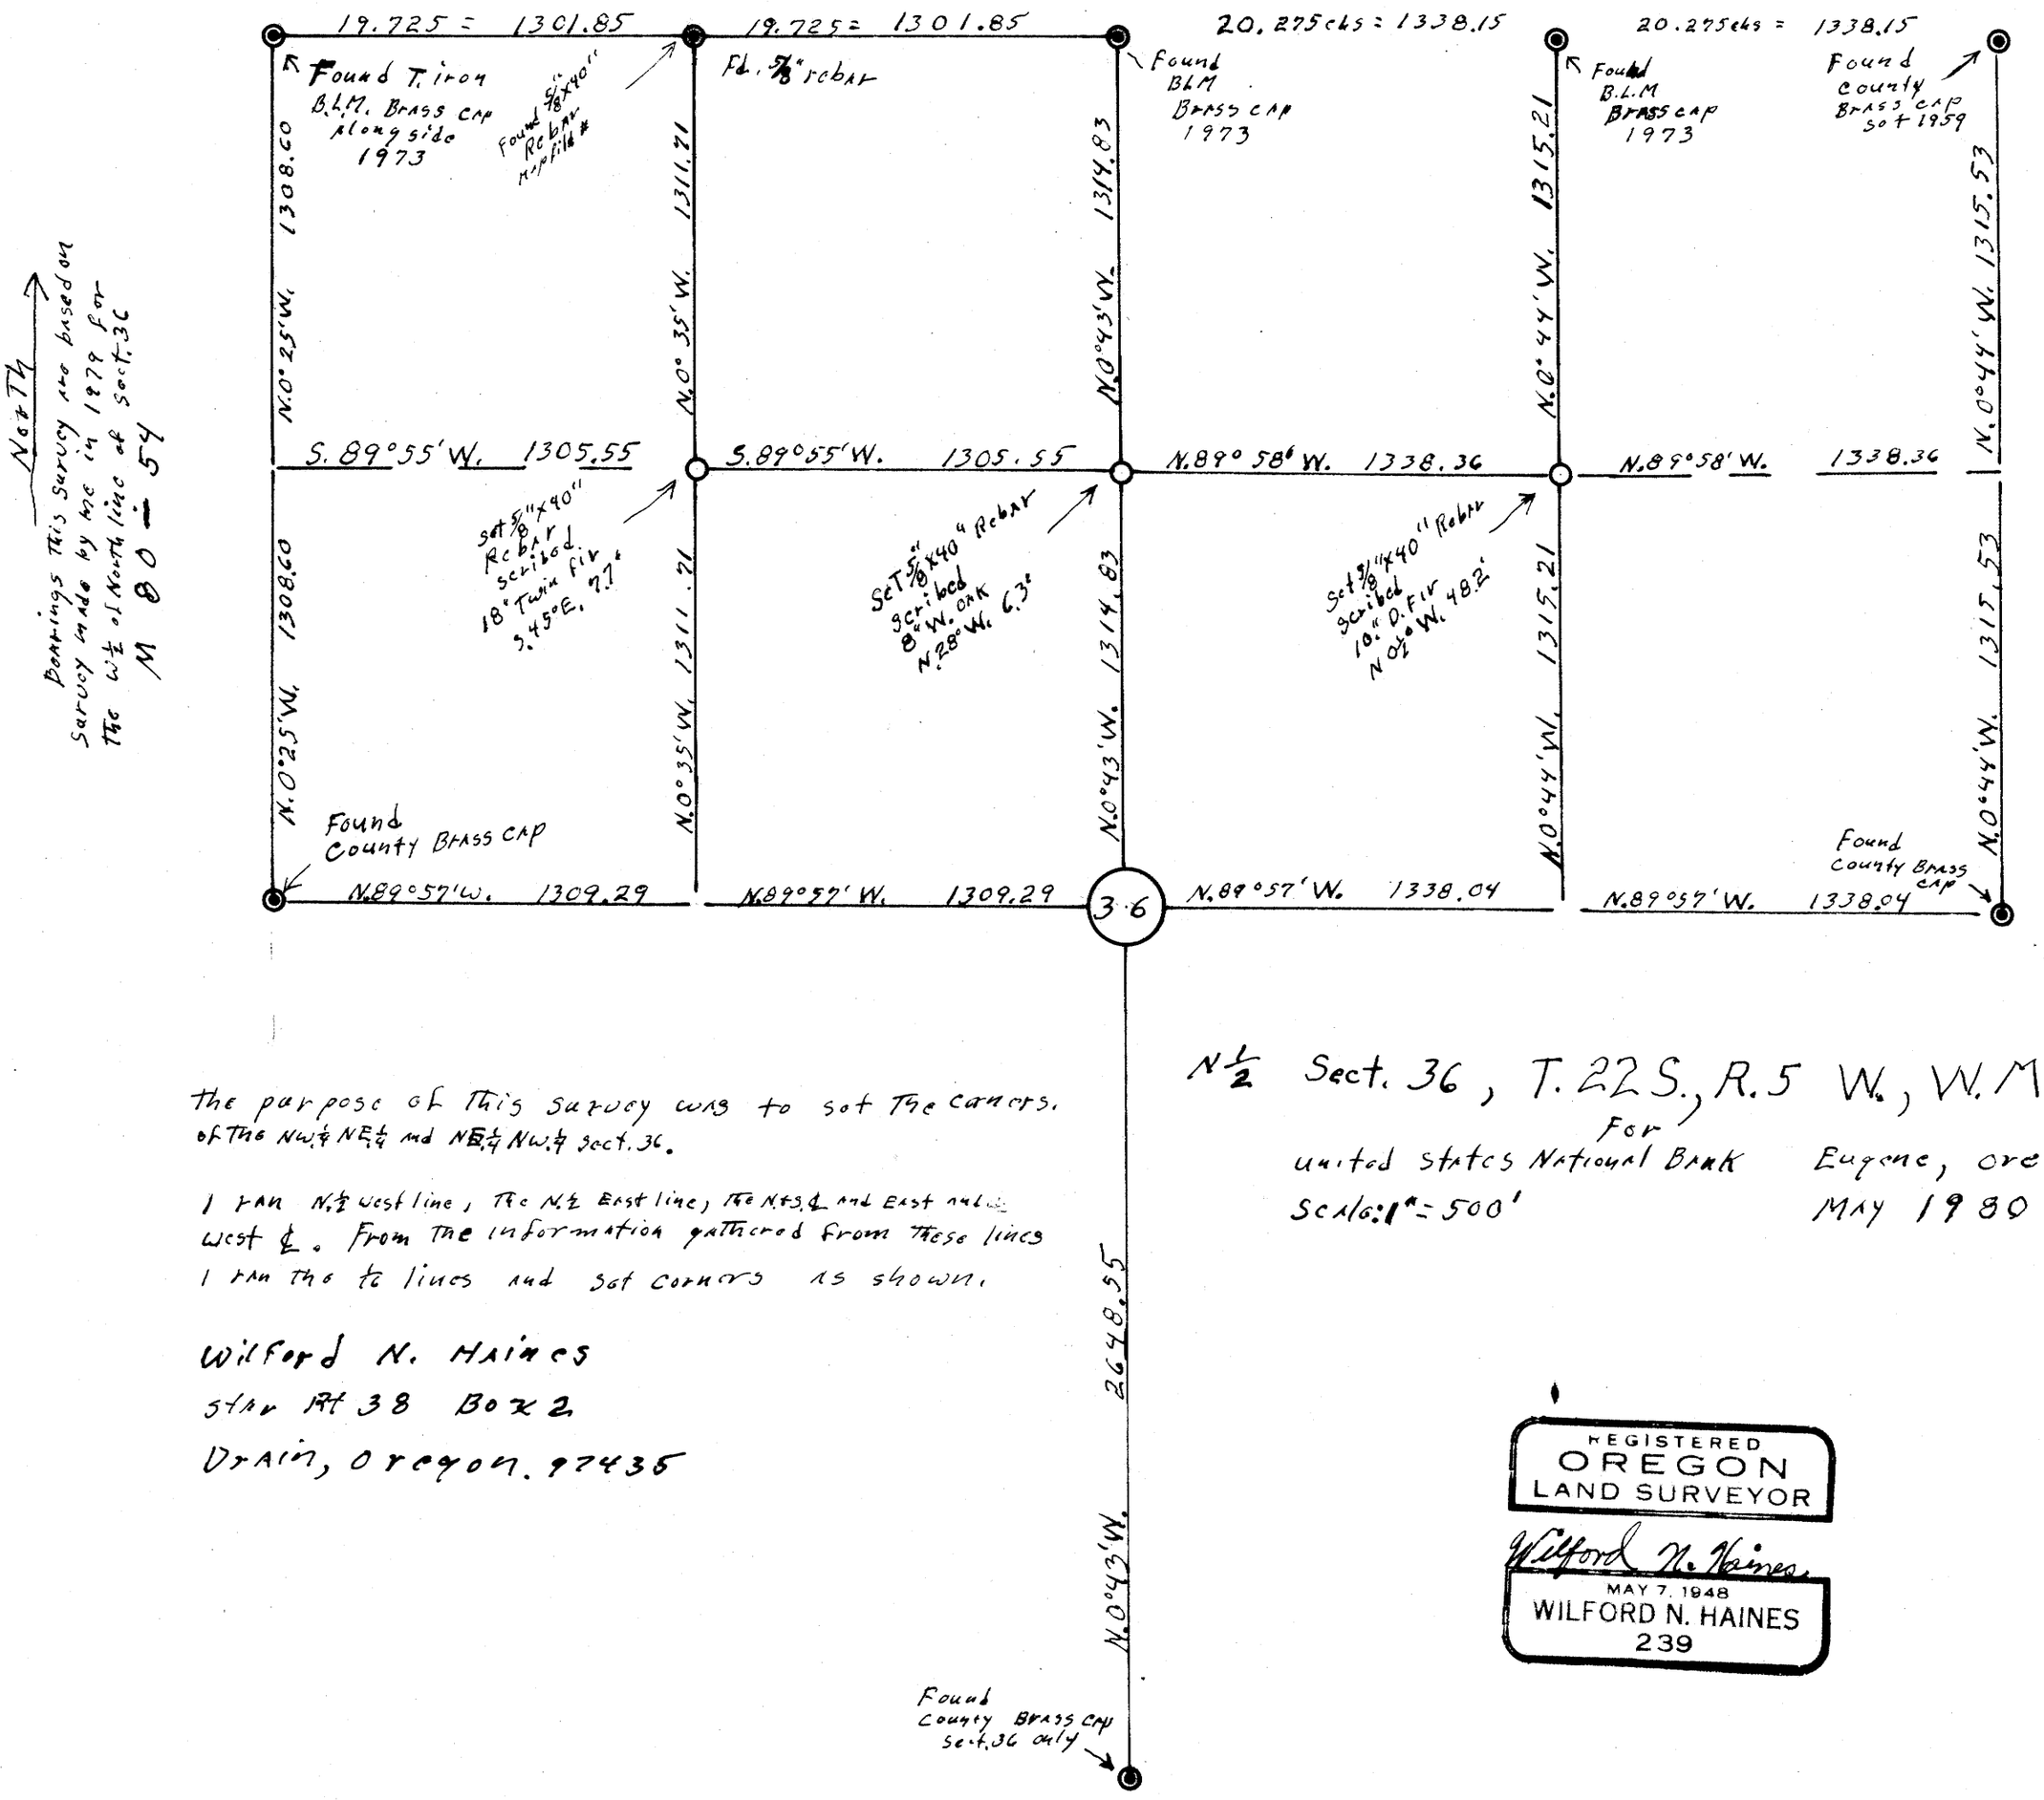

the purpose of this survey was to set the corners of the NW¼NE¼ and NE¼NW¼ sect. 36.

I ran N.½ west line, the N.½ East line, the N.½ & East and West ¼. From the information gathered from these lines I ran the ¼ lines and set corners as shown.

Wilford N. Haines
star Rt 38 Box 2
Drain, Oregon. 97435

N½ Sect. 36, T. 22 S., R. 5 W., W.M.
For
united states National Bank Eugene, ore.
Scale: 1" = 500' MAY 1980

REGISTERED
OREGON
LAND SURVEYOR
Wilford N. Haines
MAY 7, 1948
WILFORD N. HAINES
239

H-221
MAP FILE M83-50