M83-62

COUNTY SURVEYORS FILE DATA
DO NOT REMOVE FROM OFFICE

Subdivision of SE ¼ of Section 8, T24S, R1W, W.M., Oregon

Roseburg Lumber Company — Scale: 1" = 200' — May 26, 1980

LEGEND

- ○ Monument Found
- ● Monument Set
- — Section & Subdivision Lines
- —+— Line Blazed & Painted
- —T— Line Marked With Alum. Tags

I ran a closed traverse around and within the SE ¼ of Section 8 using a Jena 1 second theodolite and a Mac I-E EDM. I achieved a precision of 1:16,407 and adjusted the traverse by the Crandall method. I set the corners by standard subdivision procedure based on the location of existing monuments.

Howard W. Johnstone — P.O. Box 1088 — Roseburg, Oregon

REGISTERED PROFESSIONAL LAND SURVEYOR
Howard W. Johnstone
OREGON
MAY 13, 1980
HOWARD W. JOHNSTONE
498

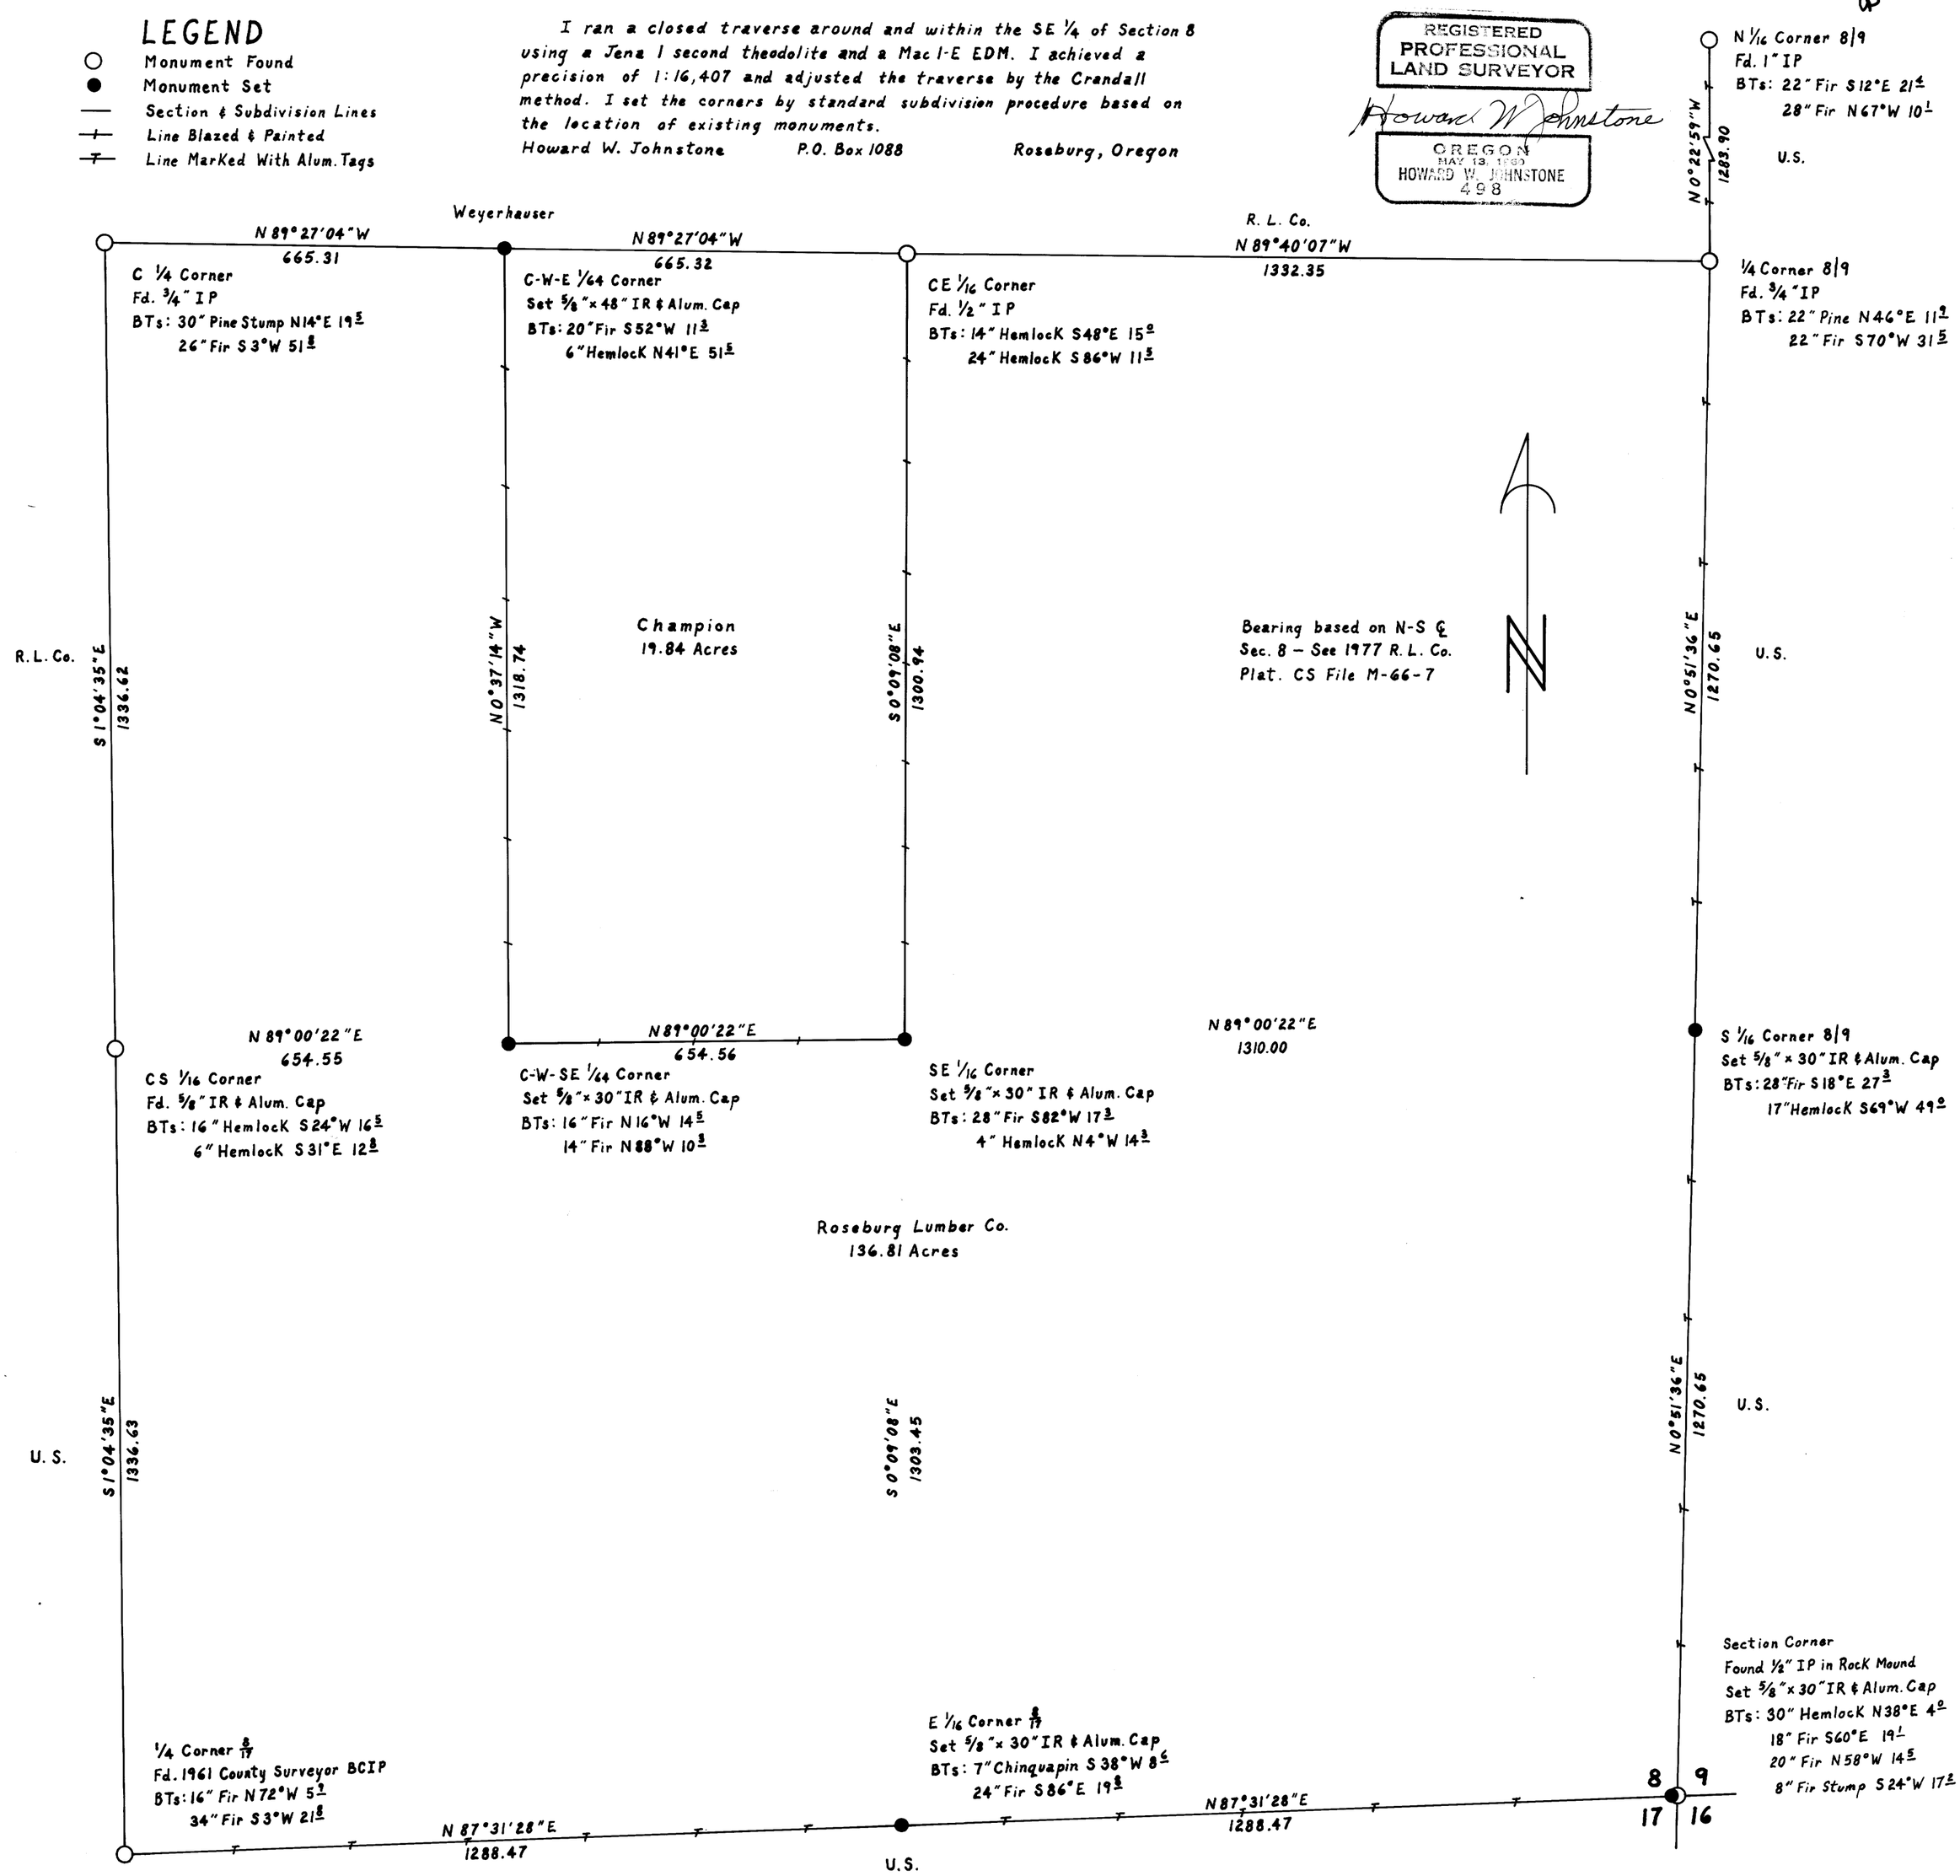

M83-62