Property Survey in Lot 8, Block 1, Plat "A", S.L. & W. Co.
N.E. ¼, Section 16, T25 S, R5W. W.M.
Sutherlin, Oregon
September 1980

COUNTY SURVEYORS FILE DATA
DO NOT REMOVE FROM OFFICE

FILED &
RECEIVED
29
COUNTY SURVEYOR
DOUGLAS COUNTY, ORE.

MAP FILE M85-53

FOR: THE CHURCH OF JESUS CHRIST OF LATTER DAY SAINTS
50 E. NORTH TEMPLE
SALT LAKE CITY, UTAH 84150

BY: ROBERT L. DOLAN
RT. 1 BOX 1820
SUTHERLIN OR. 97479

SCALE 1" = 100'

LEGEND
- ○ Fd. 5/8" iron rod or as noted
- ● Set 5/8" x 30" iron rod
- Fence
- ( ) Parenthesis Denotes record Bearing & Distance

NARRATIVE
Survey around property

REFERENCES:
M35-36, C.S. 58/189, Deeds No. 78-14360
79-04037, 79-15775

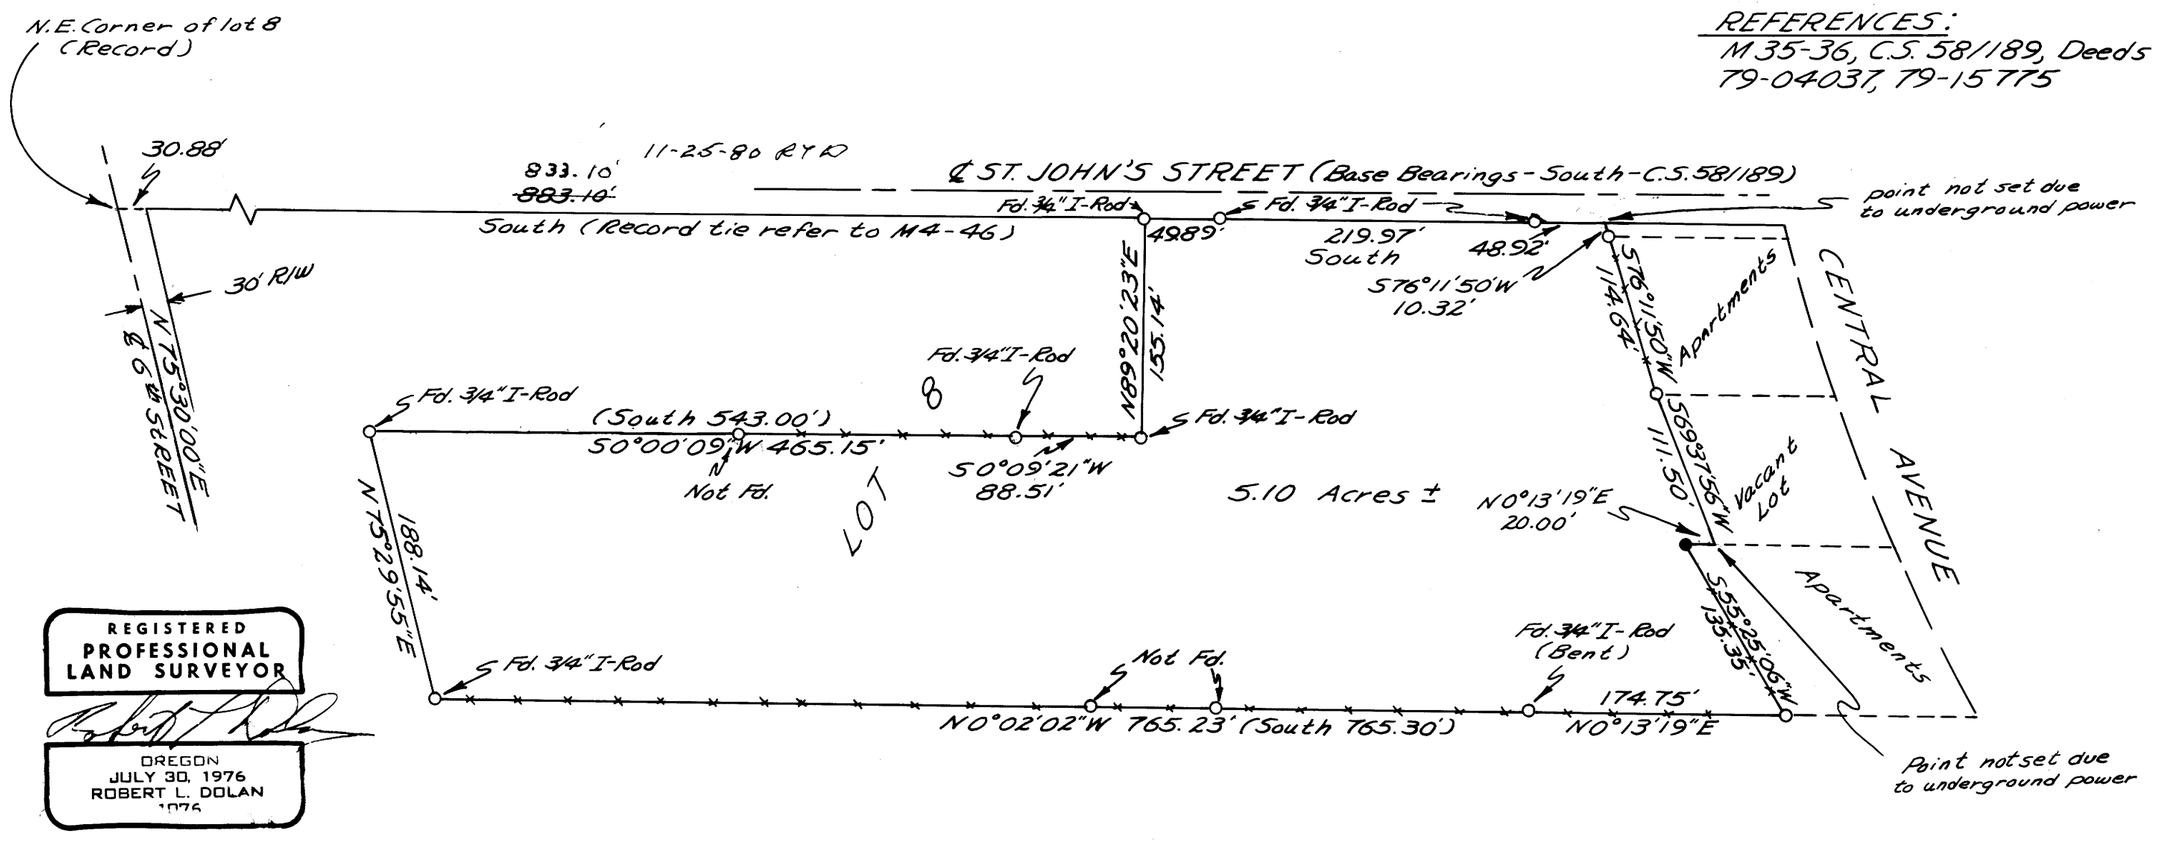

REGISTERED
PROFESSIONAL
LAND SURVEYOR
OREGON
JULY 30, 1976
ROBERT L. DOLAN
1076

MAP FILE M85-53