COUNTY SURVEYORS FILE DATA
DO NOT REMOVE FROM OFFICE

FILED &
RECEIVED
OCT 9 1980
COUNTY SURVEYOR
DOUGLAS COUNTY, ORE.
&
OFFICIAL USE ONLY

MAP FILE M85-66

SURVEY TO SET CORNERS ON A PORTION OF LOT 2 BLK. 1 PLAT D UMPQUA PARK FRUIT LANDS. N.W. 1/4 SEC. 25, T27S, R6W, W.M.

BY: BAUGHMAN TECH. SERV.
5157 N. UMPQUA HWY.
ROSEBURG, OREGON
97470

FOR: JACK SMITH
P.O. BOX 1493
ROSEBURG, ORE.
97470

SCALE: 1" = 40'

SEPT. 1980

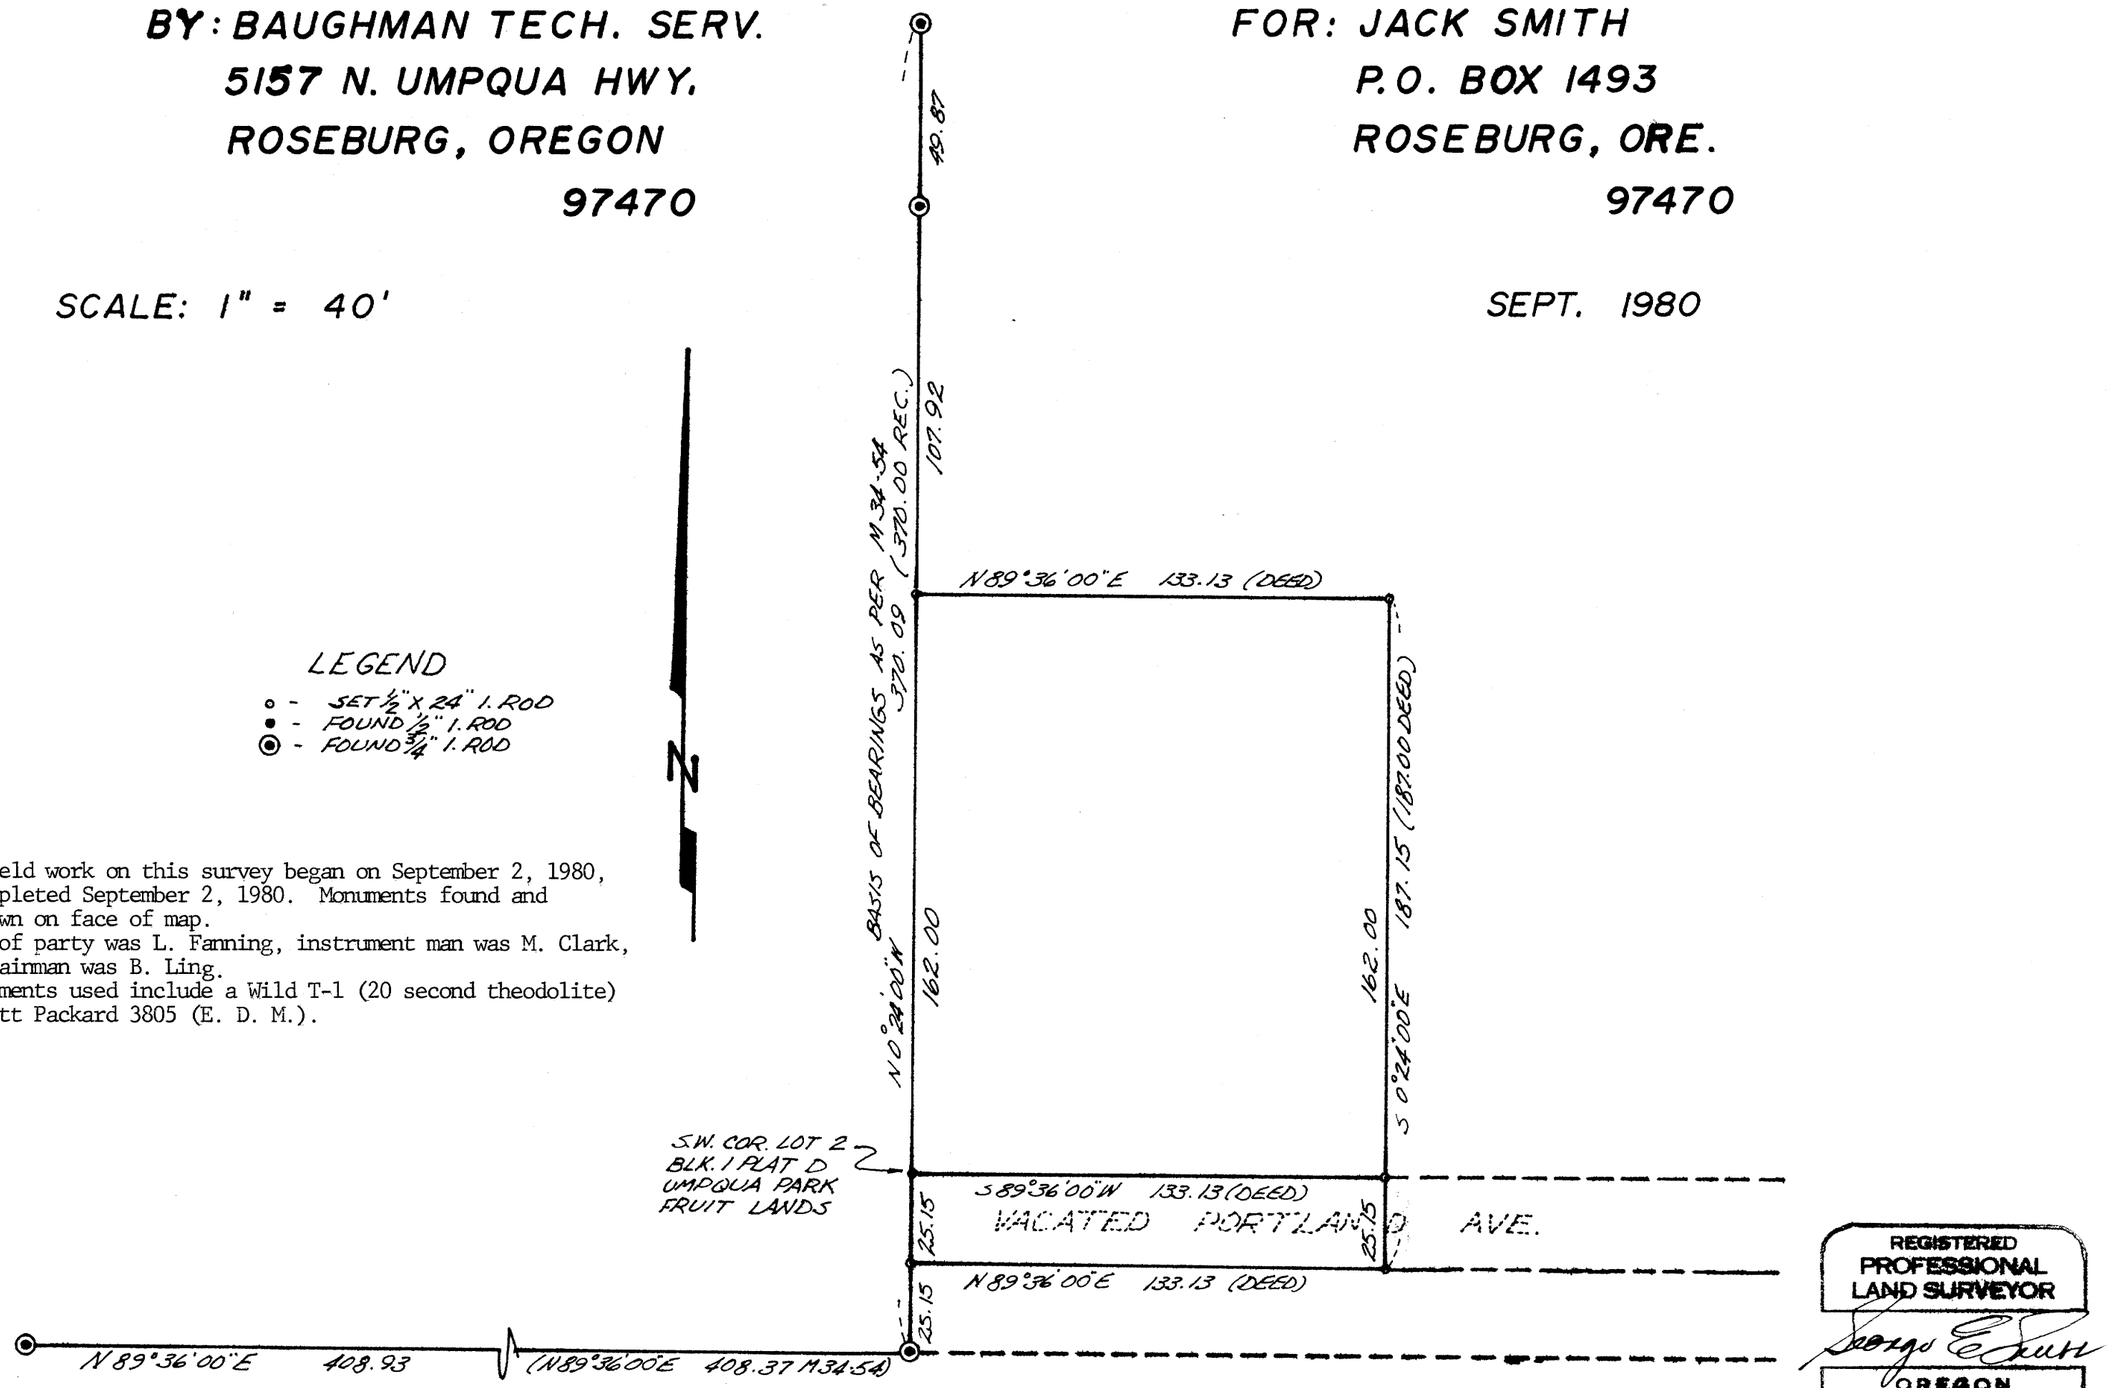

Narrative:

The field work on this survey began on September 2, 1980, and was completed September 2, 1980. Monuments found and used as shown on face of map.

Chief of party was L. Fanning, instrument man was M. Clark, and head chainman was B. Ling.

Instruments used include a Wild T-1 (20 second theodolite) and a Hewlitt Packard 3805 (E. D. M.).

REGISTERED PROFESSIONAL LAND SURVEYOR
George E. Gubb
OREGON
MAY 10, 1967
GEORGE E. GUBB
397

M85-66