MAP FILE M 86-16

Property Survey In The N½, SE¼ Section 30, T23S, R5W, W.M., Douglas County, Oregon

COUNTY SURVEYORS FILE DATA
DO NOT REMOVE FROM OFFICE

For: Marvin B. Highley
By: Robert L. Dolan
Rt. 1, Box 1820
Sutherlin, Oregon

Date: December 1980

FILED B.S
RECEIVED B.S
DEC 1 6 1980
COUNTY SURVEYOR
B.S

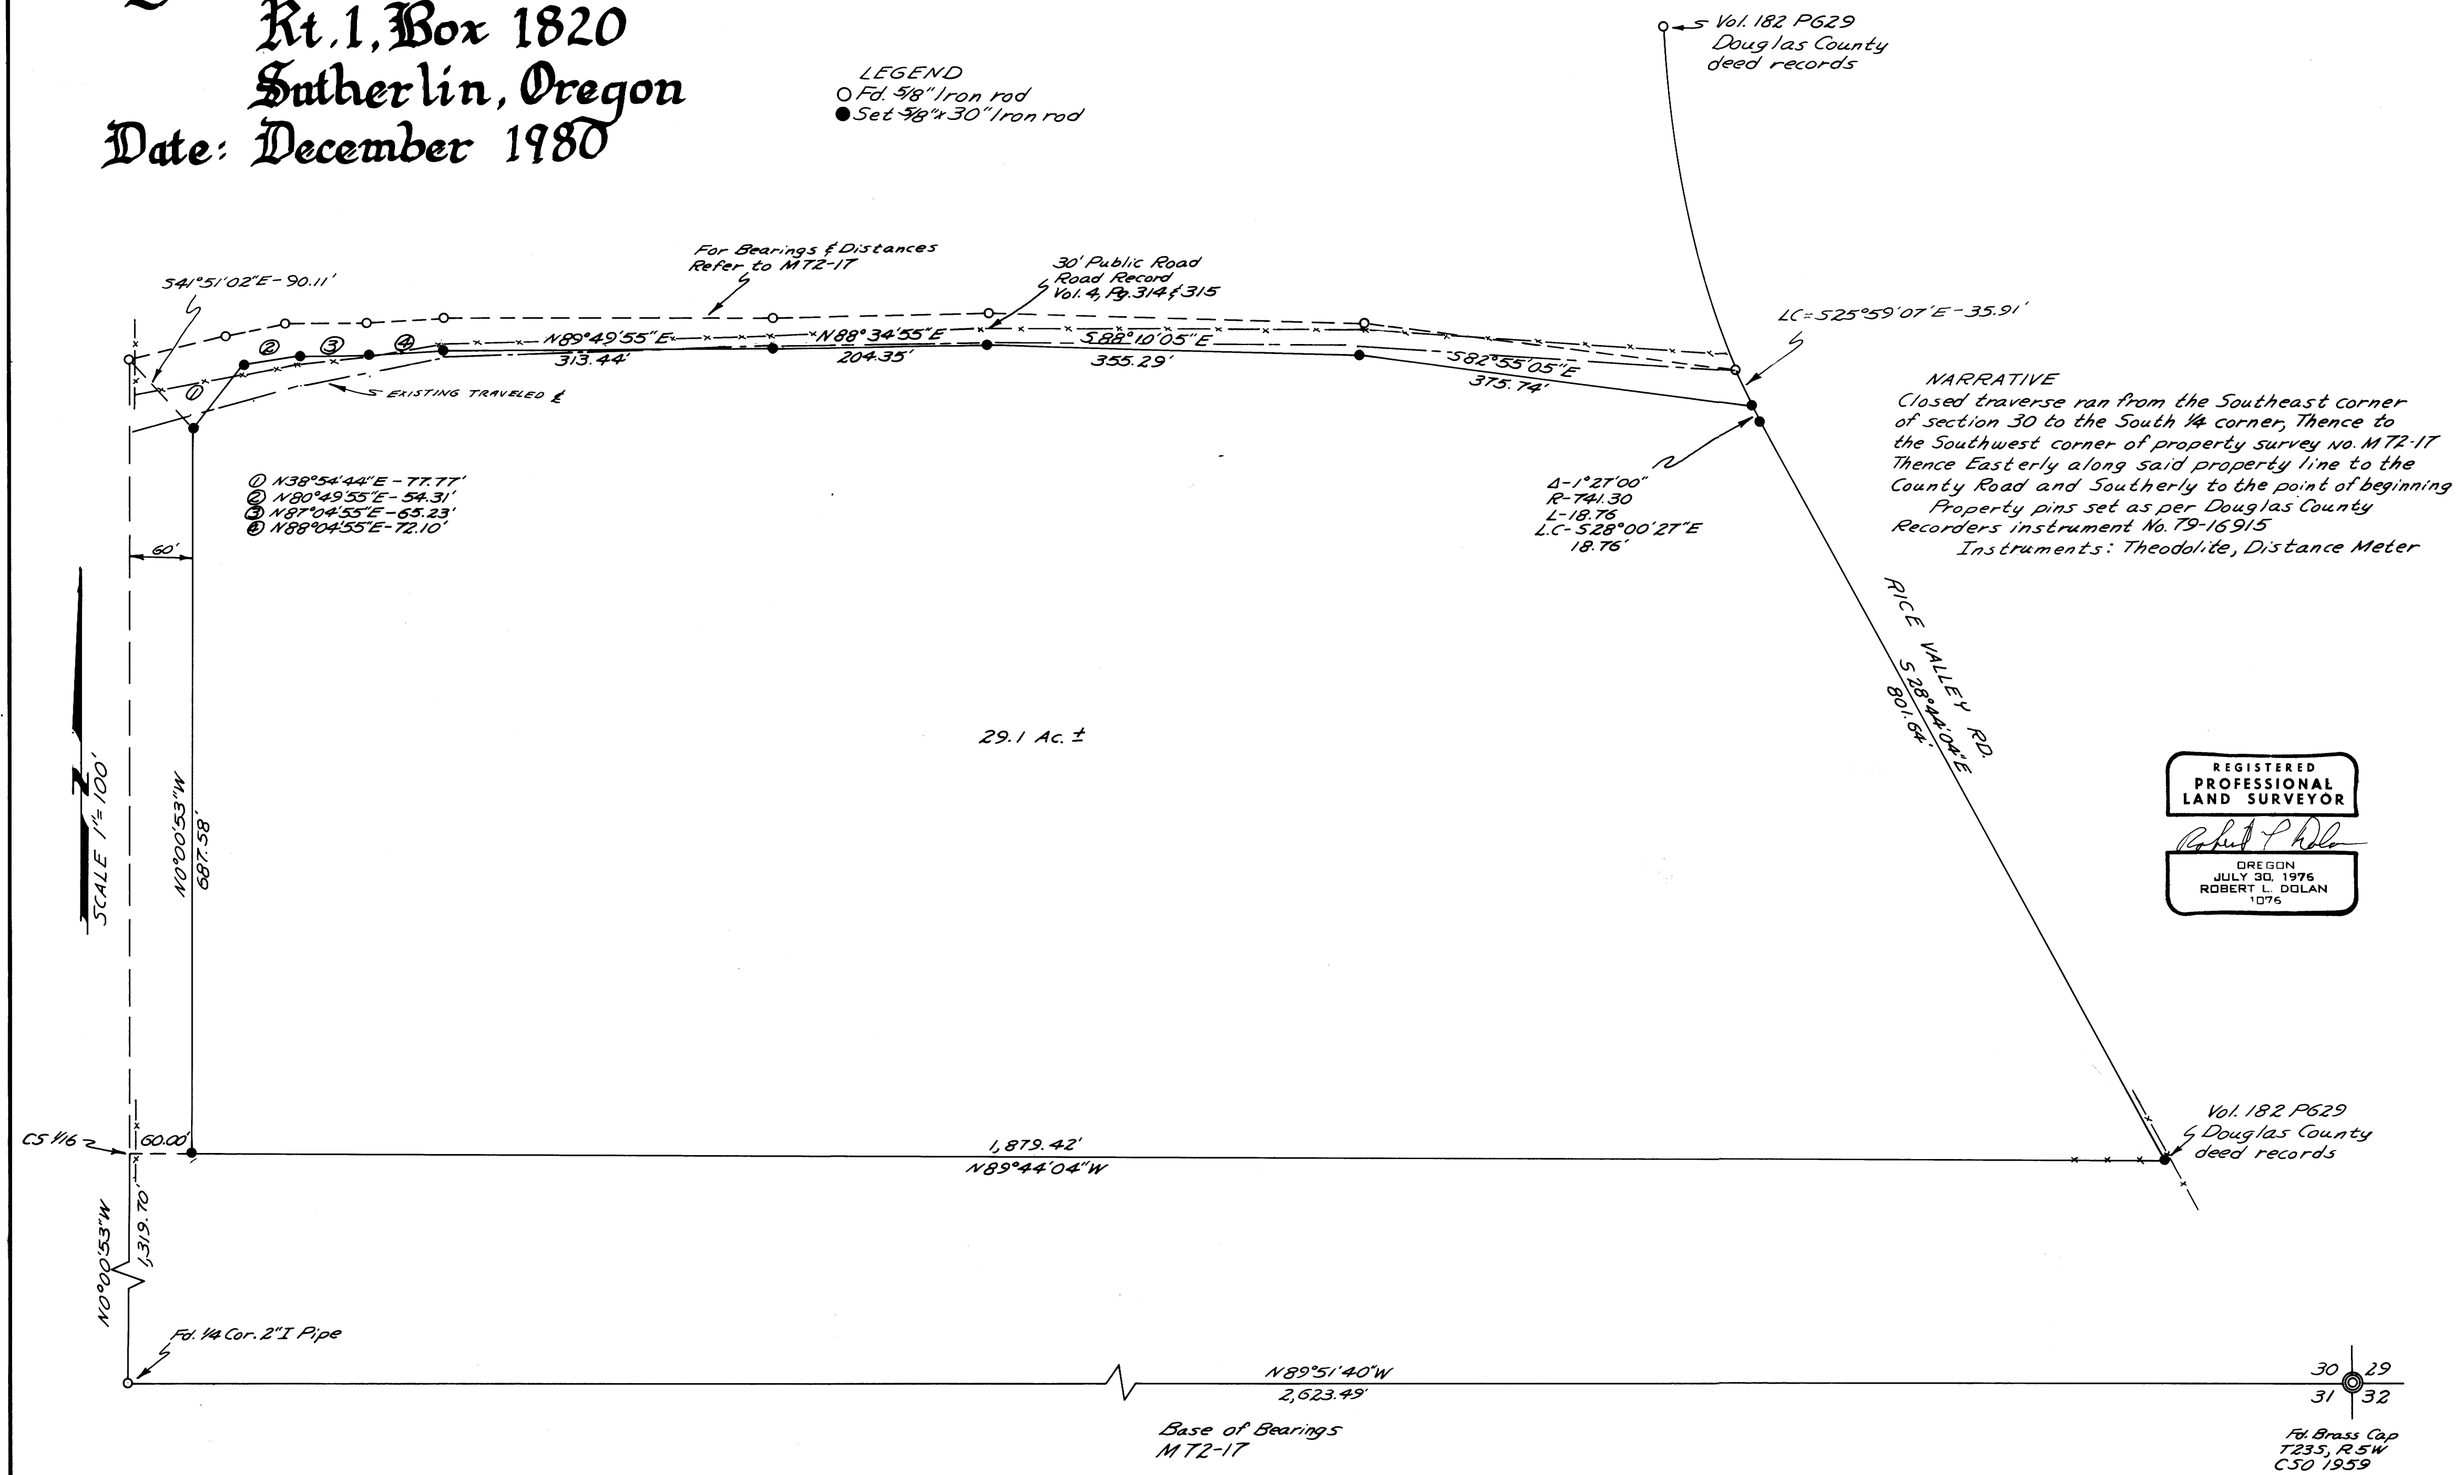

MAP FILE M 86-16