SURVEY OF LOT 14 AND A PORTION OF LOT 13, BLOCK 3, "FAIRACRES" IN THE N.E. 1/4 OF SECTION 36, T26S, R6W, W.M.

COUNTY SURVEYORS FILE DATA
DO NOT REMOVE FROM OFFICE

RECEIVED BS
JAN 7 1981
COUNTY SURVEYOR
DOUGLAS COUNTY, ORE.
BS

FOR: LLOYD PLAISTED & K. C. WATSON
BY: BHW ENGINEERING & SURVEYING, INC.
1205 S.E. COURT – ROSEBURG, OREGON

SCALE: 1" = 100'
NOVEMBER 1980

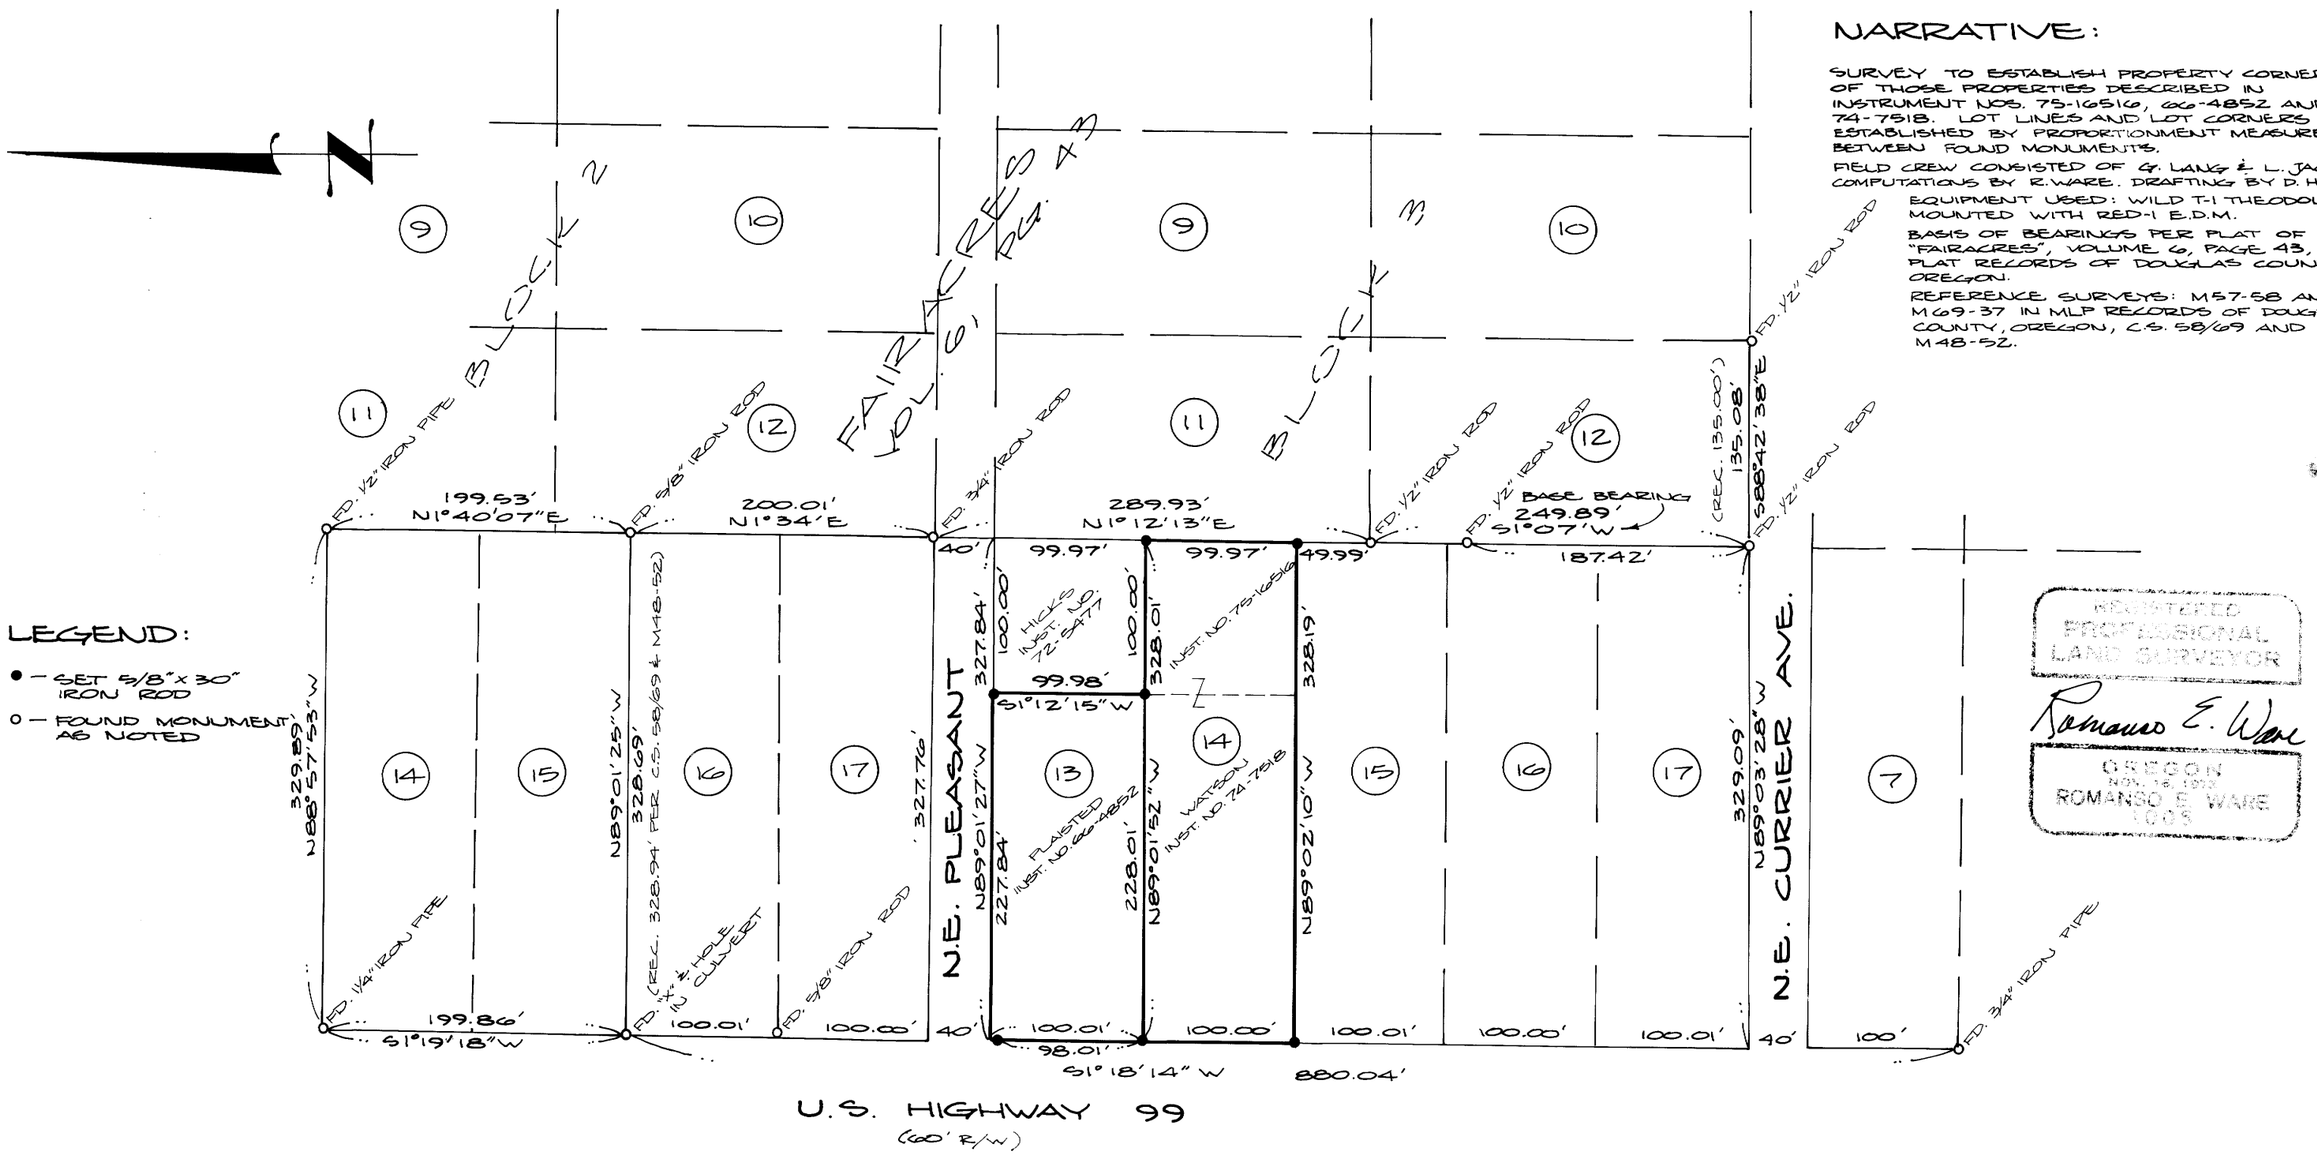

NARRATIVE:

SURVEY TO ESTABLISH PROPERTY CORNERS OF THOSE PROPERTIES DESCRIBED IN INSTRUMENT NOS. 75-16516, 66-4852 AND 74-7518. LOT LINES AND LOT CORNERS ESTABLISHED BY PROPORTIONMENT MEASUREMENT BETWEEN FOUND MONUMENTS.

FIELD CREW CONSISTED OF G. LANG & L. JACOBS. COMPUTATIONS BY R. WARE. DRAFTING BY D. HOPKINS.

EQUIPMENT USED: WILD T-1 THEODOLITE MOUNTED WITH RED-1 E.D.M.

BASIS OF BEARINGS PER PLAT OF "FAIRACRES", VOLUME 6, PAGE 43, PLAT RECORDS OF DOUGLAS COUNTY, OREGON.

REFERENCE SURVEYS: M57-58 AND M69-37 IN MLP RECORDS OF DOUGLAS COUNTY, OREGON, C.S. 58/69 AND M48-52.

LEGEND:

- ● – SET 5/8" x 30" IRON ROD
- o – FOUND MONUMENT AS NOTED

REGISTERED PROFESSIONAL LAND SURVEYOR
Romanso E. Ware
OREGON
NOV. 18 1980
ROMANSO E. WARE
1005

MAP FILE M86-32

MAP FILE M86-32