MAP FILE M86-6

COUNTY SURVEYORS FILE DATA
DO NOT REMOVE FROM OFFICE

Resurvey & Subdivision of Section 2, T 30 S, R 3 W, W. M.

For Roseburg Lumber Company — October 9, 1980

Scale 1" = 400'

FILED
RECEIVED
NOV 10 1980
COUNTY SURVEYOR
DOUGLAS COUNTY, ORE.

I ran a closed traverse in Section 2 using a Jena 1 second theodolite and a Mac I-E EDM. I achieved a precision of 1:37,254 on the exterior and 1:12,499 on the interior. I adjusted both traverses by the Crandall method. I set the corners by standard subdivision procedure based on the location of the existing monuments.

Howard W. Johnstone P.O. Box 1088 Roseburg, Oregon

Legend

- ○ Monument Found
- ● Monument Set
- —— Section or Property Line
- —T— Line Referenced to Aluminum Tags

Bearings based on Solar Observation

REGISTERED PROFESSIONAL LAND SURVEYOR
Howard W. Johnstone
OREGON
MAY 13, 1960
HOWARD W. JOHNSTONE
498

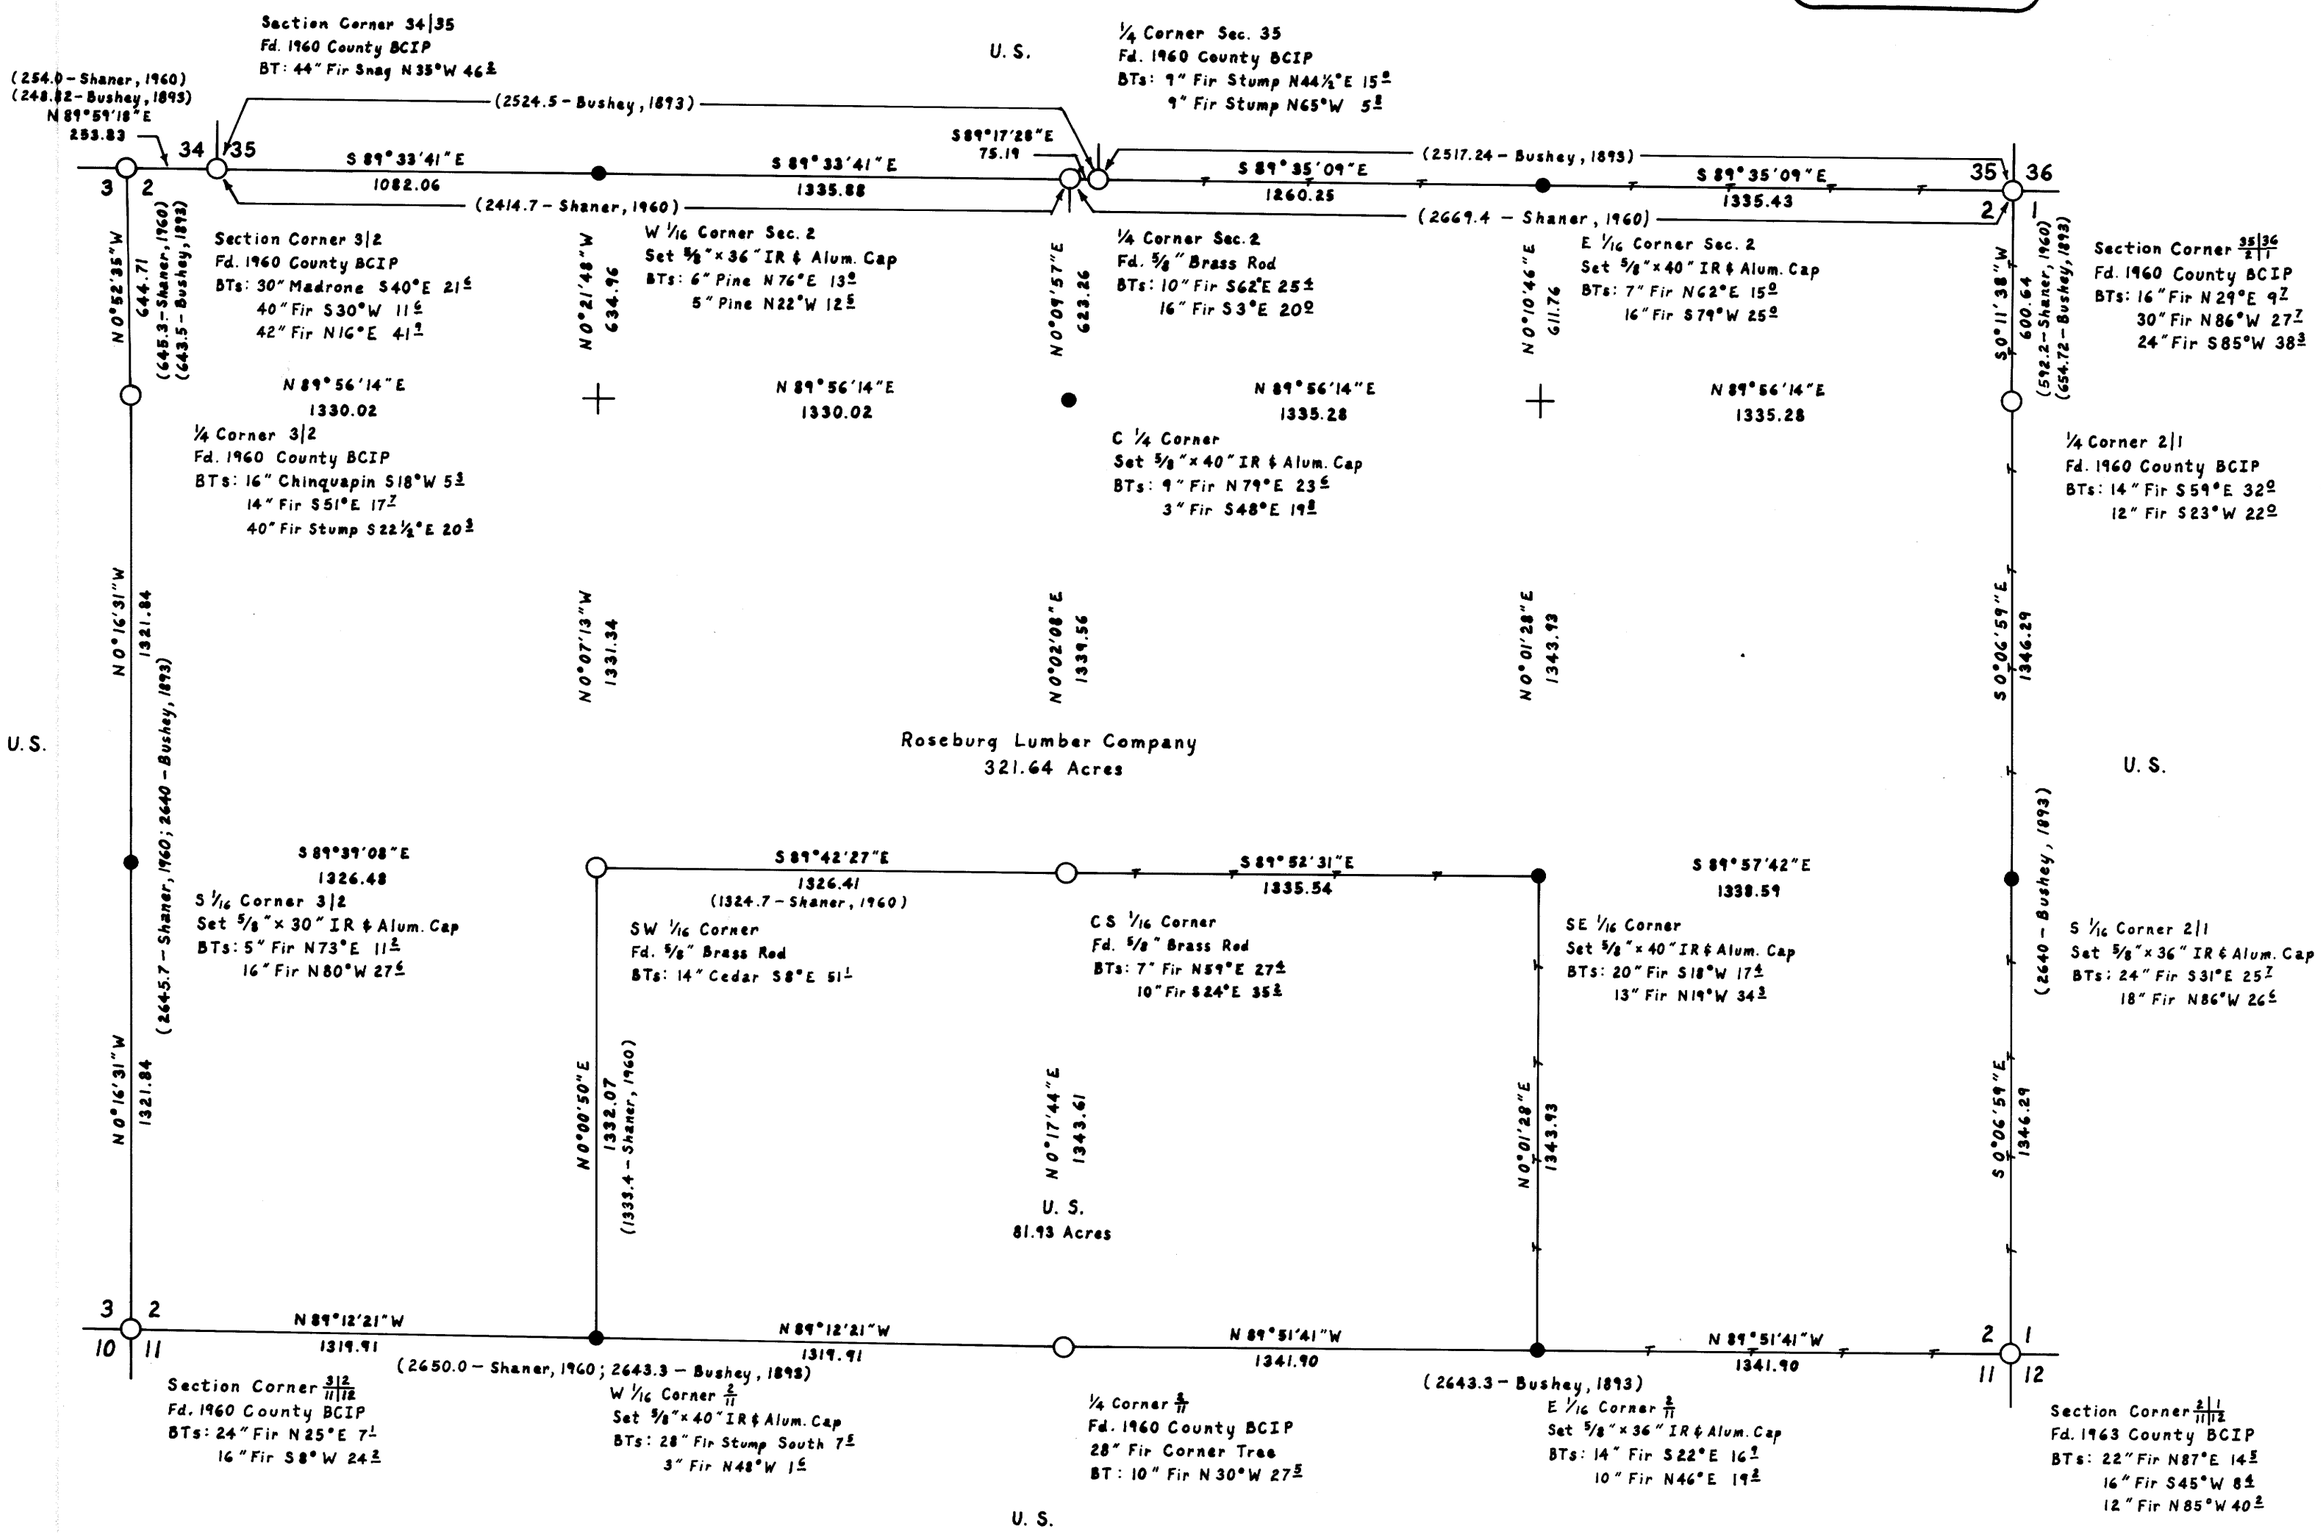

MAP FILE M86-6