MAP FILE M86-77

COUNTY SURVEYORS FILE DATA
DO NOT REMOVE FROM OFFICE

Resurvey And Subdivision of W½ & NE¼ of Section 2, T30S, R7W, W.M., Oregon

For Roseburg Lumber Company

January 30, 1981

Scale: 1" = 400'

FILED BS
RECEIVED
MAR 10 1981
COUNTY SURVEYOR
DOUGLAS COUNTY, ORE.
BS

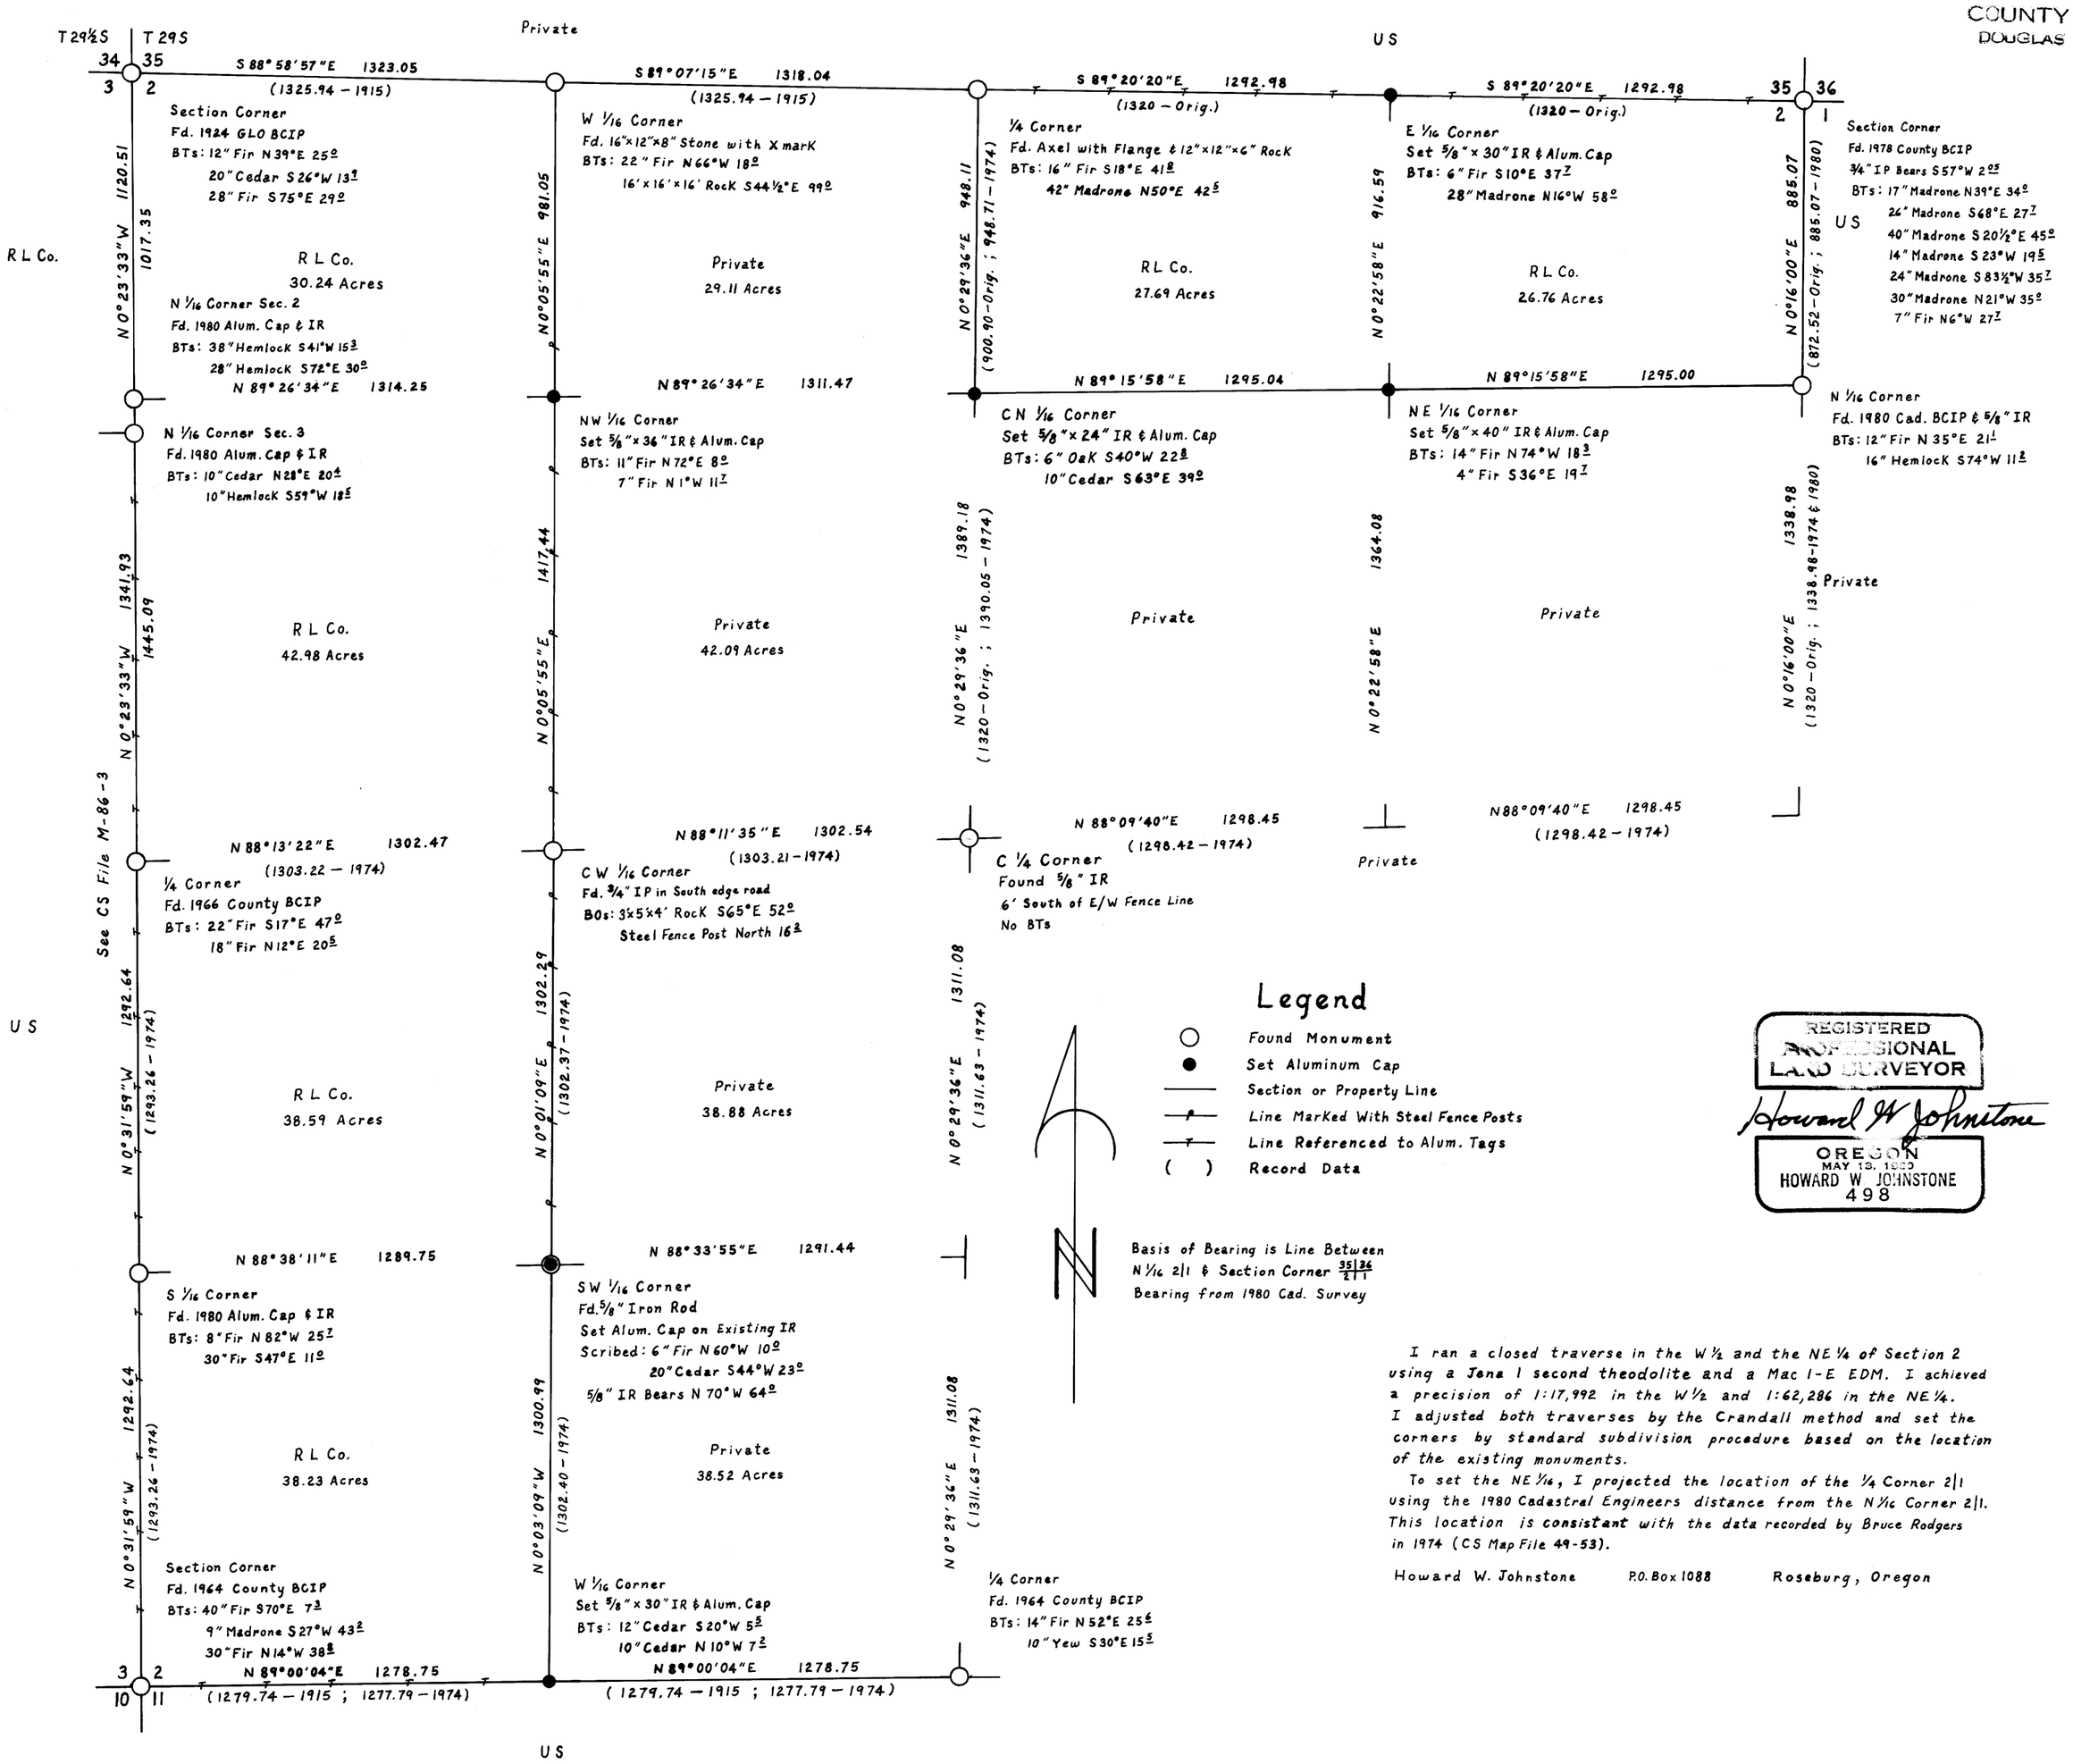

REGISTERED
PROFESSIONAL
LAND SURVEYOR
Howard W. Johnstone
OREGON
MAY 13, 1980
HOWARD W. JOHNSTONE
498

I ran a closed traverse in the W½ and the NE¼ of Section 2 using a Jena I second theodolite and a Mac I-E EDM. I achieved a precision of 1:17,992 in the W½ and 1:62,286 in the NE¼. I adjusted both traverses by the Crandall method and set the corners by standard subdivision procedure based on the location of the existing monuments.

To set the NE 1/16, I projected the location of the ¼ Corner 2|1 using the 1980 Cadastral Engineers distance from the N 1/16 Corner 2|1. This location is consistant with the data recorded by Bruce Rodgers in 1974 (CS Map File 49-53).

Howard W. Johnstone P.O. Box 1088 Roseburg, Oregon

MAP FILE M86-77