COUNTY SURVEYORS FILE DATA
DO NOT REMOVE FROM OFFICE

SURVEY IN NE 1/4 OF SECTION 13, T27S, R6W, W.M.

(PORTION OF LOT 14, "FRUITVALE ADDITION TO ROSEBURG", IN S.C. BRADEN D.L.C. NO. 63)

SCALE: 1" = 20' MARCH 1981

FILED BS
RECEIVED
APR 13 1981
COUNTY SURVEYOR
DOUGLAS COUNTY, ORE.
BS

MAP FILE M87-34

FOR: KEN GLASS
BY: BHW ENGINEERING & SURVEYING
1205 S.E. COURT
ROSEBURG, OREGON

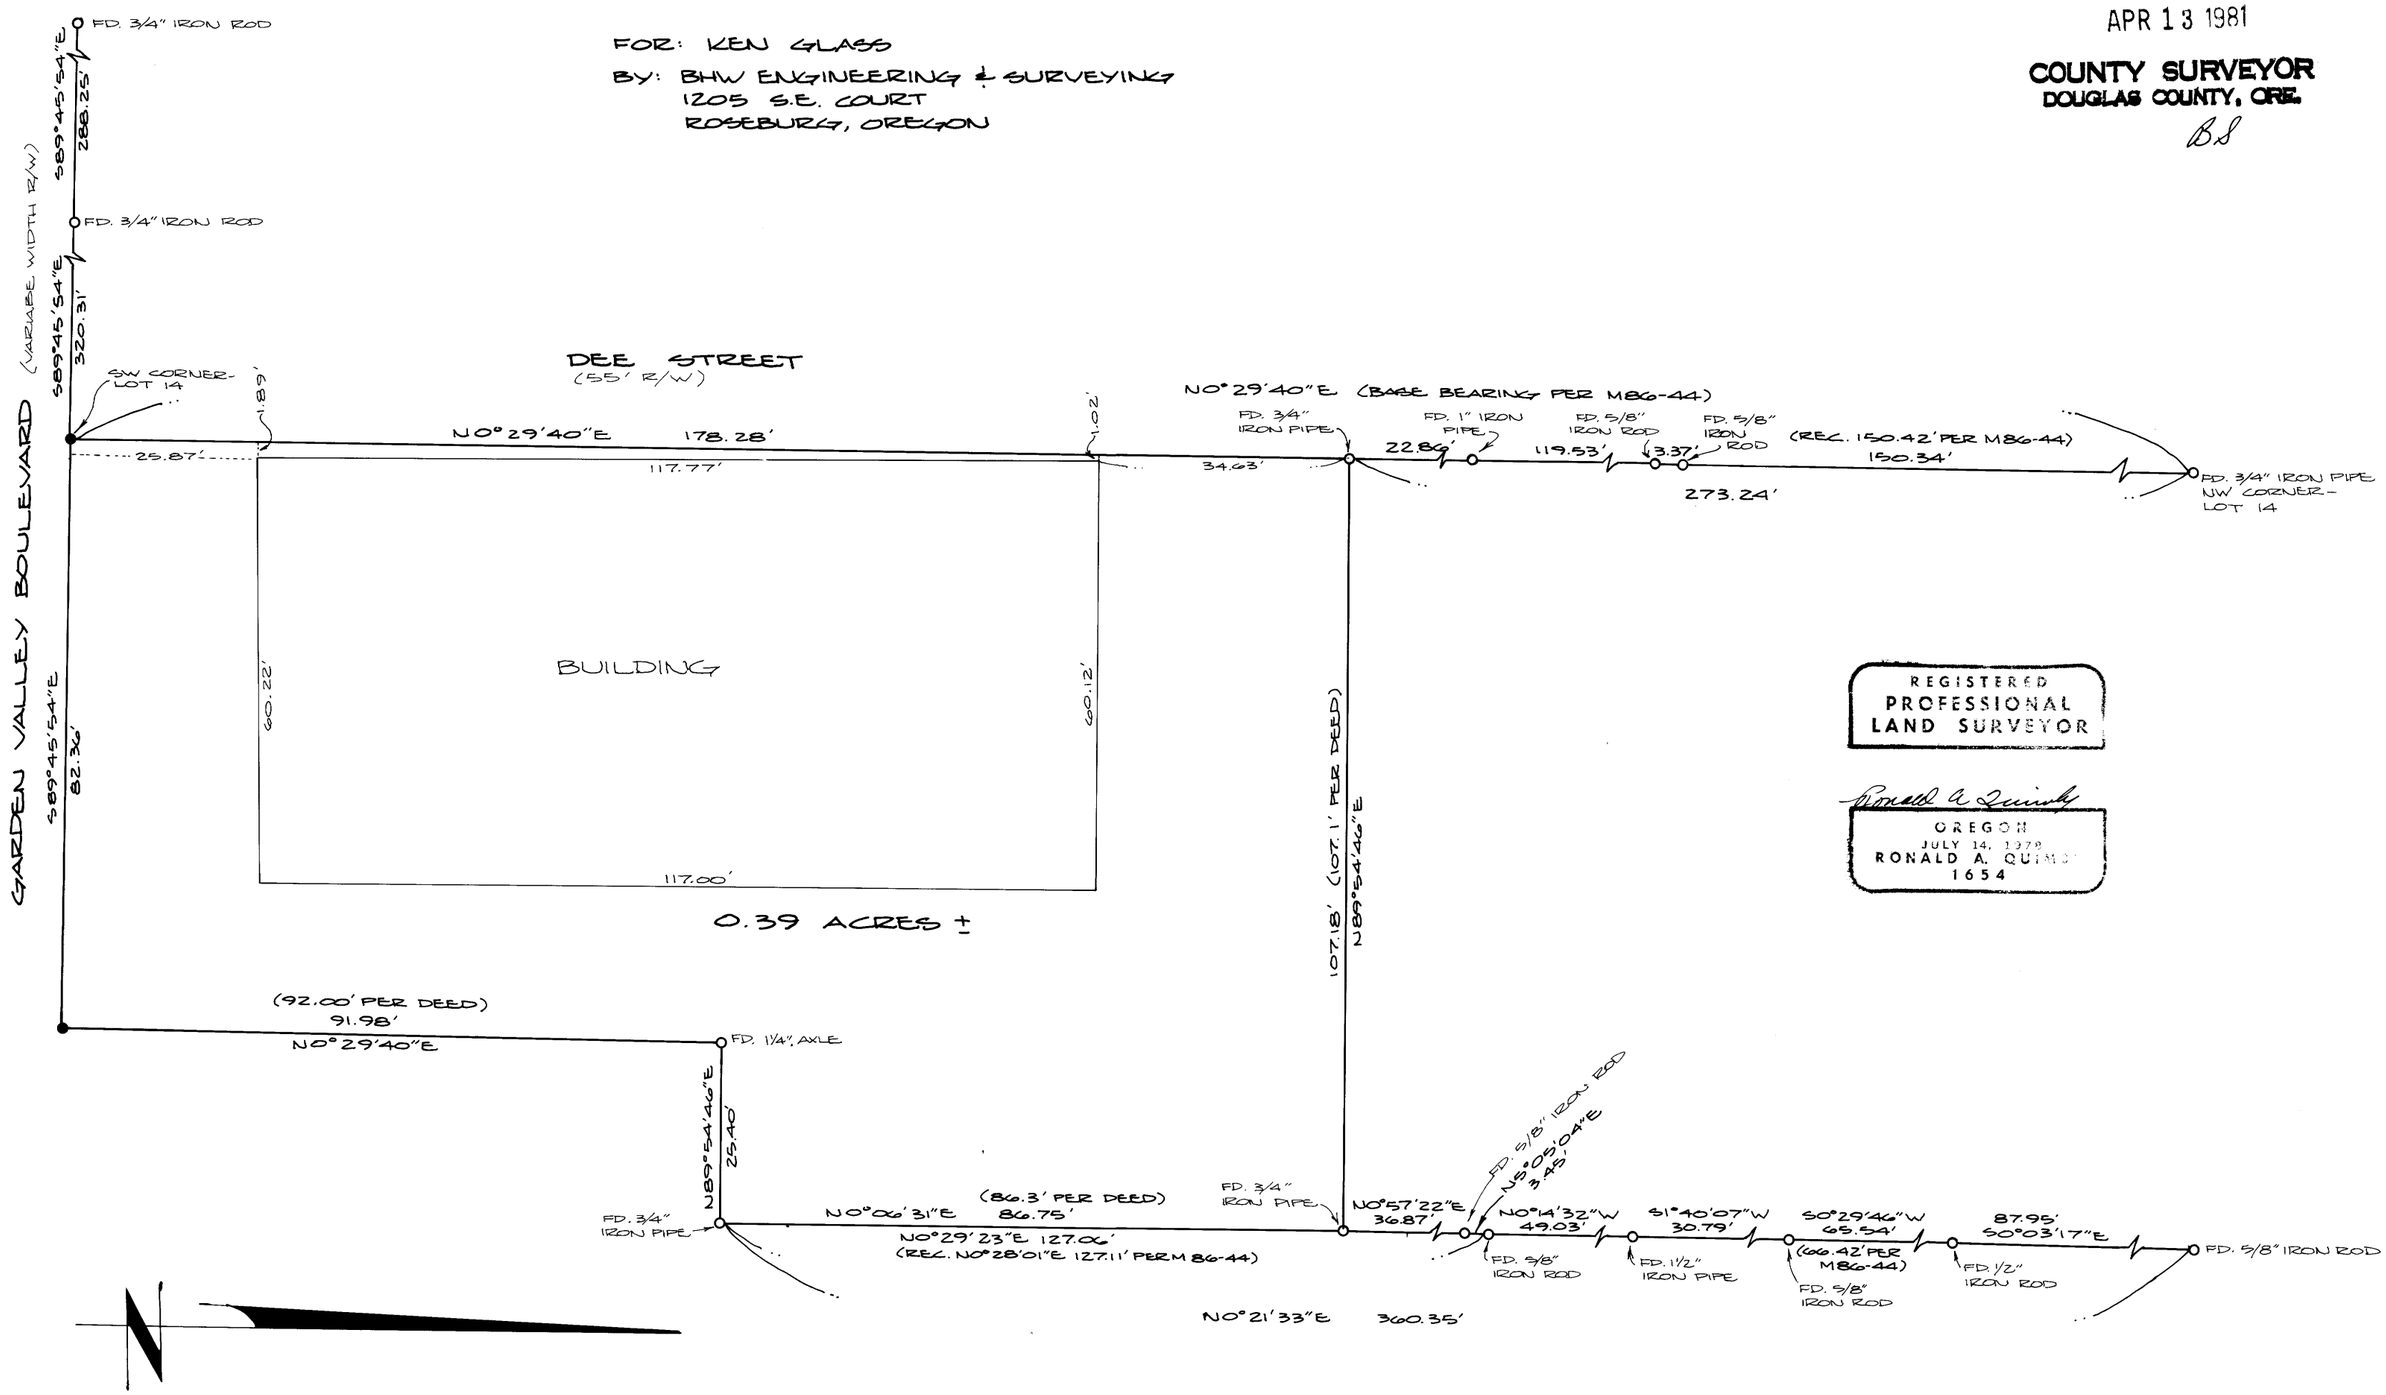

REGISTERED
PROFESSIONAL
LAND SURVEYOR

Ronald A. Quimby

OREGON
JULY 14, 1979
RONALD A. QUIMBY
1654

NARRATIVE:

SURVEY TO SET PROPERTY CORNERS. ROAD CONTROL ESTABLISHED PER FOUND MONUMENTS. FIELD CREW: G. LANG & D. DELATTE. EQUIPMENT USED: WILD T-1 THEODOLITE & RED-1 E.D.M. OFFICE COMPUTATIONS: R. QUIMBY. DRAFTING: M. RIGGAN & D. HOPKINS. REFERENCE SURVEYS: M52-80, M22-5, M86-44, M34-25, M7-67, M31-26. REFERENCE DEED: INST. NO. 77-22100.

LEGEND:

- ● – SET 5/8" x 30" IRON ROD
- ○ – FOUND MONUMENT AS NOTED

MAP FILE M87-34