MAP FILE M87-52

SURVEY IN THE SE 1/4 SECT. 6 AND THE NE 1/4 SECT. 7, TWP. 24 S., RNG. 4 W., W.M.
Surveyed for Cliff Bryden by Landline Development Co.
April, 1981 Scale 1" = 100'
o Set 5/8" x 30" Iron Rod

COUNTY SURVEYORS FILE DATA
DO NOT REMOVE FROM OFFICE

FILED BS
RECEIVED
MAY 11 1981
COUNTY SURVEYOR
DOUGLAS COUNTY, ORE.
BS

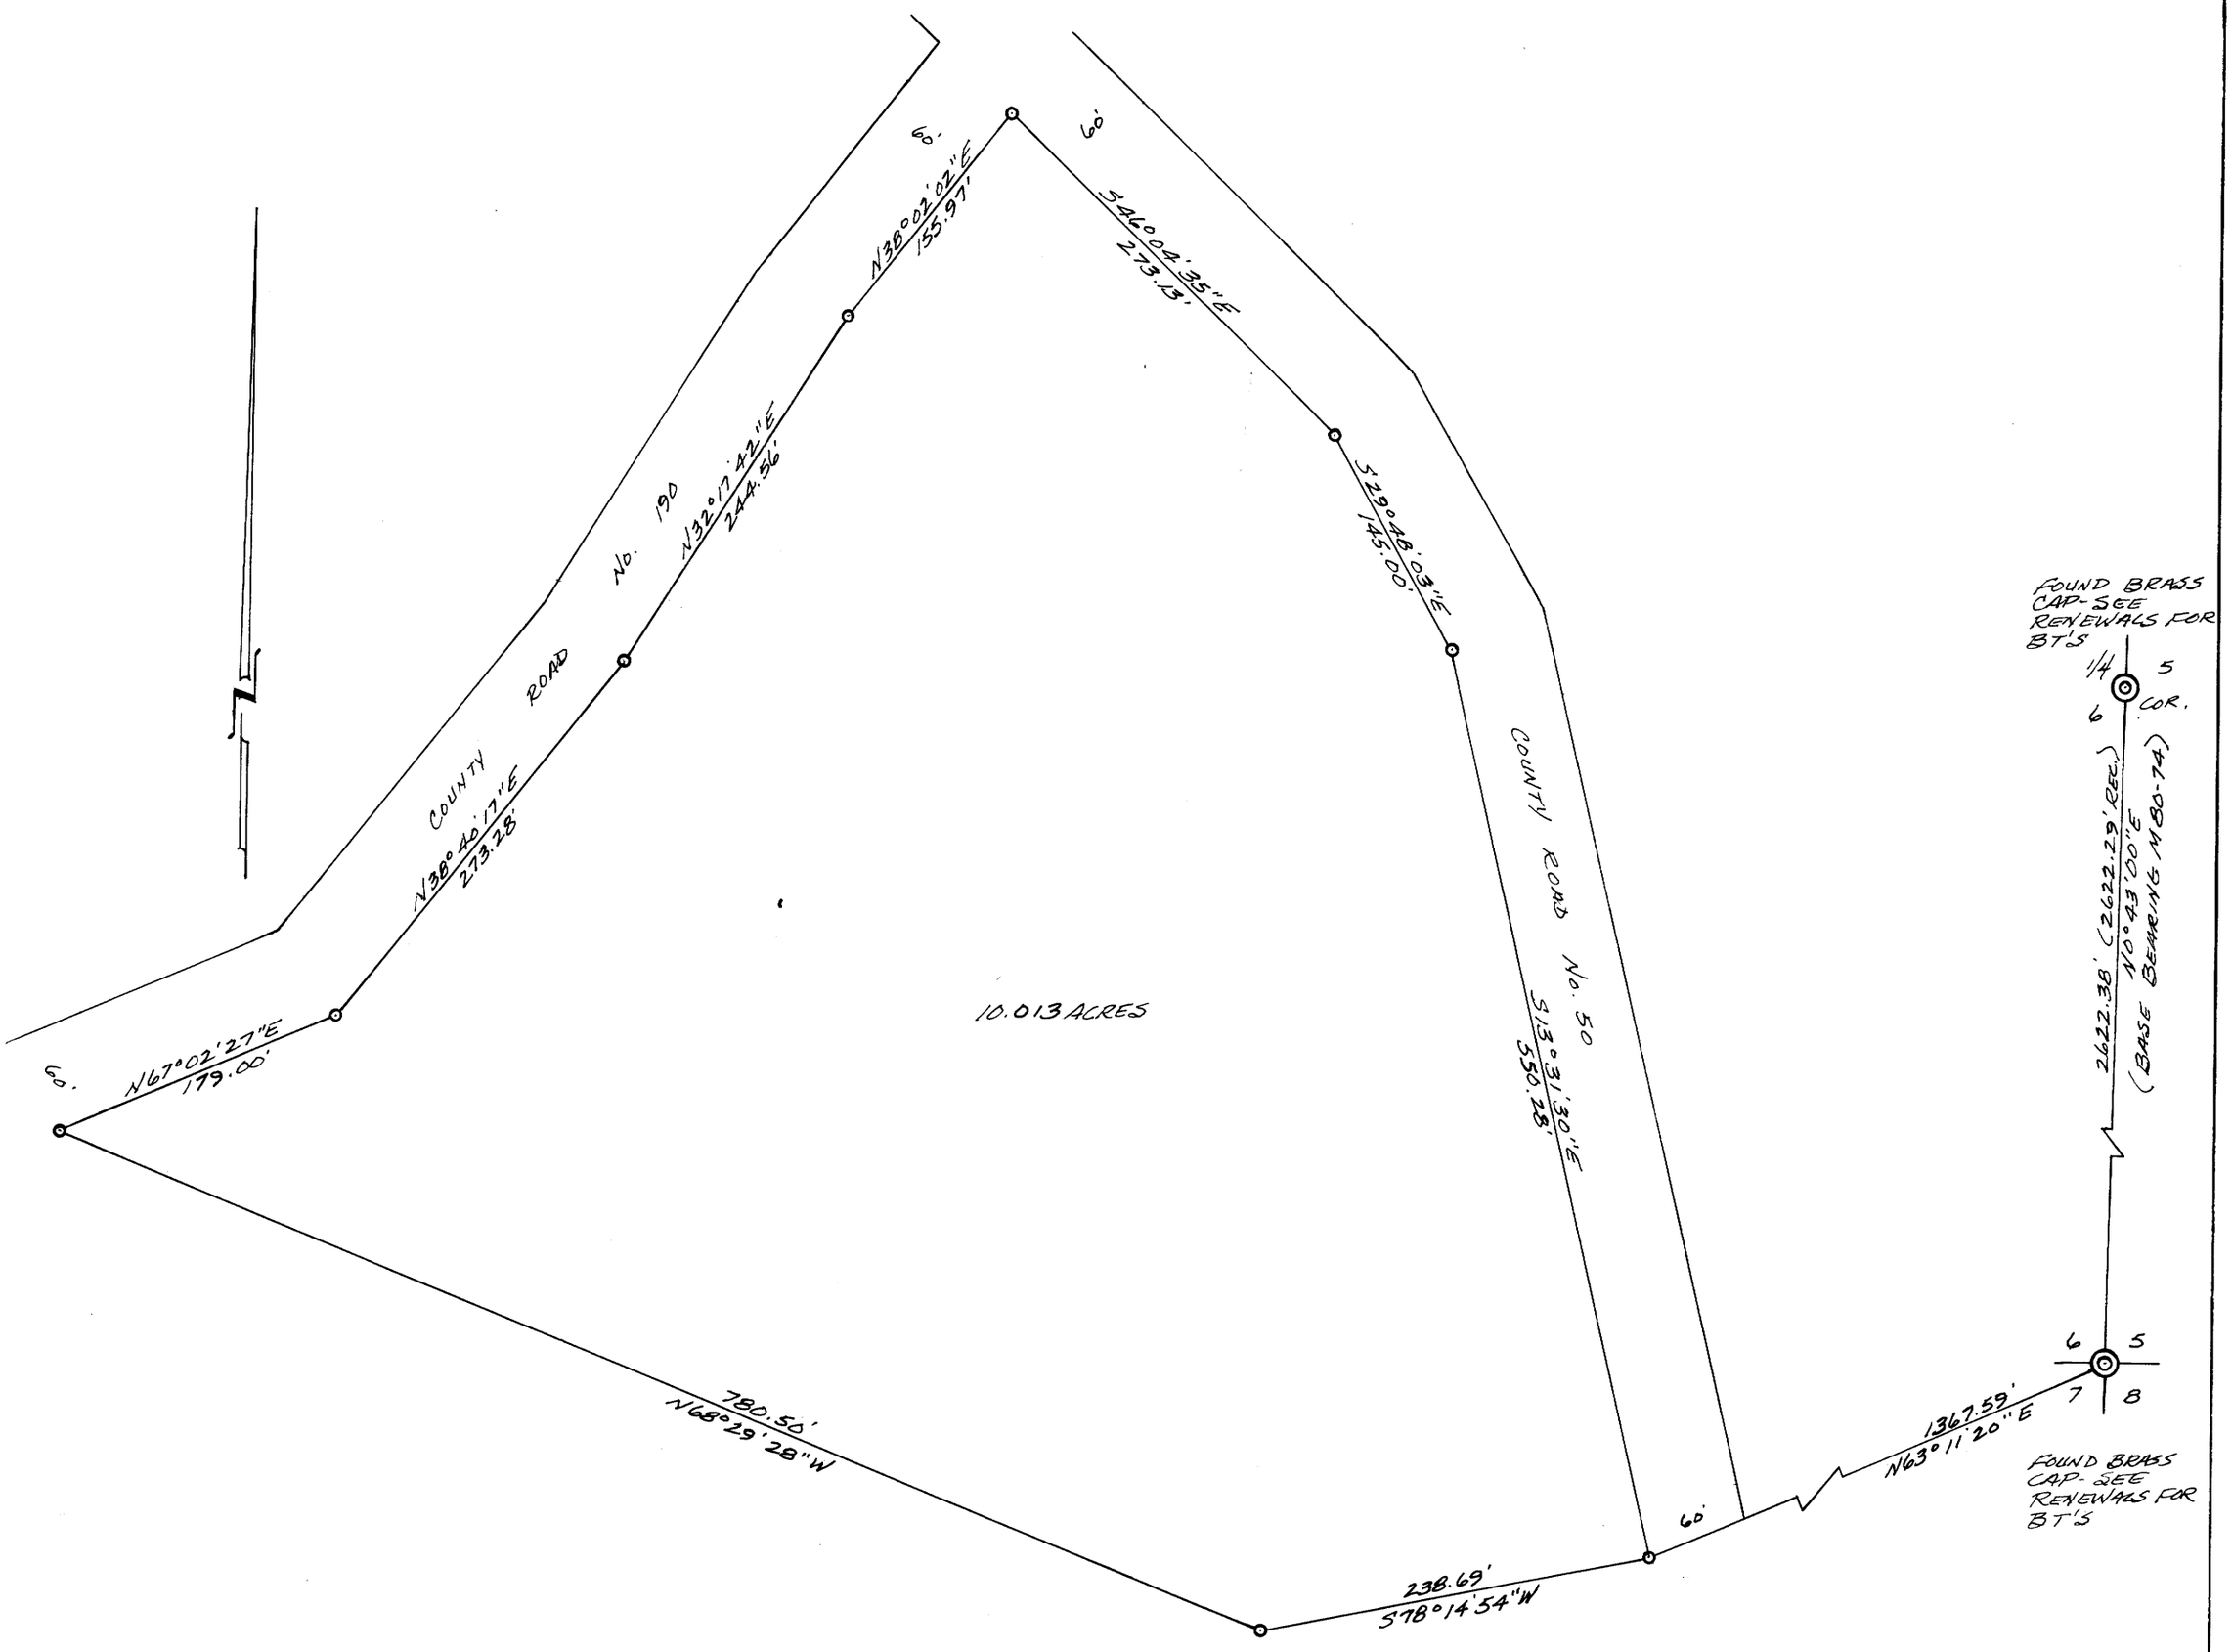

NOTE: All angles were turned with a 20" kern theodolite and all distances were measured with a 300' steel chain and a H-P Distance meter. The monumentation along the county road right of way was established by splitting the existing road bed.

Landline Development Co.
PO Box 2191
Roseburg, Oregon 97470

REGISTERED
OREGON
LAND SURVEYOR
Bruce R. Rogers
JULY 10, 1964
BRUCE R. ROGERS
660

MAP FILE M87-52