FILED BS
RECEIVED BS
MAY 19 1981
COUNTY SURVEYOR
DOUGLAS COUNTY, ORE.
BS

MAP FILE M 87-59

SURVEY OF
SECTION 20, T 21 S, R 7 W, W.M.
DOUGLAS COUNTY, OREGON
FOR
INTERNATIONAL PAPER COMPANY
BY
ROBERTS SURVEYING INC.
29 WEST 29TH STREET
EUGENE, OREGON 97405
APRIL 30, 1981

COUNTY SURVEYORS FILE DATA
DO NOT REMOVE FROM OFFICE

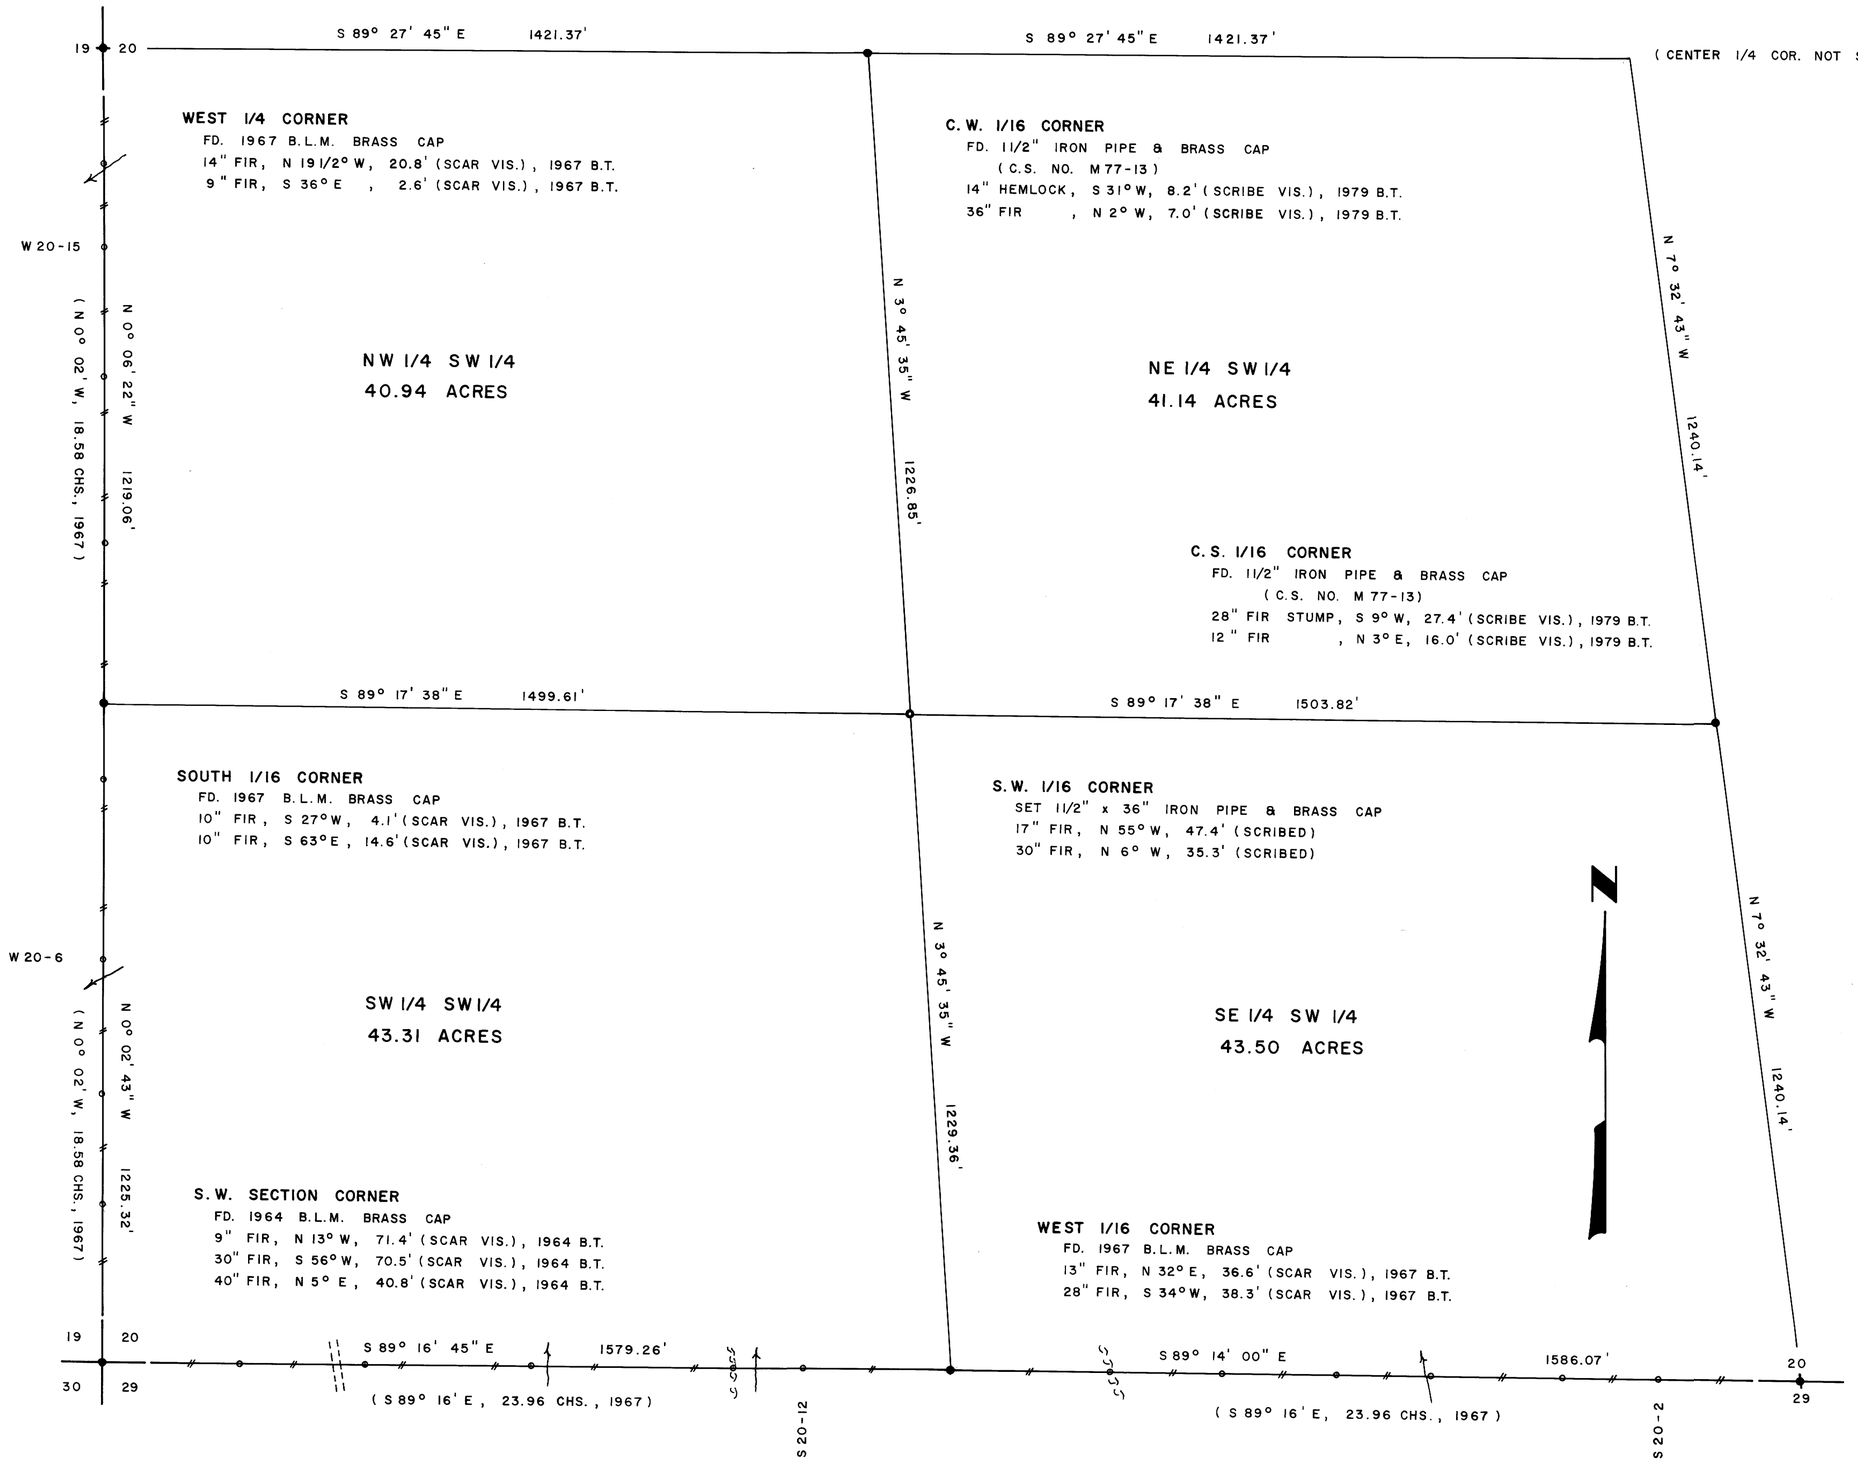

LOCATION OF 1/2" IRON RODS

S 1/4 COR.		
S 20-2	268'	WEST
S 20-3	444'	WEST
S 20-4	689'	WEST
S 20-5	864'	WEST
S 20-7	1080'	WEST
S 20-9	1287'	WEST
W 1/16 COR.	1586'	WEST
S 20-12	273'	WEST
S 20-14	403'	WEST
S 20-16	781'	WEST
S 20-18	1091'	WEST
S 20-21	1325'	WEST
SEC. COR.	1579'	WEST
W 20-2	293'	NORTH
W 20-5	500'	NORTH
W 20-6	750'	NORTH
W 20-9	1084'	NORTH
S 1/16 COR.	1225'	NORTH
W 20-11	300'	NORTH
W 20-13	610'	NORTH
W 20-15	851'	NORTH
W 20-16	1004'	NORTH
W 1/4 COR.	1219'	NORTH

LEGEND

- ● CORNERS FOUND AND USED FOR CONTROL
- ○ CORNERS SET
- LINES MARKED WITH RED PAINTED BLAZES, 1/2" x 60" IRON RODS AND RED RIBBON
- ( ) DATA OF RECORD

BASIS OF BEARING, SOLAR OBSERVATION

DISTANCE TO BEARING TREES ARE CENTER MEASURE

ALL BEARING TREES ARE SCRIBED

SCALE 1" = 200'

NARRATIVE

I, LESLIE ROBERTS, REGISTERED PROFESSIONAL LAND SURVEYOR DO CERTIFY THAT I HAVE CORRECTLY SURVEYED THE SW 1/4 OF SECTION 20 IN ACCORDANCE TO THE MANUAL OF INSTRUCTIONS FOR THE SURVEY OF THE PUBLIC LANDS OF THE UNITED STATES. THE S.W. 1/16 CORNER WAS SET AT THE INTERSECTION OF THE N-S AND E-W CENTER LINES OF SAID SW 1/4. A CLOSED MEANDER TRANSIT AND E.D.M. TRAVERSE WAS RUN AROUND THE SW 1/4 OF SECTION 20. OFFSETS WERE COMPUTED FROM THIS MEANDER TRAVERSE TO THE TRUE PROPERTY LINE.

SOUTH 1/4 CORNER

FD. 1964 B.L.M. BRASS CAP
30" FIR, N 30° E, 7.3' (SCAR VIS.), 1884 B.T.
4" FIR, S 72 3/4° E, 43.9' (SCAR VIS.), 1964 B.T.
16" FIR, N 44 1/2° E, 49.5' (SCAR VIS.), 1964 B.T.

Lea Roberts

M 87-59 MAP FILE