MAP FILE M82- -7

COUNTY SURVEYORS FILE DATA
DO NOT REMOVE FROM OFFICE

SURVEY TO SET PROPERTY CORNERS

IN THE

S. W. 1/4 SEC. 23, T. 27 S., R. 6 W., W. M.

DOUGLAS COUNTY, OREGON

MARCH 1981 SCALE: 1"=100'

FILED BS
RECEIVED
MAR 25 1981
COUNTY SURVEYOR
DOUGLAS COUNTY, ORE.
BS

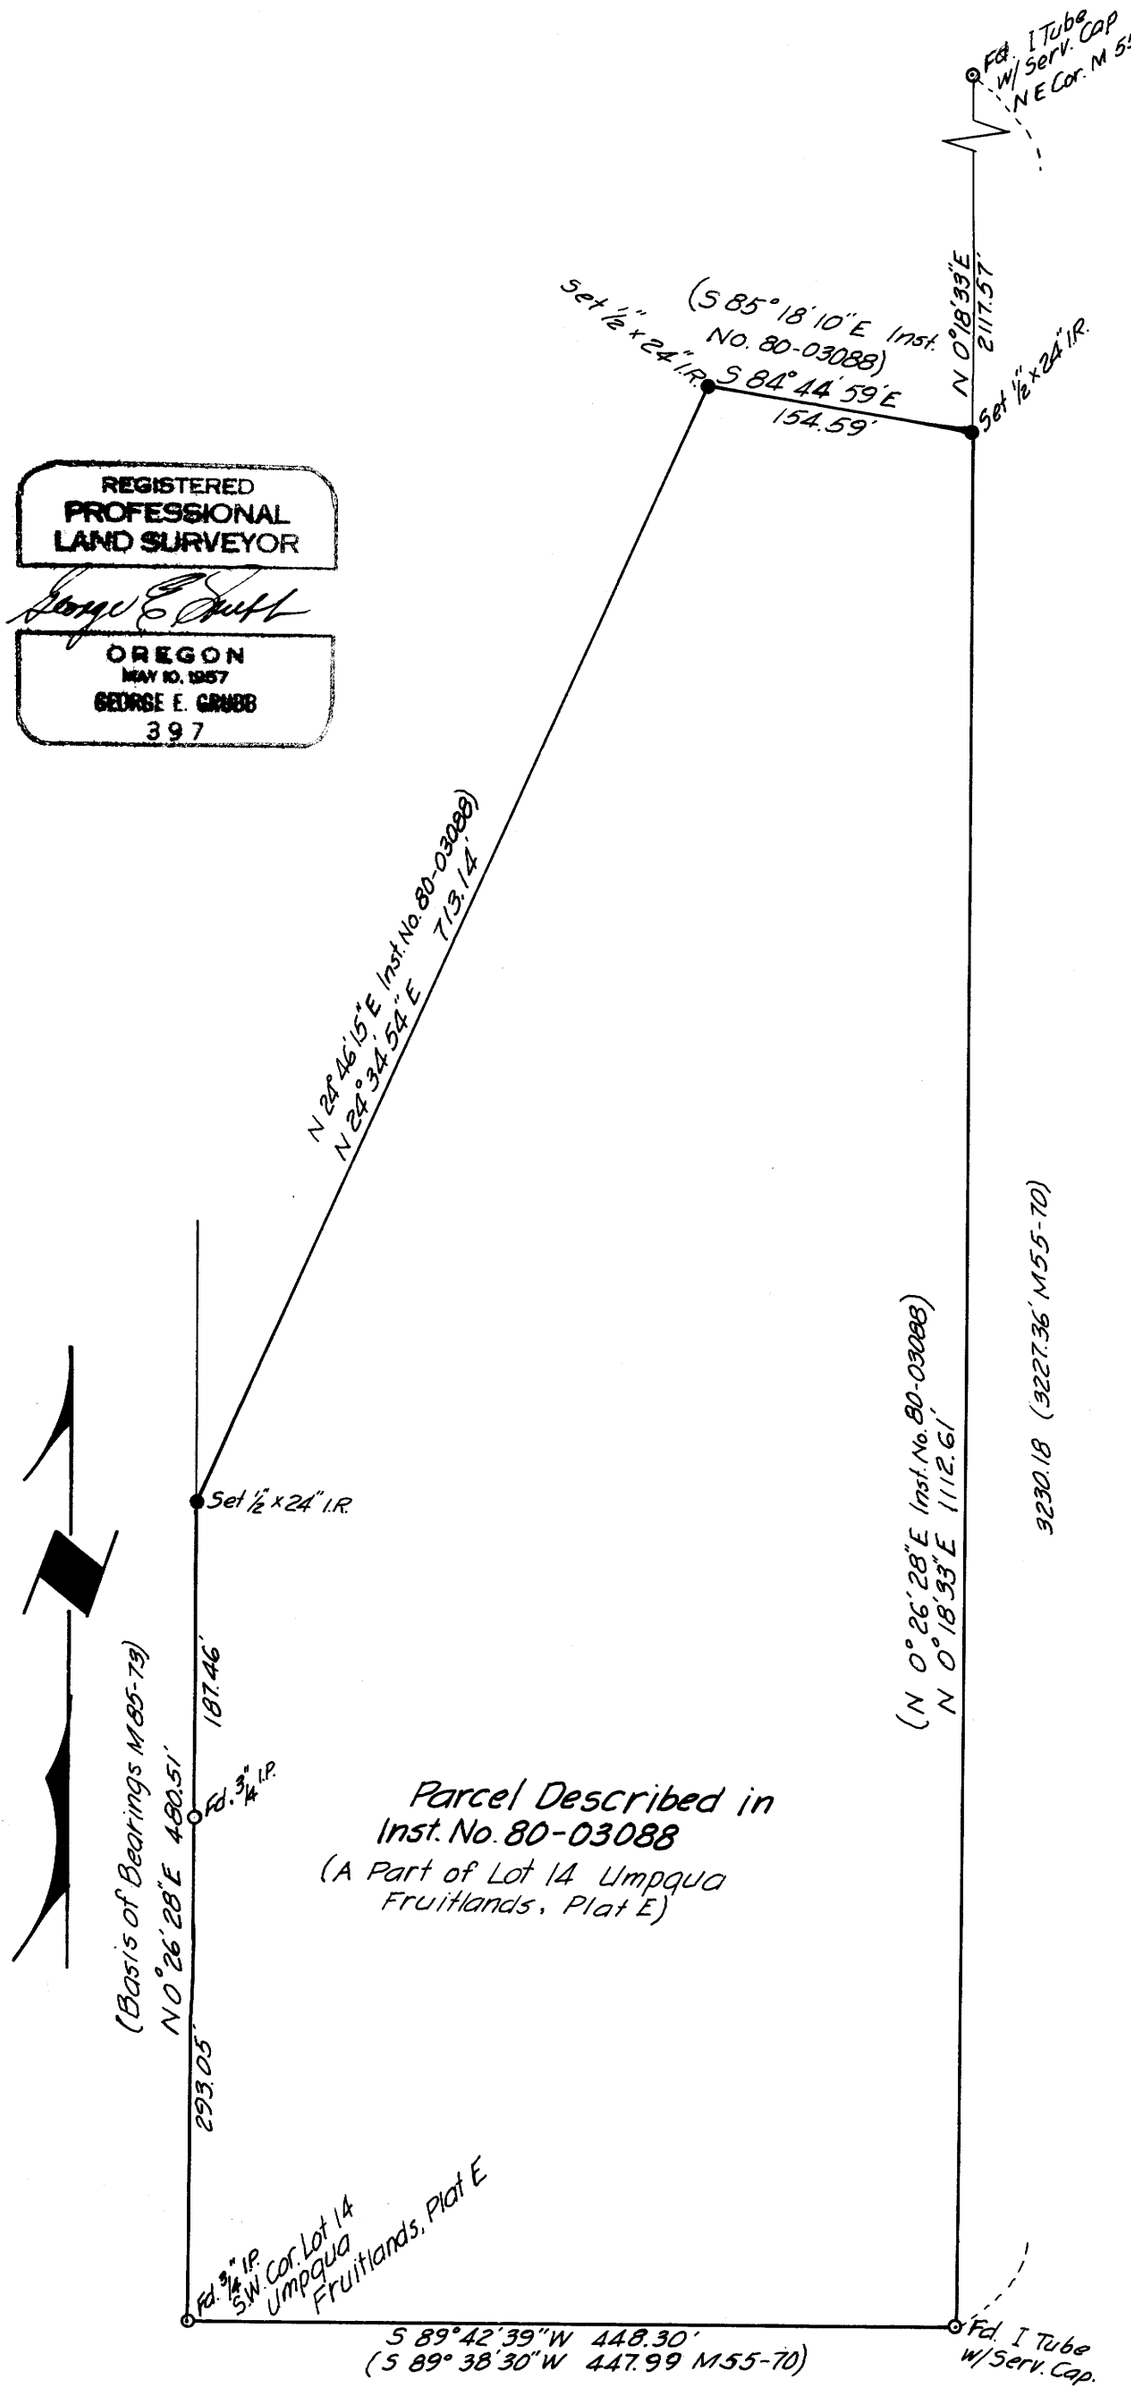

REGISTERED PROFESSIONAL LAND SURVEYOR
George E. Grubb
OREGON
MAY 10, 1957
GEORGE E. GRUBB
397

NARRATIVE:

THE SURVEY WAS PERFORMED TO SET MONUMENTS ON THE CORNERS OF THAT PROPERTY DESCRIBED IN INSTRUMENT NO. 80-03088, DOUGLAS COUNTY RECORDS. MONUMENTS WERE FOUND IN THE POSITIONS SHOWN. THE BOUNDARIES OF THE PROPERTY WERE DEFINED, HOLDING THOSE LINEAR DIMENSIONS GIVEN IN THE DEED. THE WORK WAS PERFORMED BY LESTER FANNING, CHIEF OF PARTY, WITH A WILD T1, HP 3805, AND 300 FOOT CHAIN.

SURVEY PERFORMED FOR:

COMM-TRONICS, INC.
PO BOX 1333
ROSEBURG, OREGON 97470

SURVEY BY:

BAUGHMAN TECHNICAL SERVICES, INC.
PO BOX 222
ROSEBURG, OREGON 97470

MAP FILE M82- -7