PROPERTY SURVEY

COUNTY SURVEYORS FILE DATA
DO NOT REMOVE FROM OFFICE

FILED
RECEIVED JRL
JUL 27 1981
COUNTY SURVEYOR
DOUGLAS COUNTY, ORE.

MAP FILE 88-25

IN

LOT 2, BLOCK 1, PLAT C, SUTHERLIN LAND & WATER CO.
IN THE NE 1/4 OF SEC. 20, T25S, R5W., W.M. DOUGLAS CO. OREGON

FOR BOB WILEY

BY ROBERT L. DOLAN
RT. 1 BOX 1820
SUTHERLIN, OREGON

NARRATIVE: PINS SET FROM EXISTING PINS & DEEDS USING THEODOLITE & EDM
ALL DIST. ARE IN FEET
PARCEL CUT OUT OF EXISTING LOTS

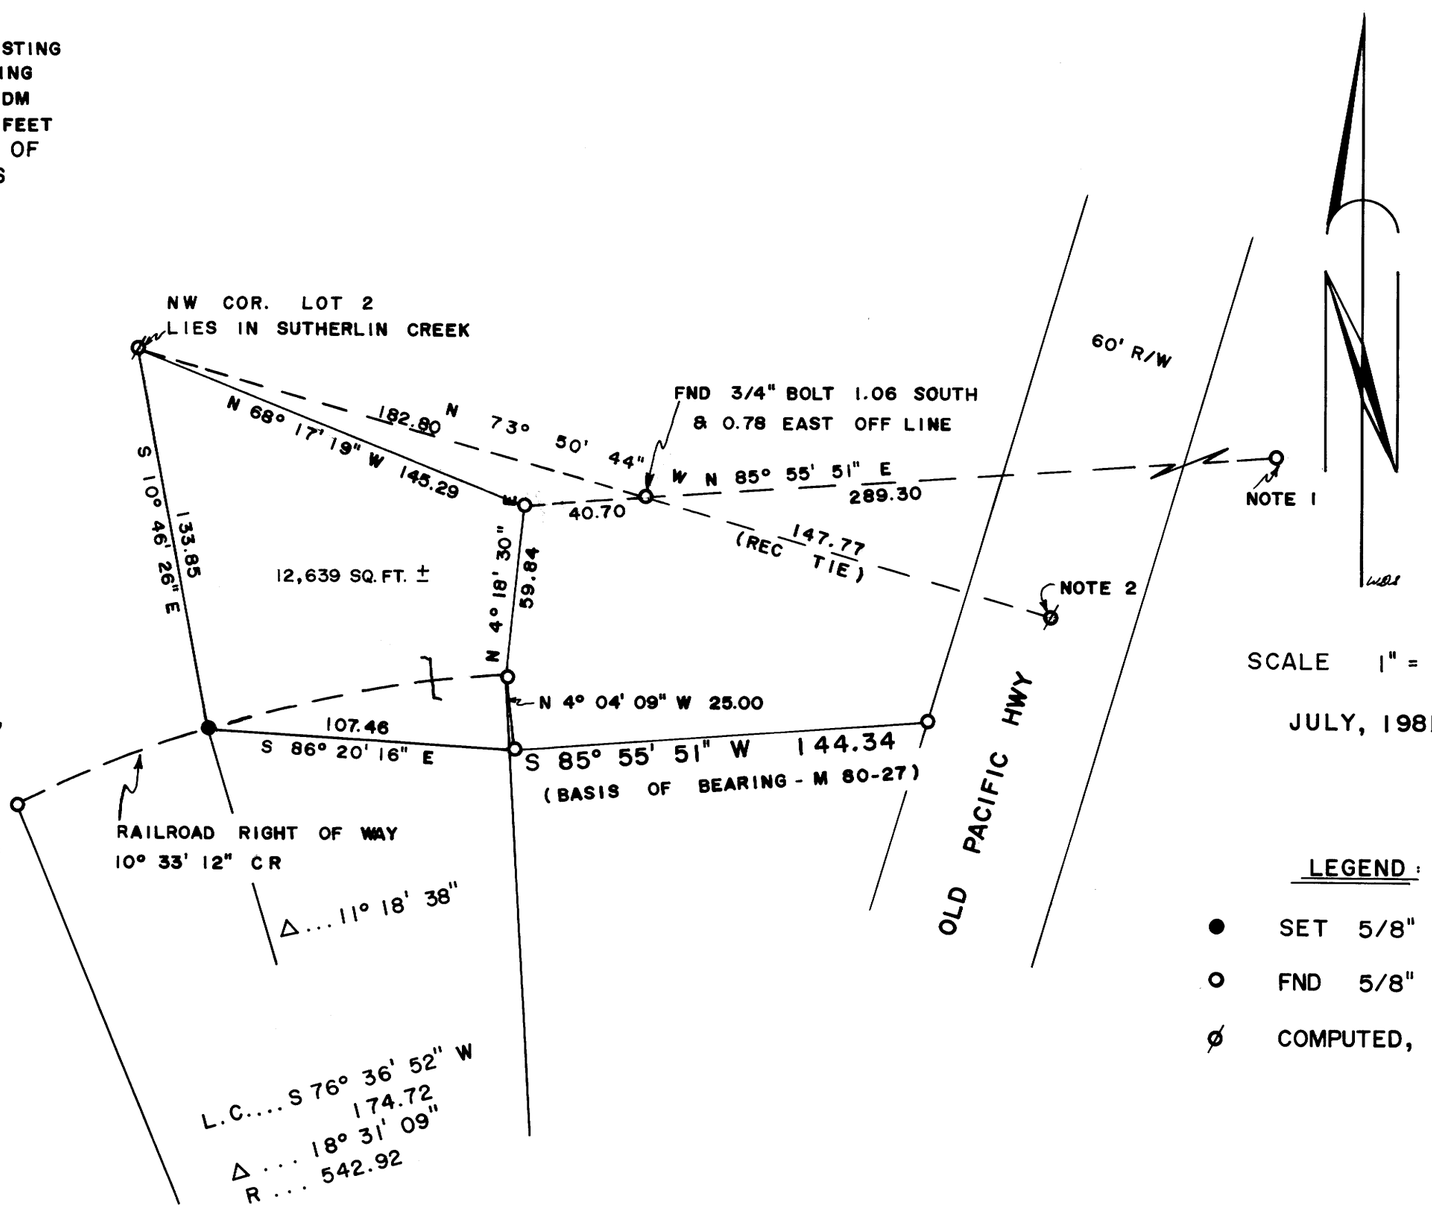

NOTES: 1 NW COR OF LOT 4, AZALEA CT.

2 NE COR LOT 2, BLOCK 1, PLAT C, S.L. & W. CO.

SCALE 1" = 50'

JULY, 1981

LEGEND:

- ● SET 5/8" IRON ROD (30")
- ○ FND 5/8" IRON ROD, EXCEPT AS NOTED
- ⌀ COMPUTED, NOT SET

REGISTERED PROFESSIONAL LAND SURVEYOR
OREGON
JULY 30, 1976
ROBERT L. DOLAN
1076

MAP FILE 88-25