COUNTY SURVEYORS FILE DATA
DO NOT REMOVE FROM OFFICE

FILED
RECEIVED
JUL 28 1981
COUNTY SURVEYOR
DOUGLAS COUNTY, ORE.

MAP FILE M88-26

SURVEY IN SE 1/4 OF SECTION 3, T27S, R6W, W.M.
& A PORTION LYING IN D.L.C. NO. 43

FOR: GARDEN VALLEY CHRISTIAN ASSEMBLY

BY: BHW ENGINEERING & SURVEYING, INC.
1205 S.E. COURT – ROSEBURG, OREGON 97470

SCALE: 1" = 100' JULY 1981

NARRATIVE:

SURVEY TO MONUMENT A DRAINFIELD EASEMENT.
BASE BEARING PER SURVEY M32-73.

FIELD CREW: G. LANG & D. DELATTE.
EQUIPMENT: LEITZ RED-1 E.D.M. MOUNTED ON WILD T-1 THEODOLITE.

COMPUTATIONS: R. WARE.
DRAFTING: D. HOPKINS.

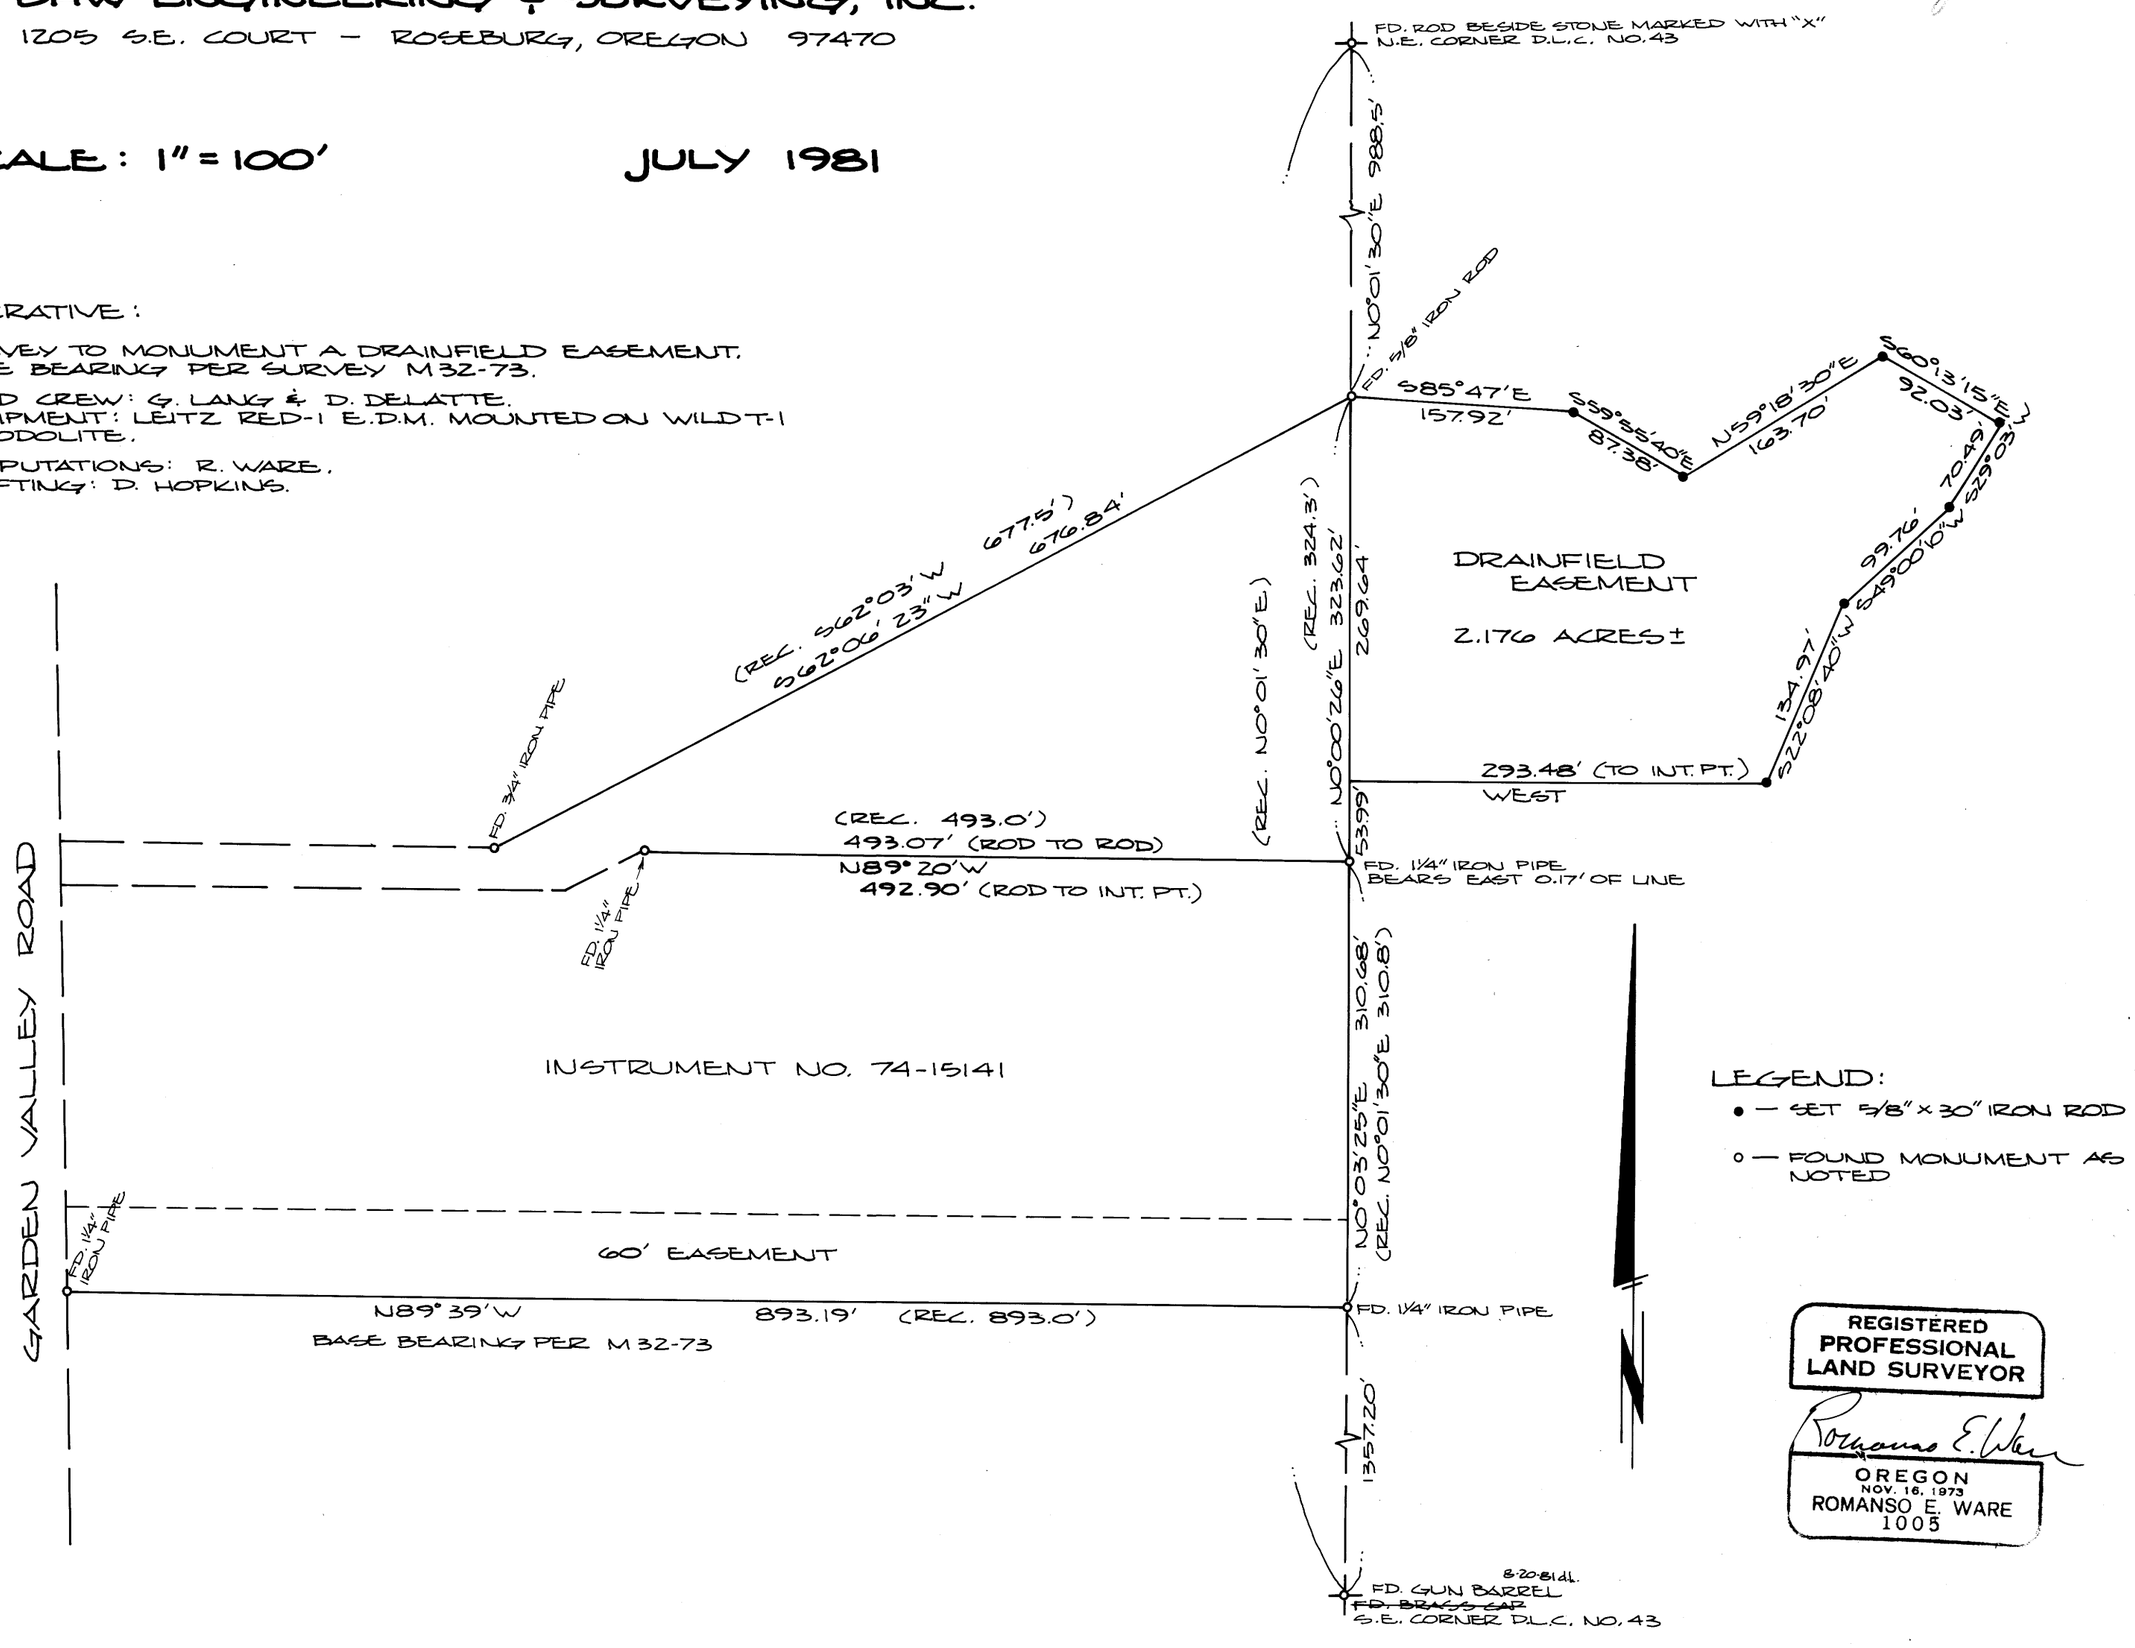

MAP FILE M88-26