COUNTY SURVEYORS FILE DATA
DO NOT REMOVE FROM OFFICE

FILED
RECEIVED
OCT 1 1981
COUNTY SURVEYOR
DOUGLAS COUNTY, ORE.

MAP FILE M89-114

SURVEY
FOR GEORGE GIBBY

LOT 17, BLOCK 2, "NORTH PARK ADDITION" IN SW1/4, SECTION 18, T27S, R5W, W.M.

BY: BHW ENGINEERING & SURVEYING, INC.
1205 S.E. COURT
ROSEBURG, OREGON

SCALE: 1" = 50'
JULY 1981

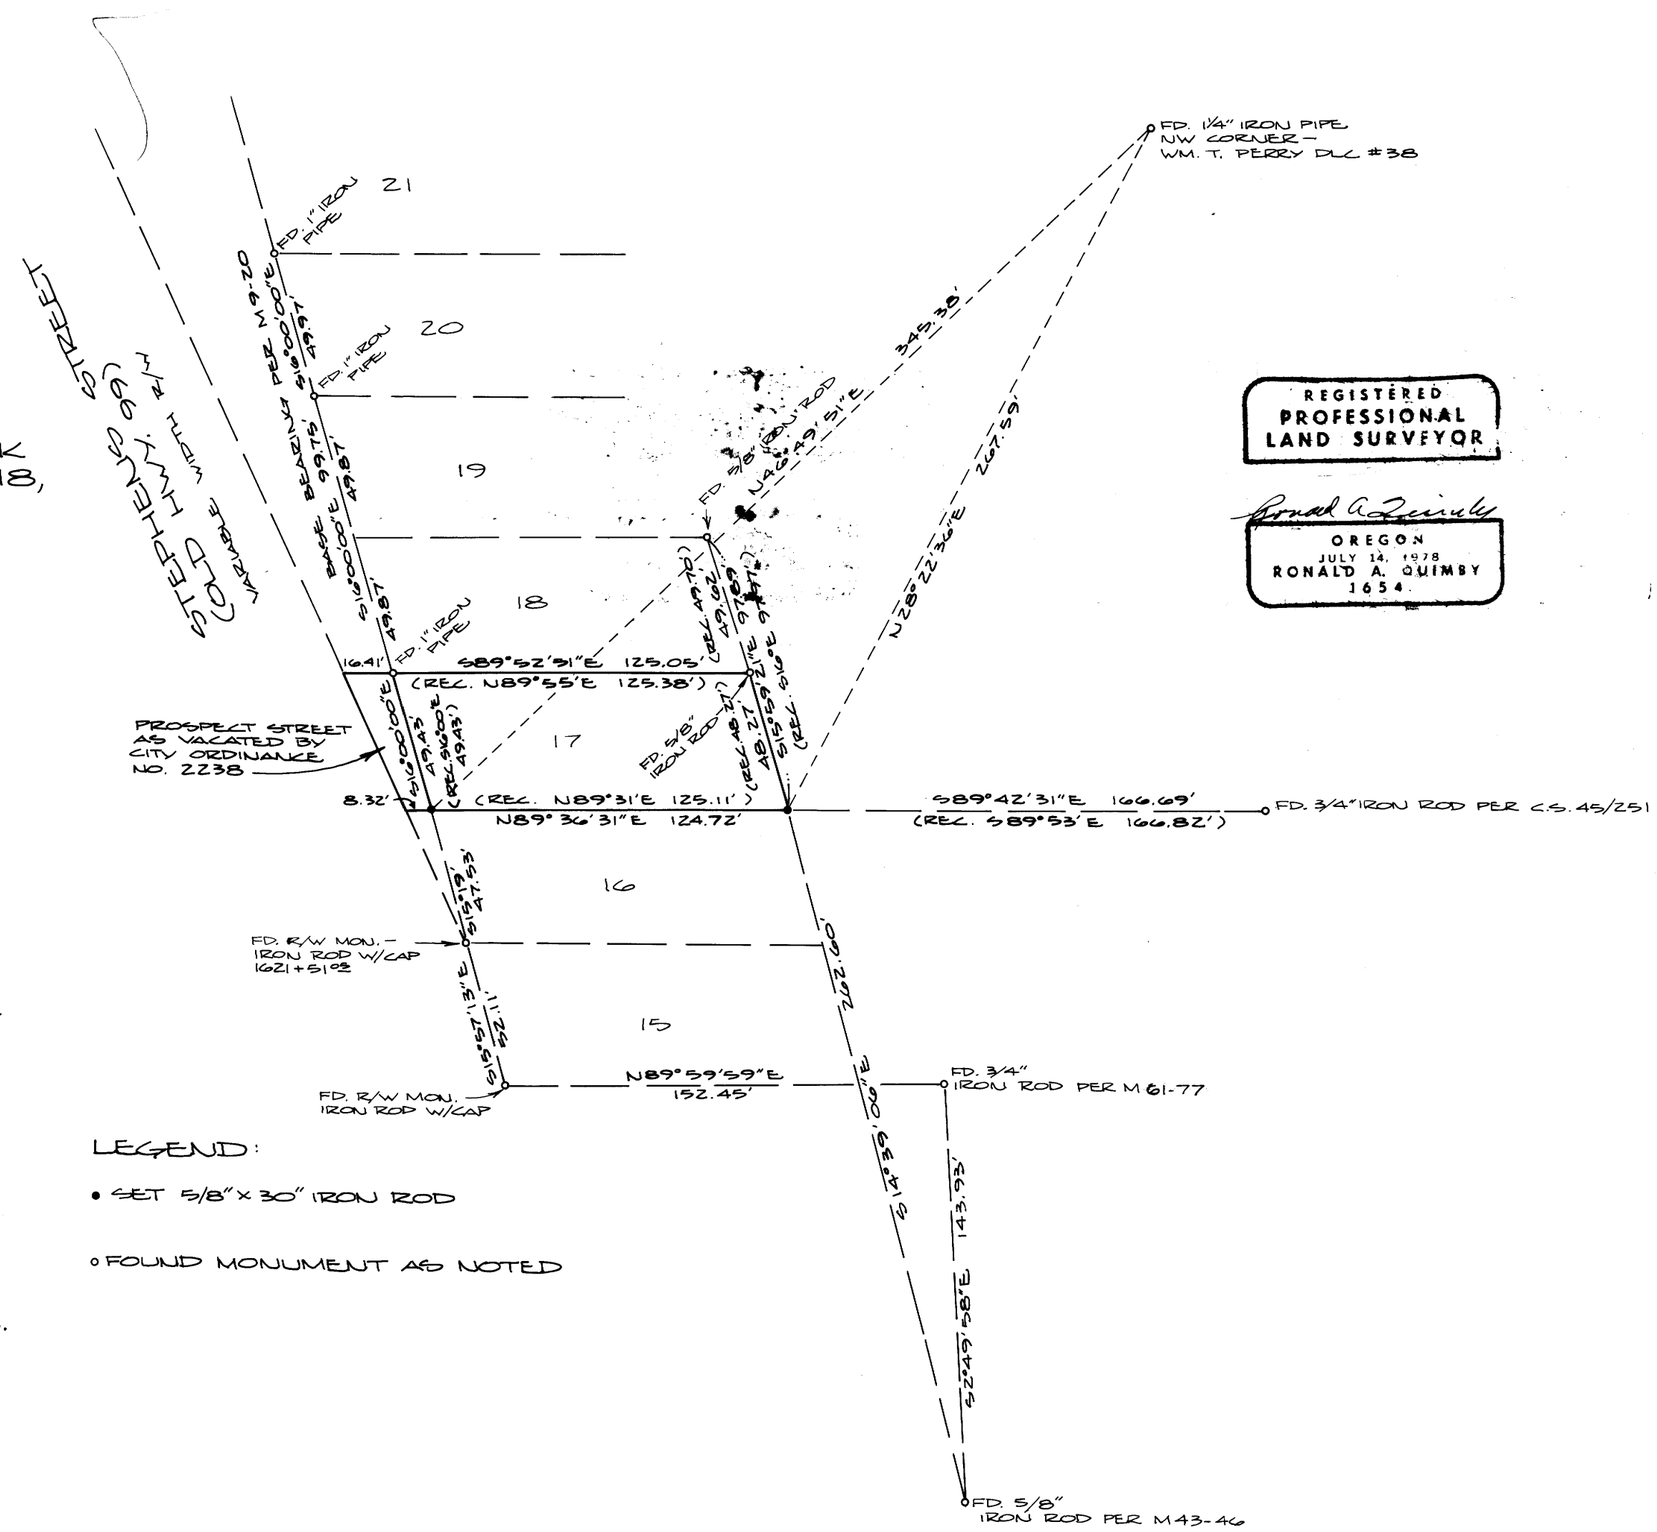

REGISTERED PROFESSIONAL LAND SURVEYOR
OREGON
JULY 14, 1978
RONALD A. QUIMBY
1654

NARRATIVE:

SURVEY TO ESTABLISH PROPERTY LINES OF LOT 17. ROAD CONTROL ESTABLISHED PER FOUND MONUMENTS. FIELD CREW: M. RADCLIFFE & G. LANG. COMPUTATIONS: R. QUIMBY. DRAFTING: D. HOPKINS. EQUIPMENT: WILD T-1 THEODOLITE MOUNTED WITH RED-1 E.D.M. REFERENCE SURVEYS: C.S. 45/251, M43-46, C.S. 40/349, C.S. 55/33.

LEGEND:

• SET 5/8" x 30" IRON ROD

○ FOUND MONUMENT AS NOTED

MAP FILE M89-114