COUNTY SURVEYORS FILE DATA
DO NOT REMOVE FROM OFFICE

FILED
RECEIVED
OCT 27 1981
COUNTY SURVEYOR
DOUGLAS COUNTY, ORE.

MAP FILE M89-28

SURVEY OF SEC. 26, T26S, R2W, W.M.

SURVEYED FOR: CHAMPION INTERNATIONAL CORPORATION
SURVEYED BY: T. E. SHRUM, JR. P.L.S. 1706

DATE: 9-15-1981 SCALE: 1" = 500'

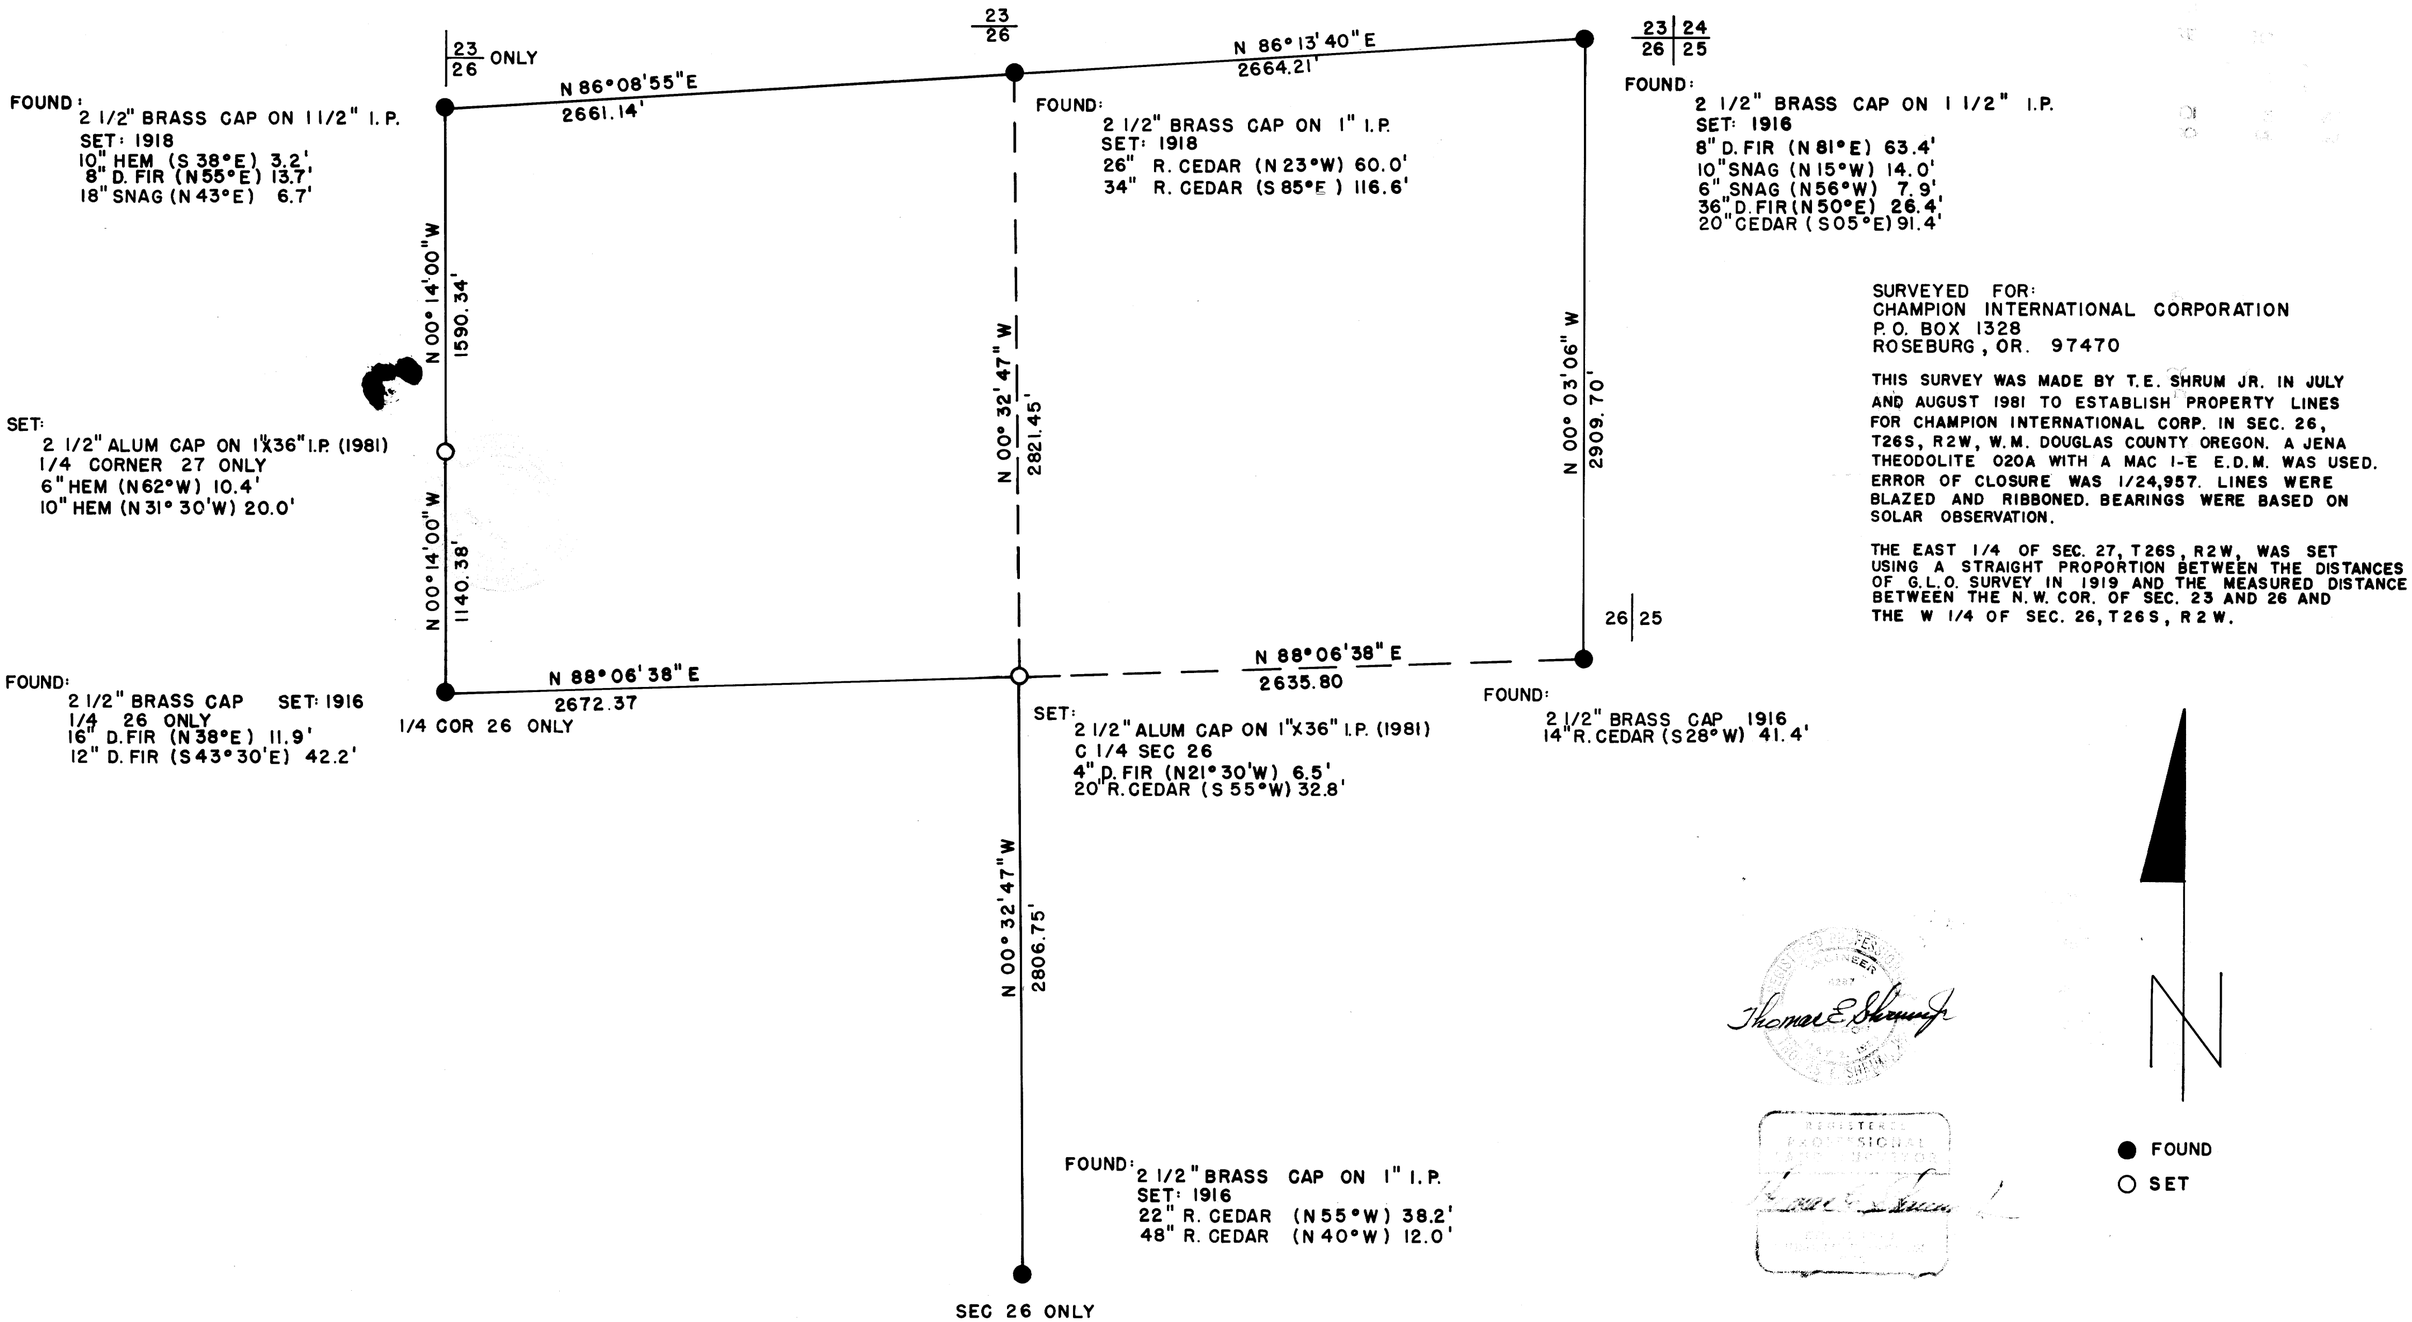

SURVEYED FOR:
CHAMPION INTERNATIONAL CORPORATION
P.O. BOX 1328
ROSEBURG, OR. 97470

THIS SURVEY WAS MADE BY T.E. SHRUM JR. IN JULY AND AUGUST 1981 TO ESTABLISH PROPERTY LINES FOR CHAMPION INTERNATIONAL CORP. IN SEC. 26, T26S, R2W, W.M. DOUGLAS COUNTY OREGON. A JENA THEODOLITE 020A WITH A MAC I-E E.D.M. WAS USED. ERROR OF CLOSURE WAS 1/24,957. LINES WERE BLAZED AND RIBBONED. BEARINGS WERE BASED ON SOLAR OBSERVATION.

THE EAST 1/4 OF SEC. 27, T26S, R2W, WAS SET USING A STRAIGHT PROPORTION BETWEEN THE DISTANCES OF G.L.O. SURVEY IN 1919 AND THE MEASURED DISTANCE BETWEEN THE N.W. COR. OF SEC. 23 AND 26 AND THE W 1/4 OF SEC. 26, T26S, R2W.

Thomas E. Shrum Jr.

REGISTERED PROFESSIONAL ENGINEER

MAP FILE M82-28