COUNTY SURVEYORS FILE DATA
DO NOT REMOVE FROM OFFICE

T. 22 S., R. 5 W., Sect. 8, NE¼

FILED
RECEIVED
JAN 11 1982
COUNTY SURVEYOR
DOUGLAS COUNTY, ORE.

Wilford N. Haines
RT. 38 Box 2
Drain, Oreg. 97435
Phone 836-2303

MAP FILE M 82-77

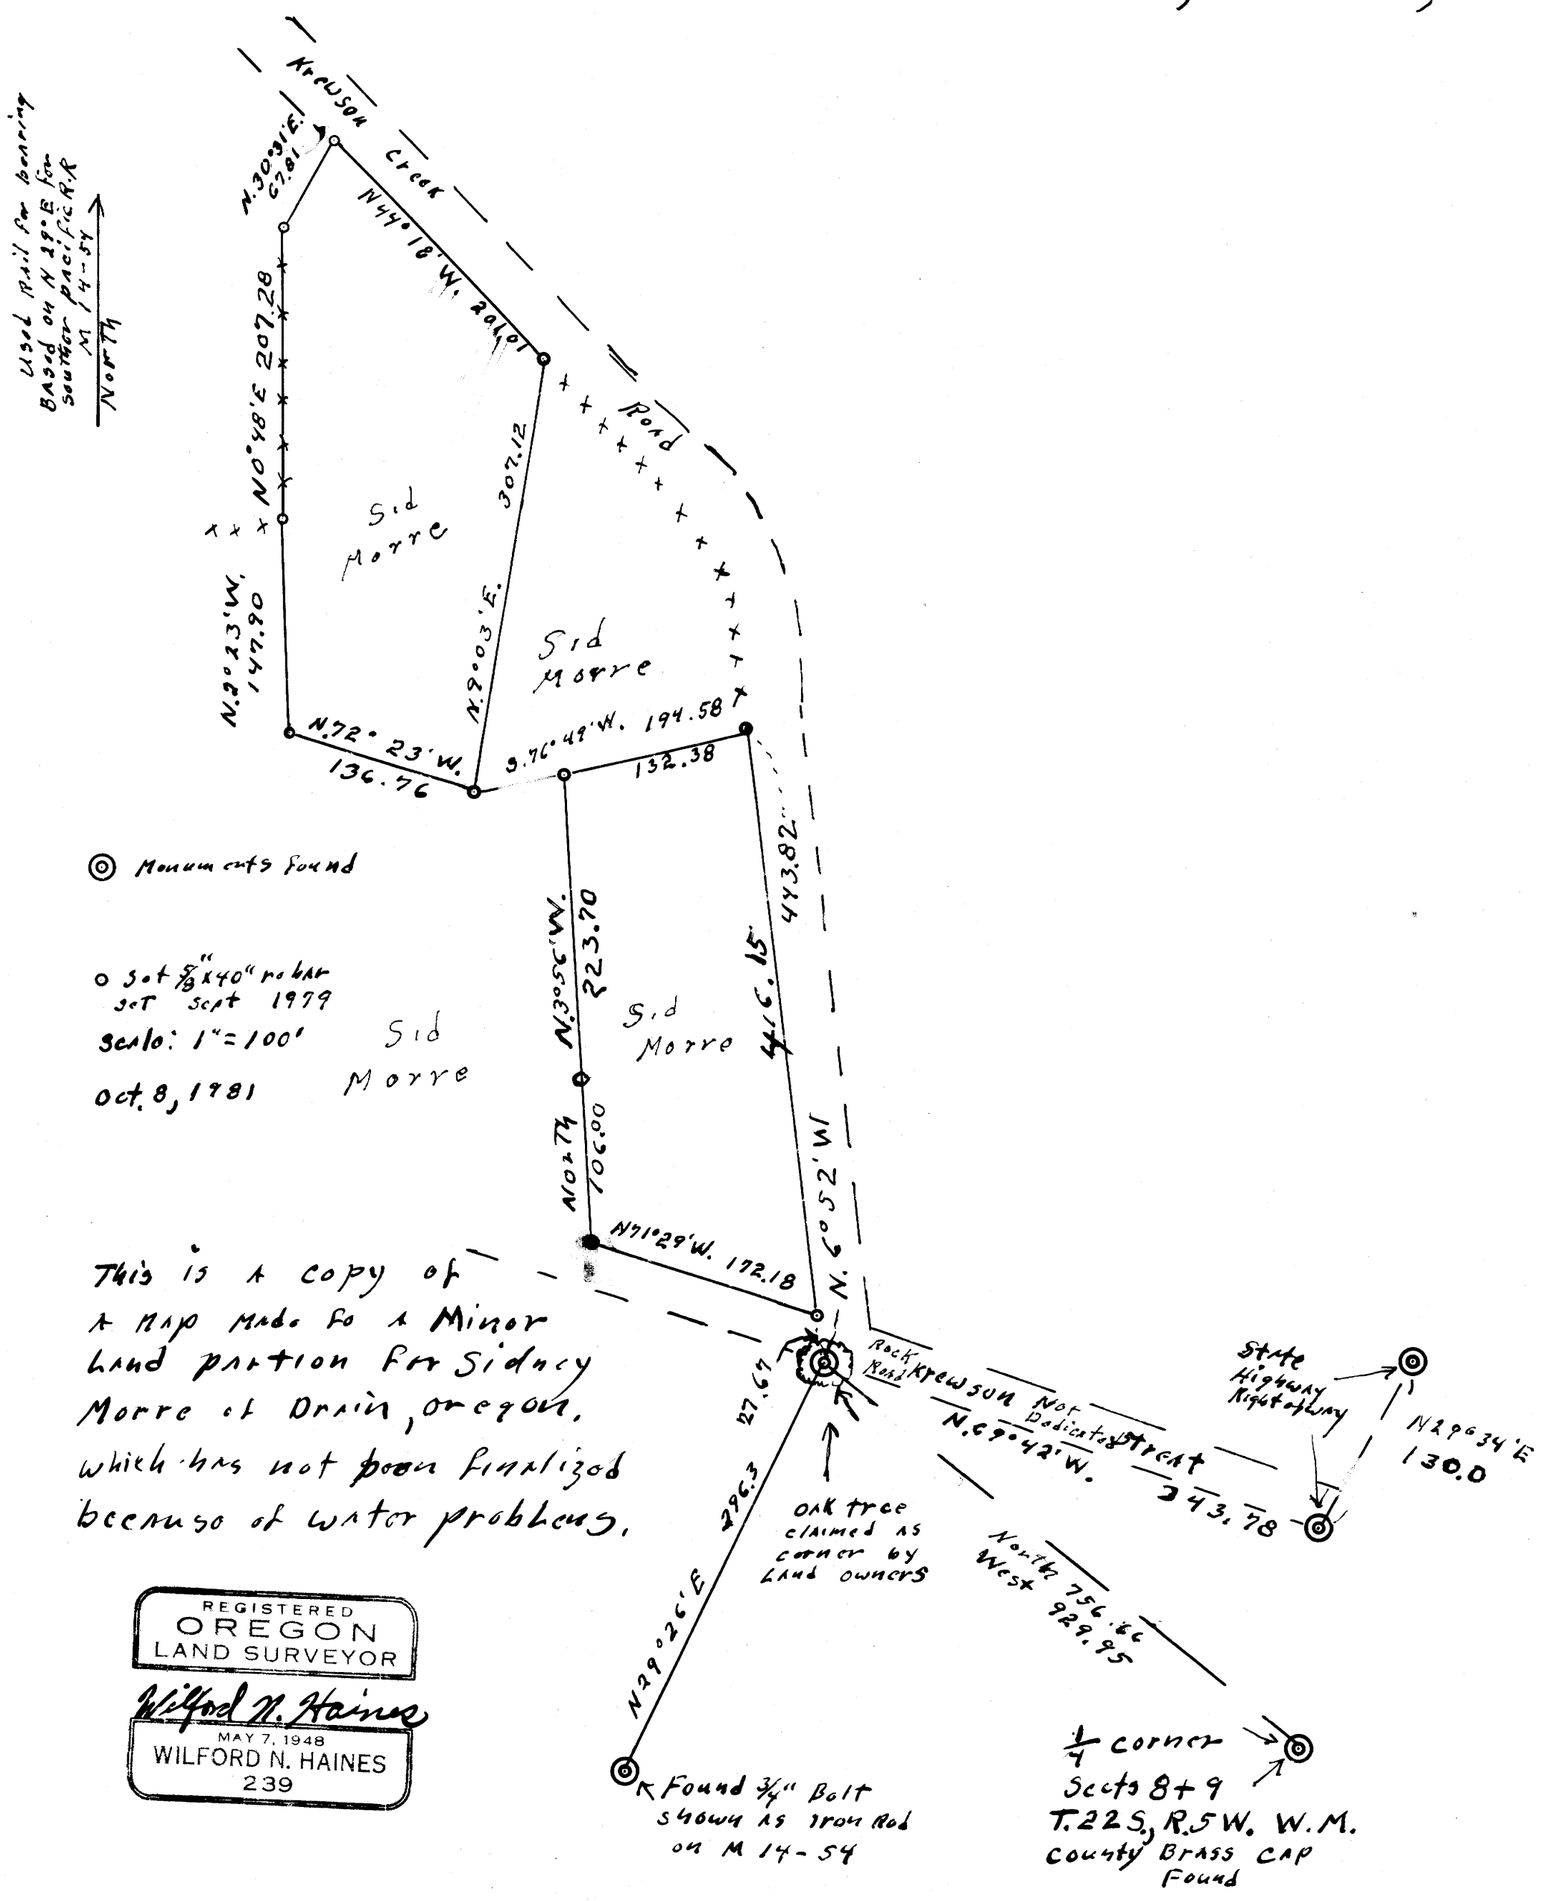

REGISTERED
OREGON
LAND SURVEYOR
Wilford N. Haines
MAY 7, 1948
WILFORD N. HAINES
239

MAP FILE M 82-77