T.E - 06 W

SURVEY IN SECTION 13, T27S, R7W, W.M. (SOUTH 1/2 SECTION 13)

FOR HAROLD & JILL ANDERSON
BY ROMANSO (ROMEY) WARE

JAN., 1983 SCALE: 1" = 100'

- ● — FD. MONUMENT (AS NOTED)
- ○ — SET 5/8" IRON ROD W/ CAP MKD. "R.E. WARE - L.S. 1005" - 30" IN LENGTH.
- ◉ — A BRASS CAP

COUNTY SURVEYORS FILE DATA
DO NOT REMOVE FROM OFFICE

FILED
RECEIVED
FEB 28 1983
COUNTY SURVEYOR
DOUGLAS COUNTY, ORE.

Narrative:

Survey to partition 3 parcels, as shown, of that property described in Instrument No. 77-18081 in the Deed Records of Douglas County. The west line of subject property was not surveyed and was projected per Survey M49-52 for the purpose to compute acreage, which is subject to any inaccuracies a survey may disclose. Bearings are based on Survey M49-52.

This filed survey for boundary line adjustment as originally approved P.B. File No. 78-170 (Douglas County Planning Comm.).

REGISTERED PROFESSIONAL LAND SURVEYOR
Romanso E. Ware
OREGON
NOV 16, 1978
ROMANSO E. WARE
1005

R.E. WARE
2771 N.W. GARDEN VALLEY
ROSEBURG, OREGON
97470

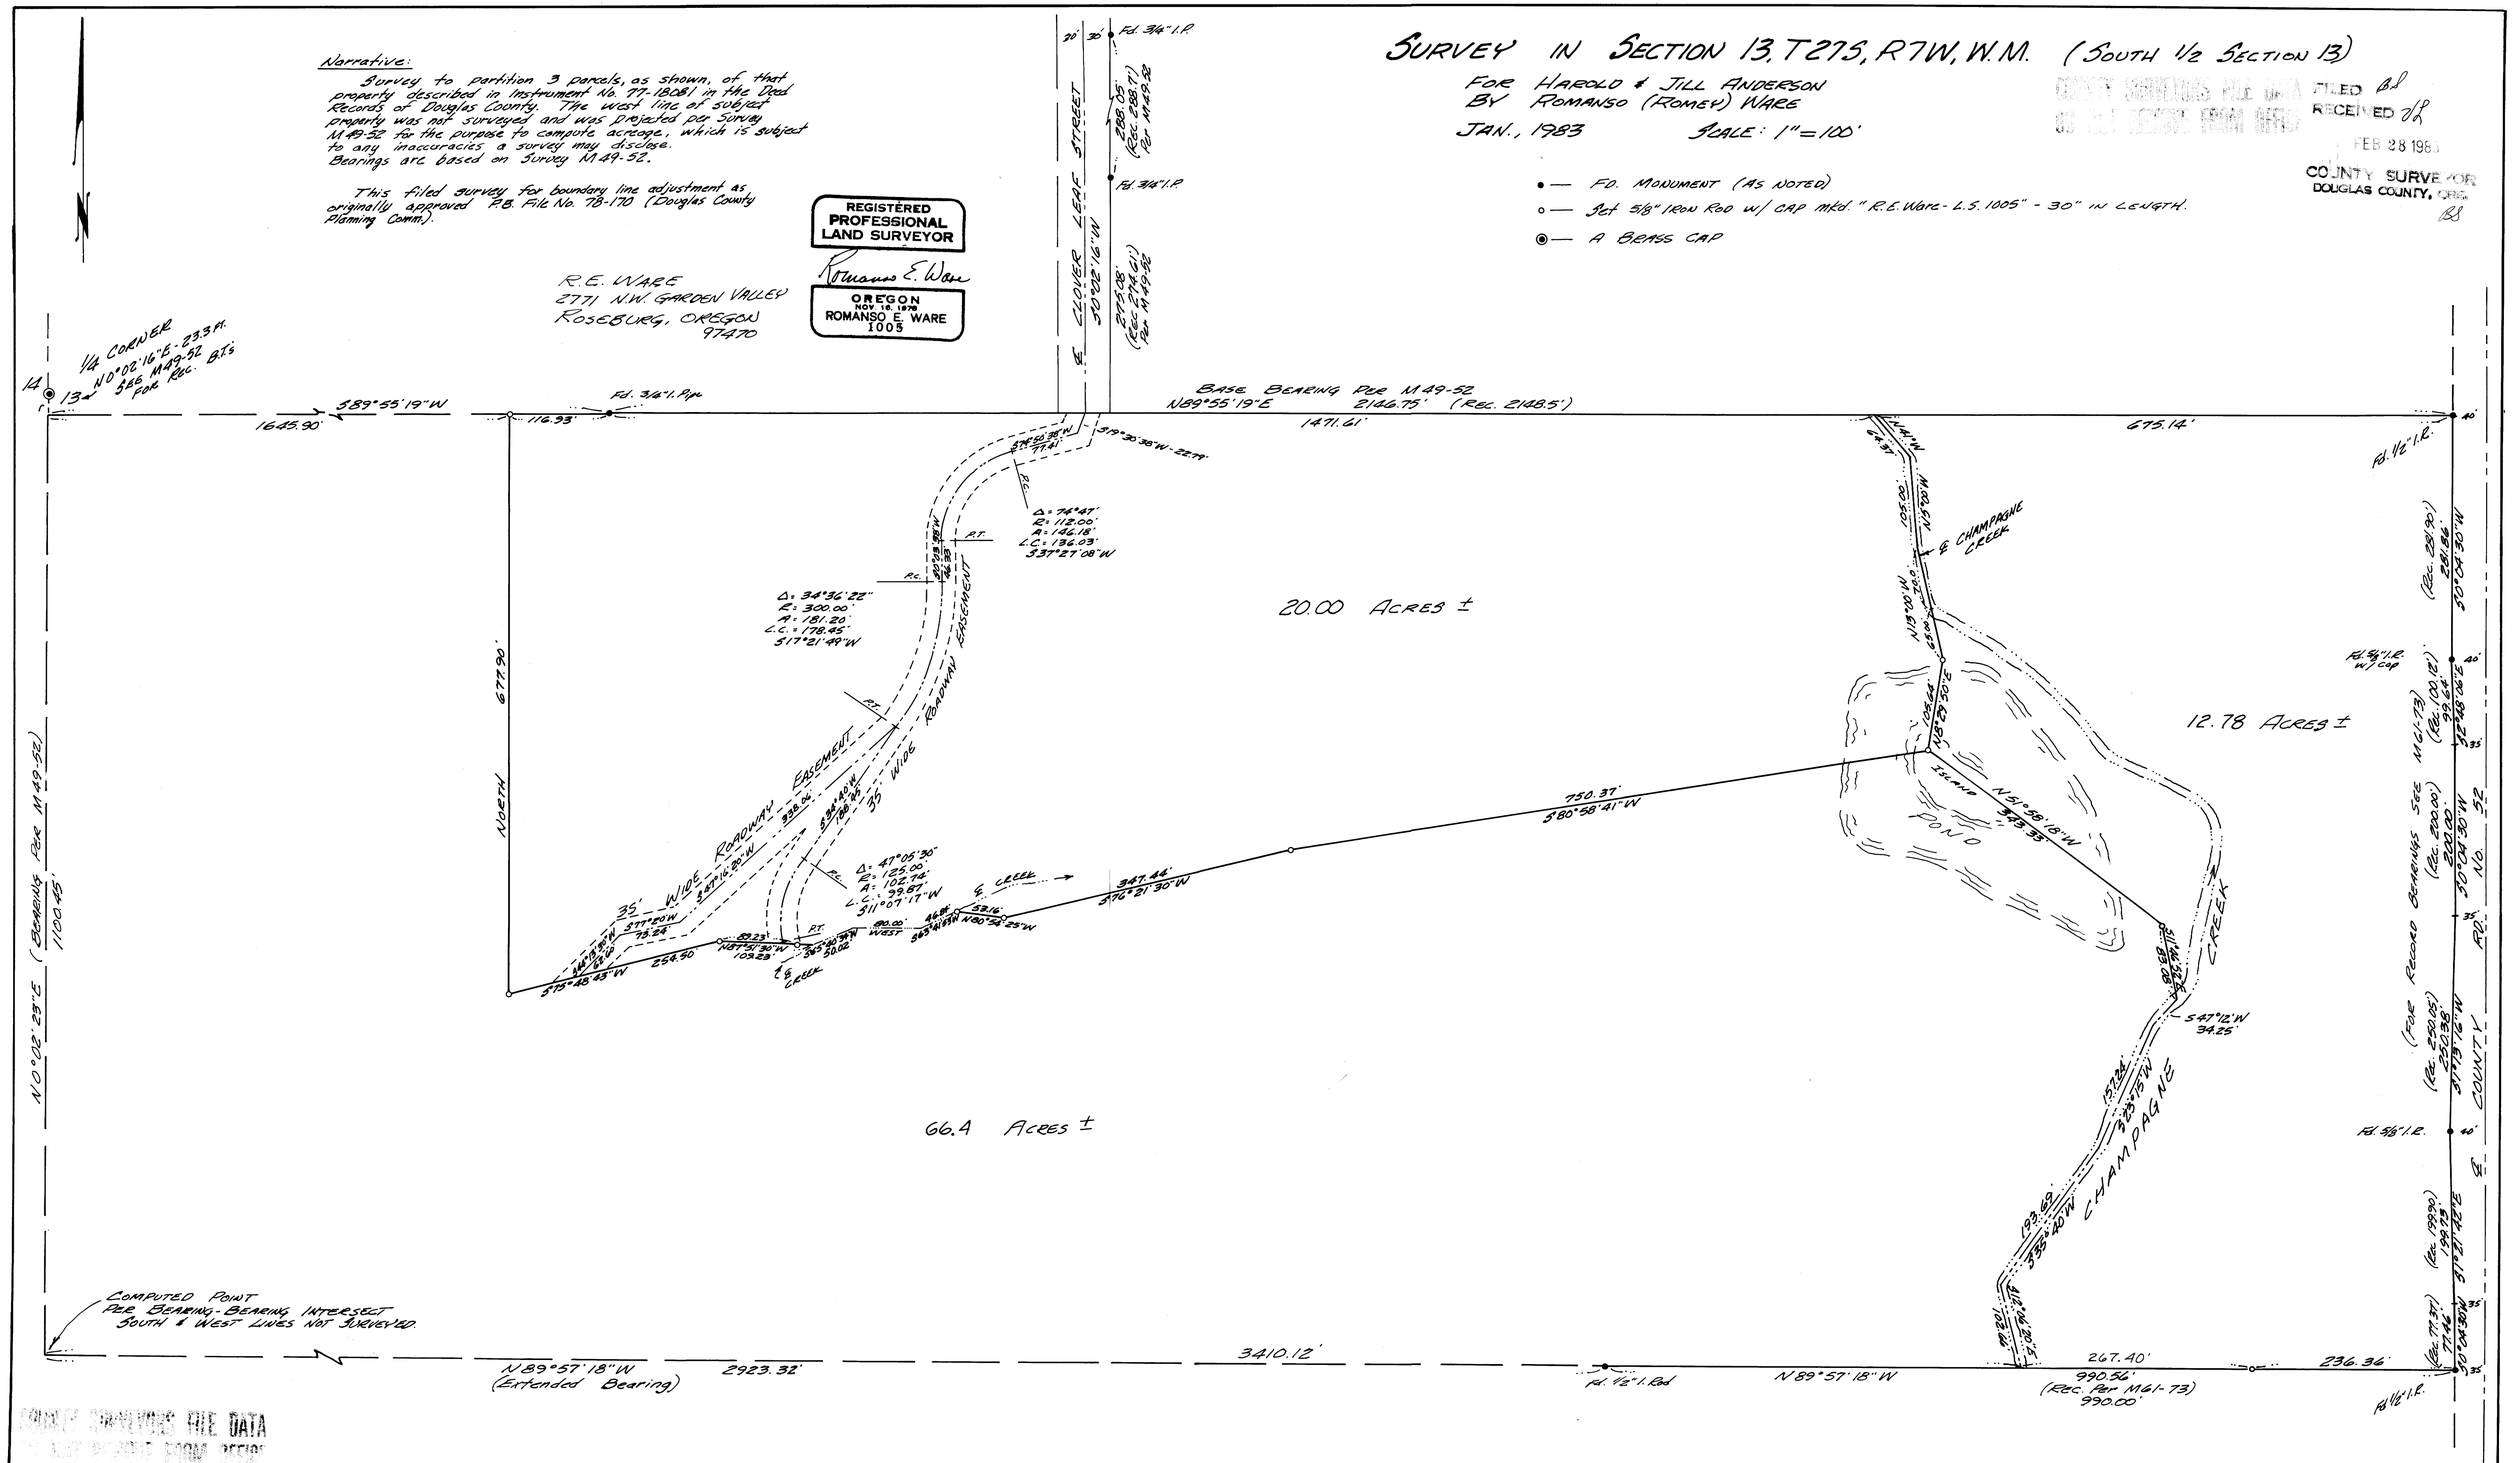

COUNTY SURVEYORS FILE DATA
DO NOT REMOVE FROM OFFICE

MAP FILE M 90-37