MAP FILE M 90-56
F.B. H-167

FILED
RECEIVED B.S
JUN 13 1984
COUNTY SURVEYOR
DOUGLAS COUNTY, ORE.
B.S

SE ¼ SECT. 5, T.23S. R.4W. W.M.

For

Donald Davis — Elkton, Oreg.

Scale 1" = 100'

Aug. 20, 1971

This drawing made 1984

survey to Re-establish Lost Corner in Rock Quarry site

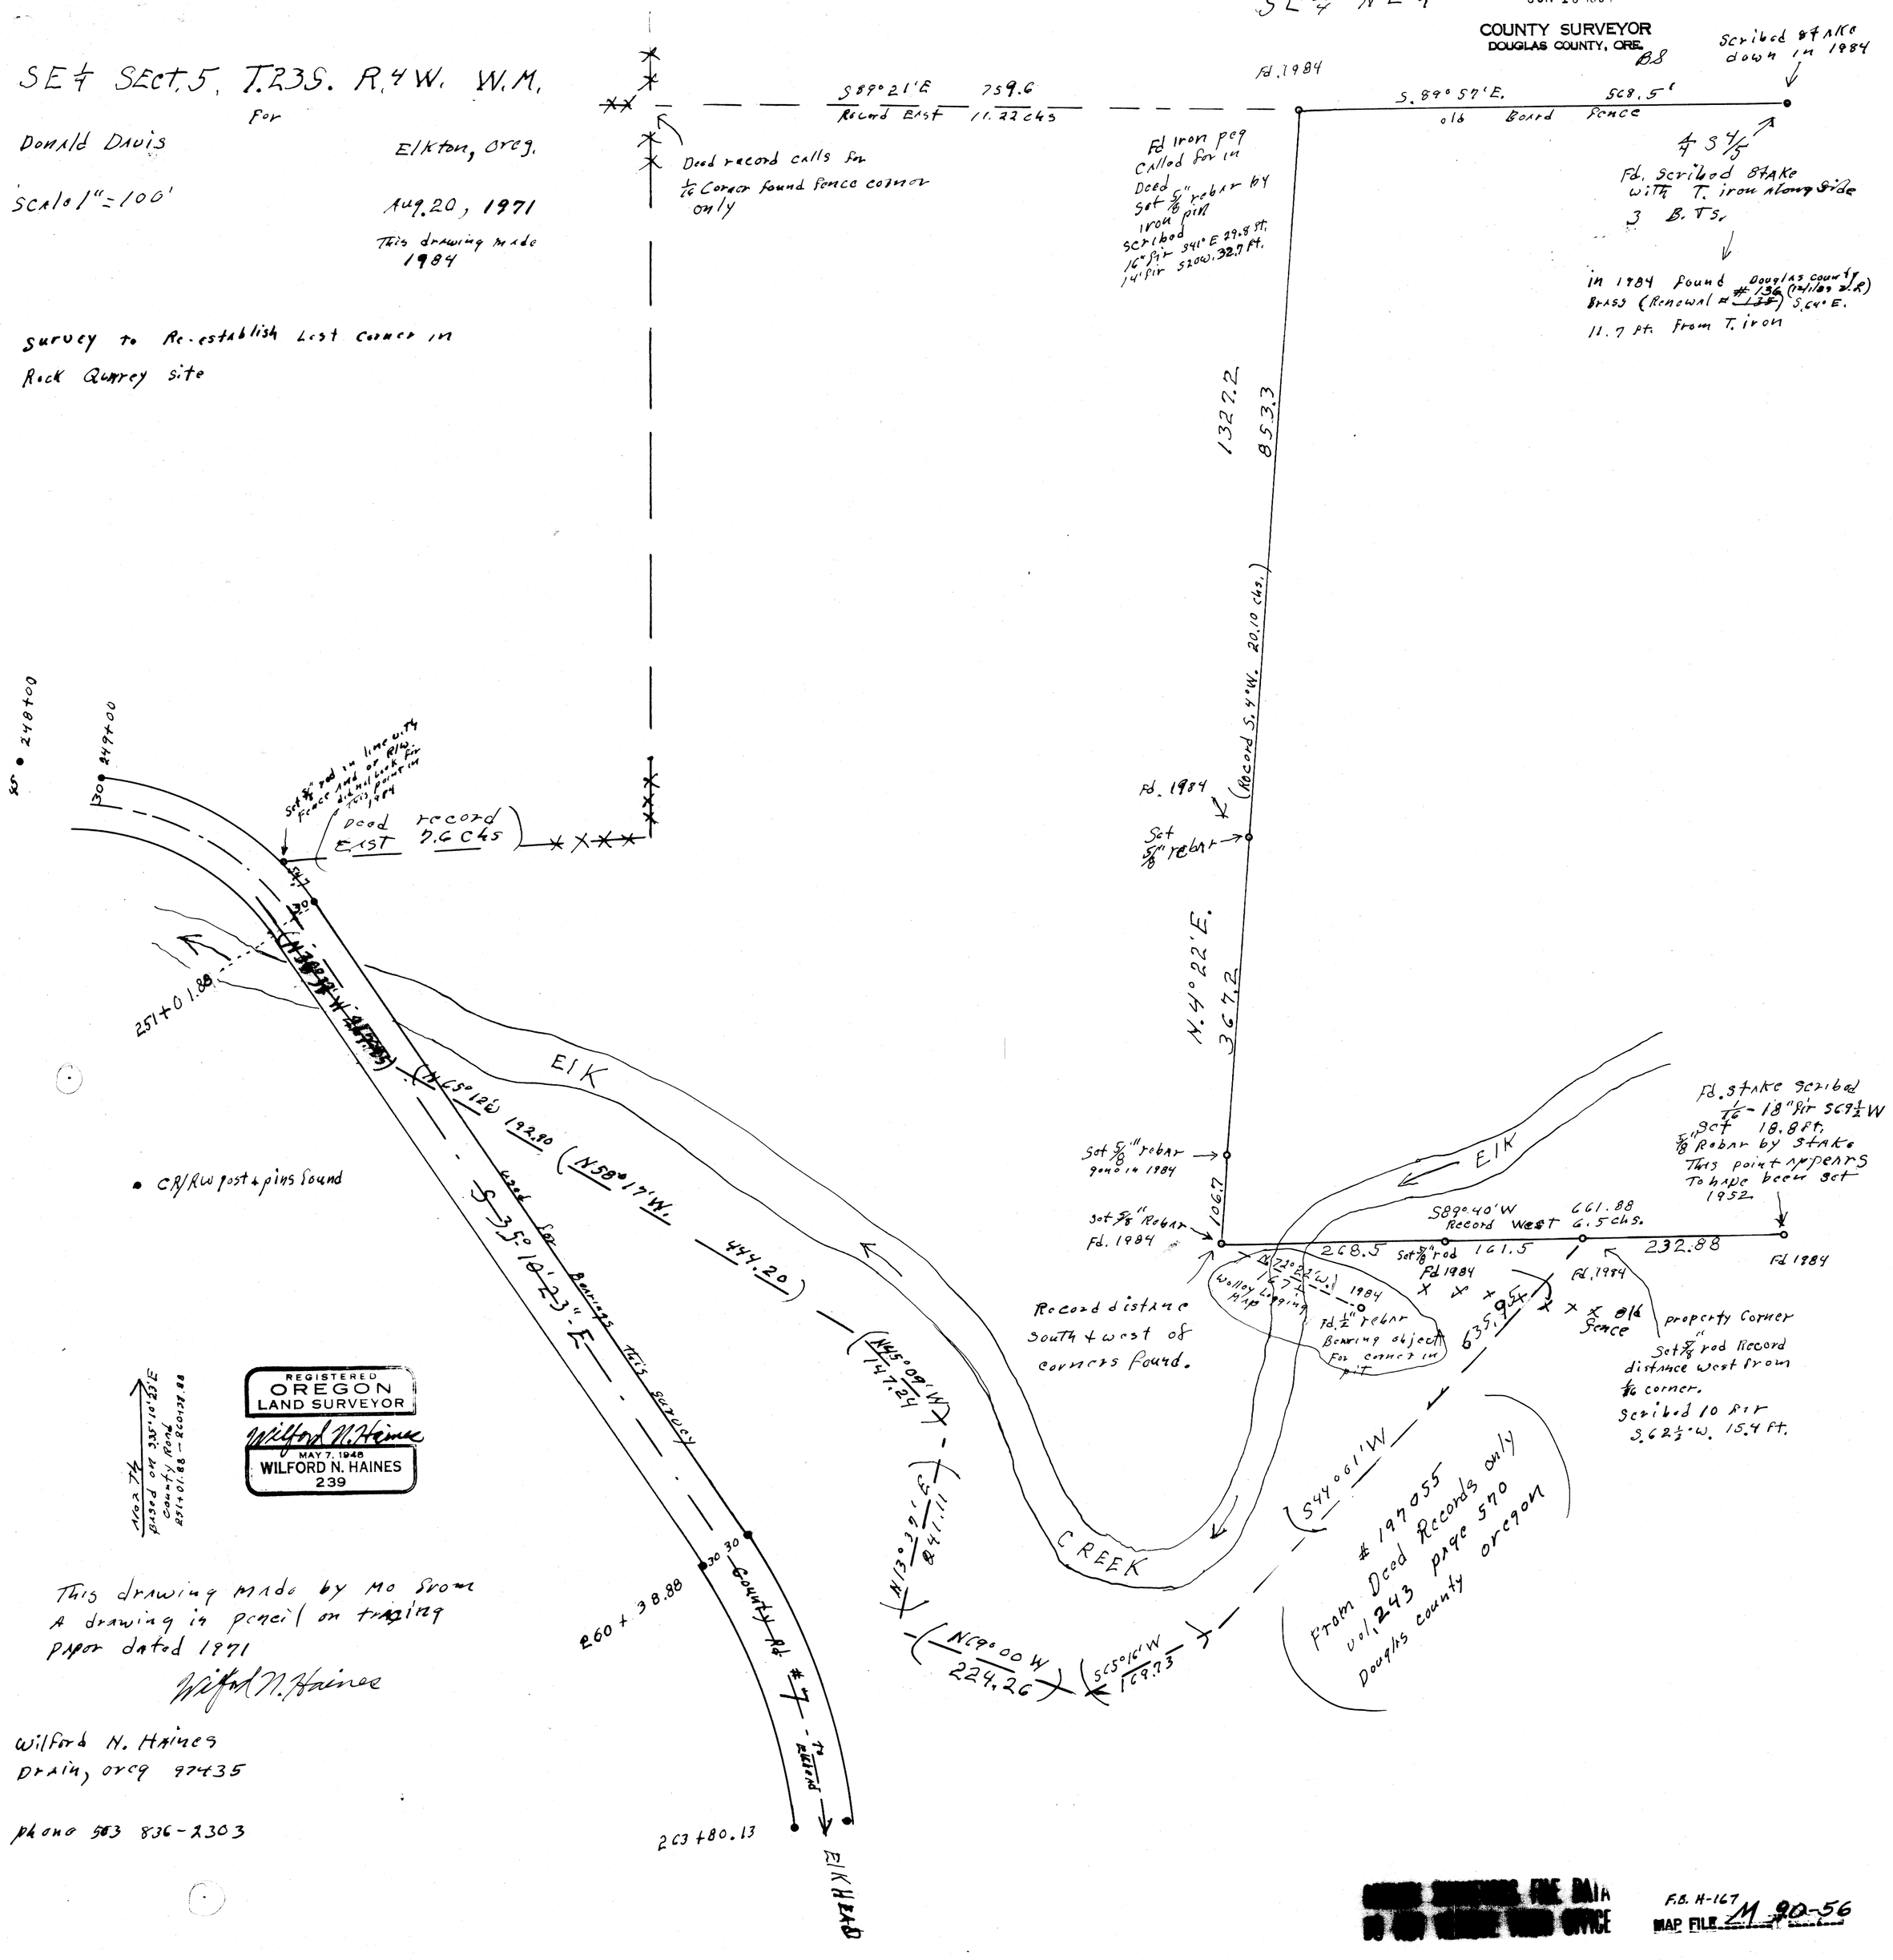

This drawing made by me from a drawing in pencil on tracing paper dated 1971

Wilford N. Haines

Wilford N. Haines
Drain, Oreg 97435

phone 503 836-2303

FILE DATA
F.B. H-167
MAP FILE M 90-56