COUNTY SURVEYORS FILE DATA
DO NOT REMOVE FROM OFFICE

SURVEY FOR DEED DESCRIPTION IN NE 1/4, SEC. 19, T25, R5W, W.M., SUTHERLIN, OREGON

FILED BS
RECEIVED BS
FEB 26 1982
COUNTY SURVEYOR
DOUGLAS COUNTY, ORE.
BS

MAP FILE M-91-22

SURVEYED FOR: LLOYD WILSON
BY: ROBERT L. DOLAN
RT. 1, BOX 1820
SUTHERLIN, OREGON
DATE: FEBRUARY, 1982

LEGEND

- ● SET 5/8" x 30" IRON ROD WITH CAP - SEE "A"
- ○ FOUND 5/8" ROD, OR AS NOTED
- ( ) RECORD BEARINGS & DISTANCES SHOWN IN PARENTHESIS

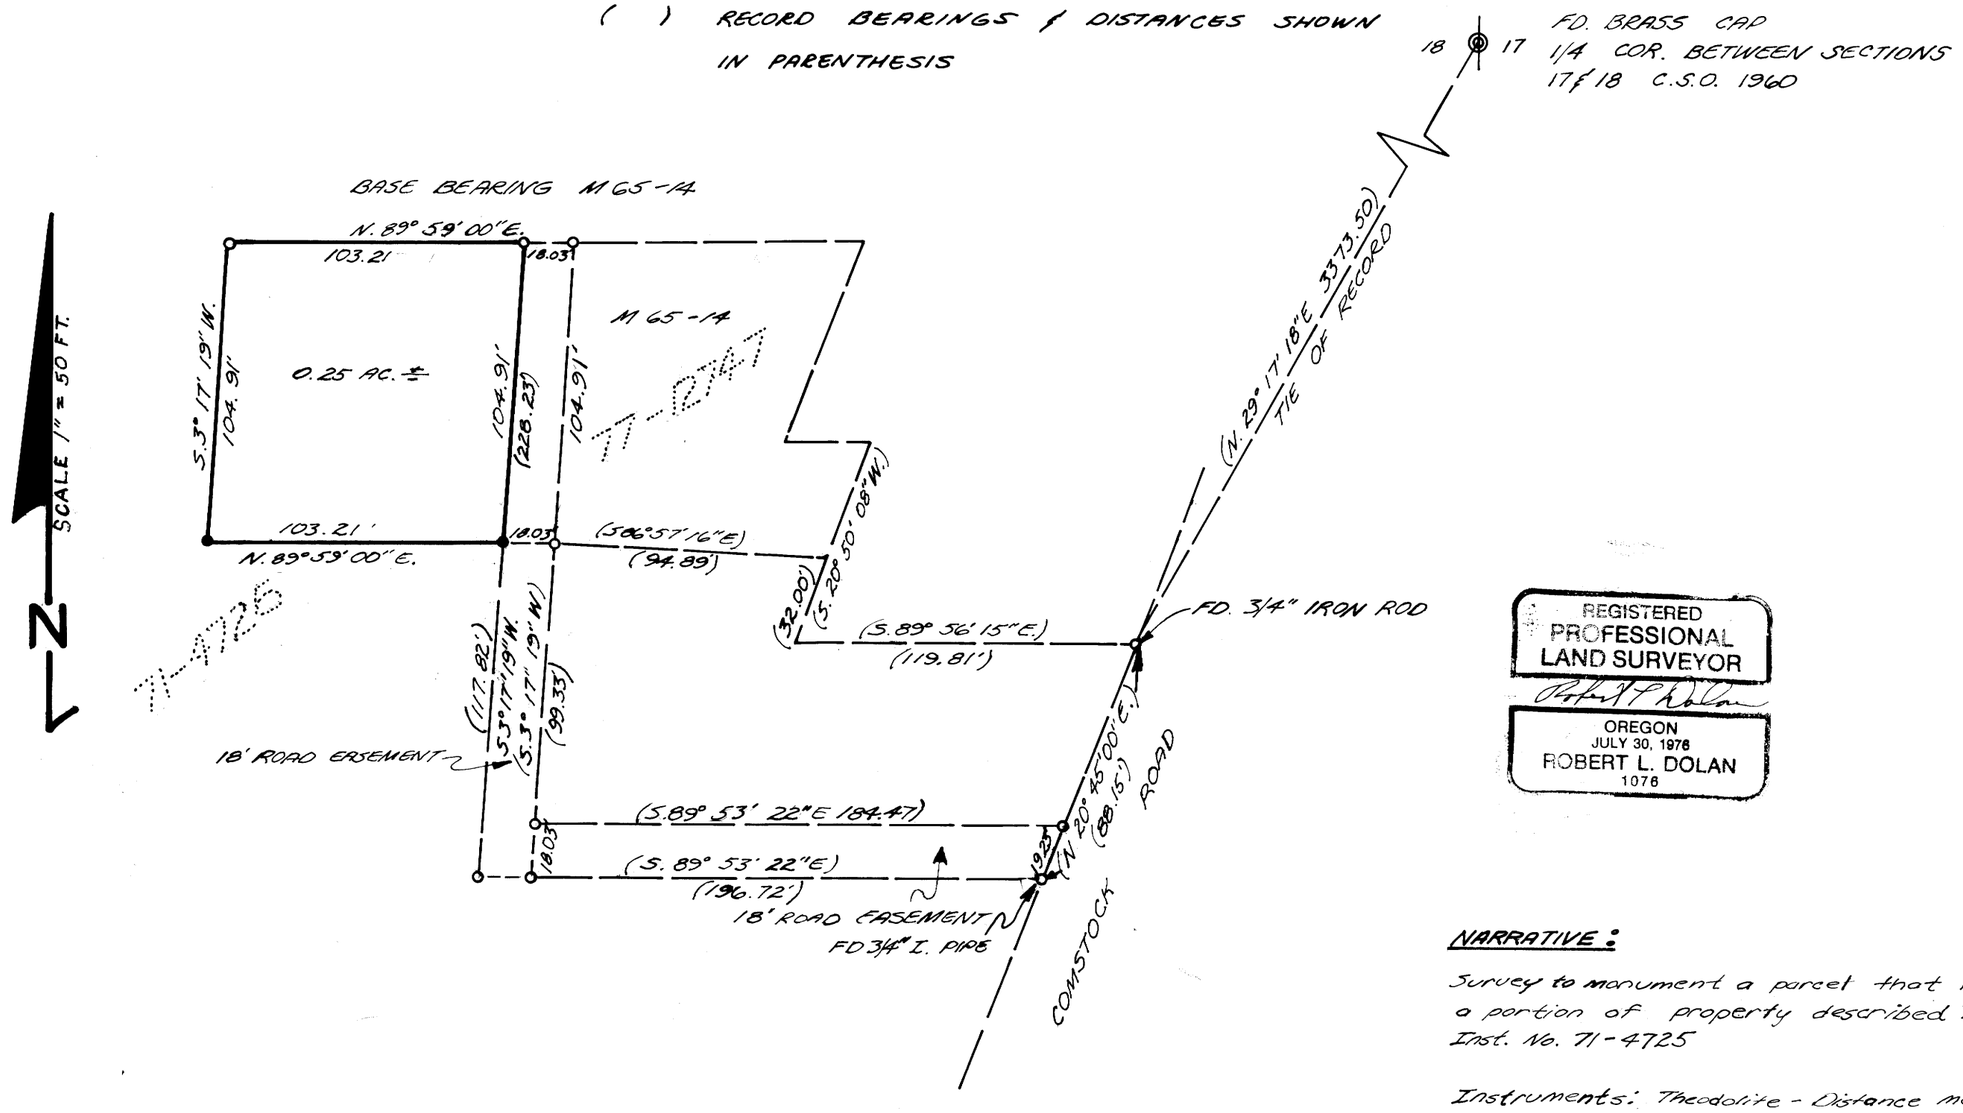

REGISTERED
PROFESSIONAL
LAND SURVEYOR
Robert L. Dolan
OREGON
JULY 30, 1976
ROBERT L. DOLAN
1076

NARRATIVE:

Survey to monument a parcel that is a portion of property described in Inst. No. 71-4725

Instruments: Theodolite - Distance meter.
"A" 1/4" Diameter Rod Cap

LS
1076

MAP FILE M-91-22