COUNTY SURVEYORS FILE DATA
DO NOT REMOVE FROM OFFICE

SURVEY IN A PORTION OF LOT 35, PLAT H, ROSEBURG HOME ORCHARD TRACTS, & LYING IN NW 1/4 OF SECTION 10, T28S, R6W, W.M.

FOR: MRS. AUSTIN

BY: BHW ENGINEERING & SURVEYING, INC.
1205 S.E. COURT - ROSEBURG, OREGON

NARRATIVE:

SURVEY TO ESTABLISH DIVISION OF PROPERTY BETWEEN ADJACENT PROPERTY OWNERS.

FIELD CREW: D. BENTZ & D. DELATTE USING WILD T-1 AND RED-1 EDM.

MONUMENTS SET PER DIRECTION OF MRS. AUSTIN IN AGREEMENT WITH HER SON.

COMPUTATIONS: D. BENTZ.

DRAFTING: D. HOPKINS.

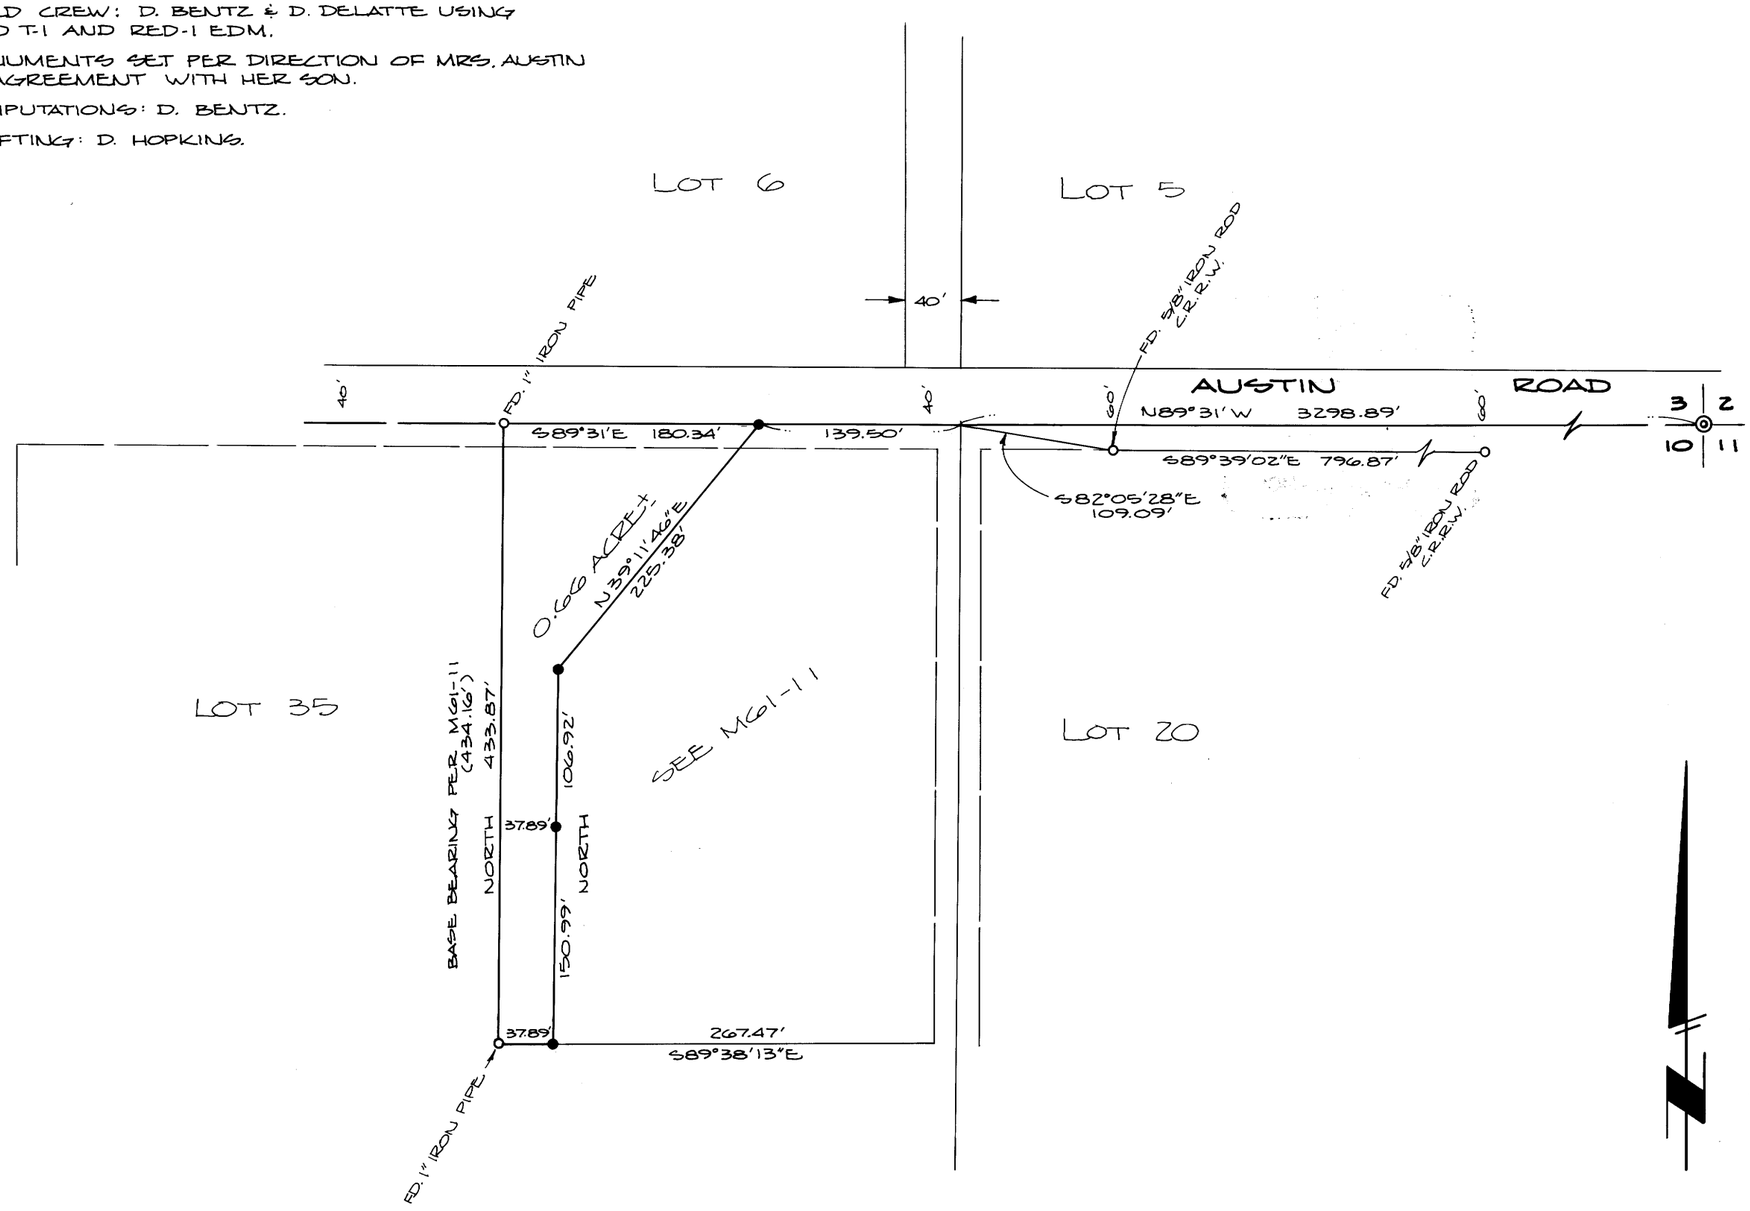

REGISTERED PROFESSIONAL LAND SURVEYOR
OREGON
JULY 12, 1988
DONALD A. BENTZ
839

LEGEND:

- o FOUND MONUMENT AS NOTED
- ● SET 5/8" x 30" IRON ROD WITH CAP MARKED "BHW, INC."
- ◎ FOUND BRASS CAP

SCALE: 1" = 100'
JANUARY 1982

M91-9