MAP FILE M92 - 44

COUNTY SURVEYORS FILE DATA
DO NOT REMOVE FROM OFFICE

Resurvey and Subdivision of N½ and SW¼ Section 4, T31S, R3W, W.M.

For Roseburg Lumber Company

June 10, 1982

Scale: 1" = 400'

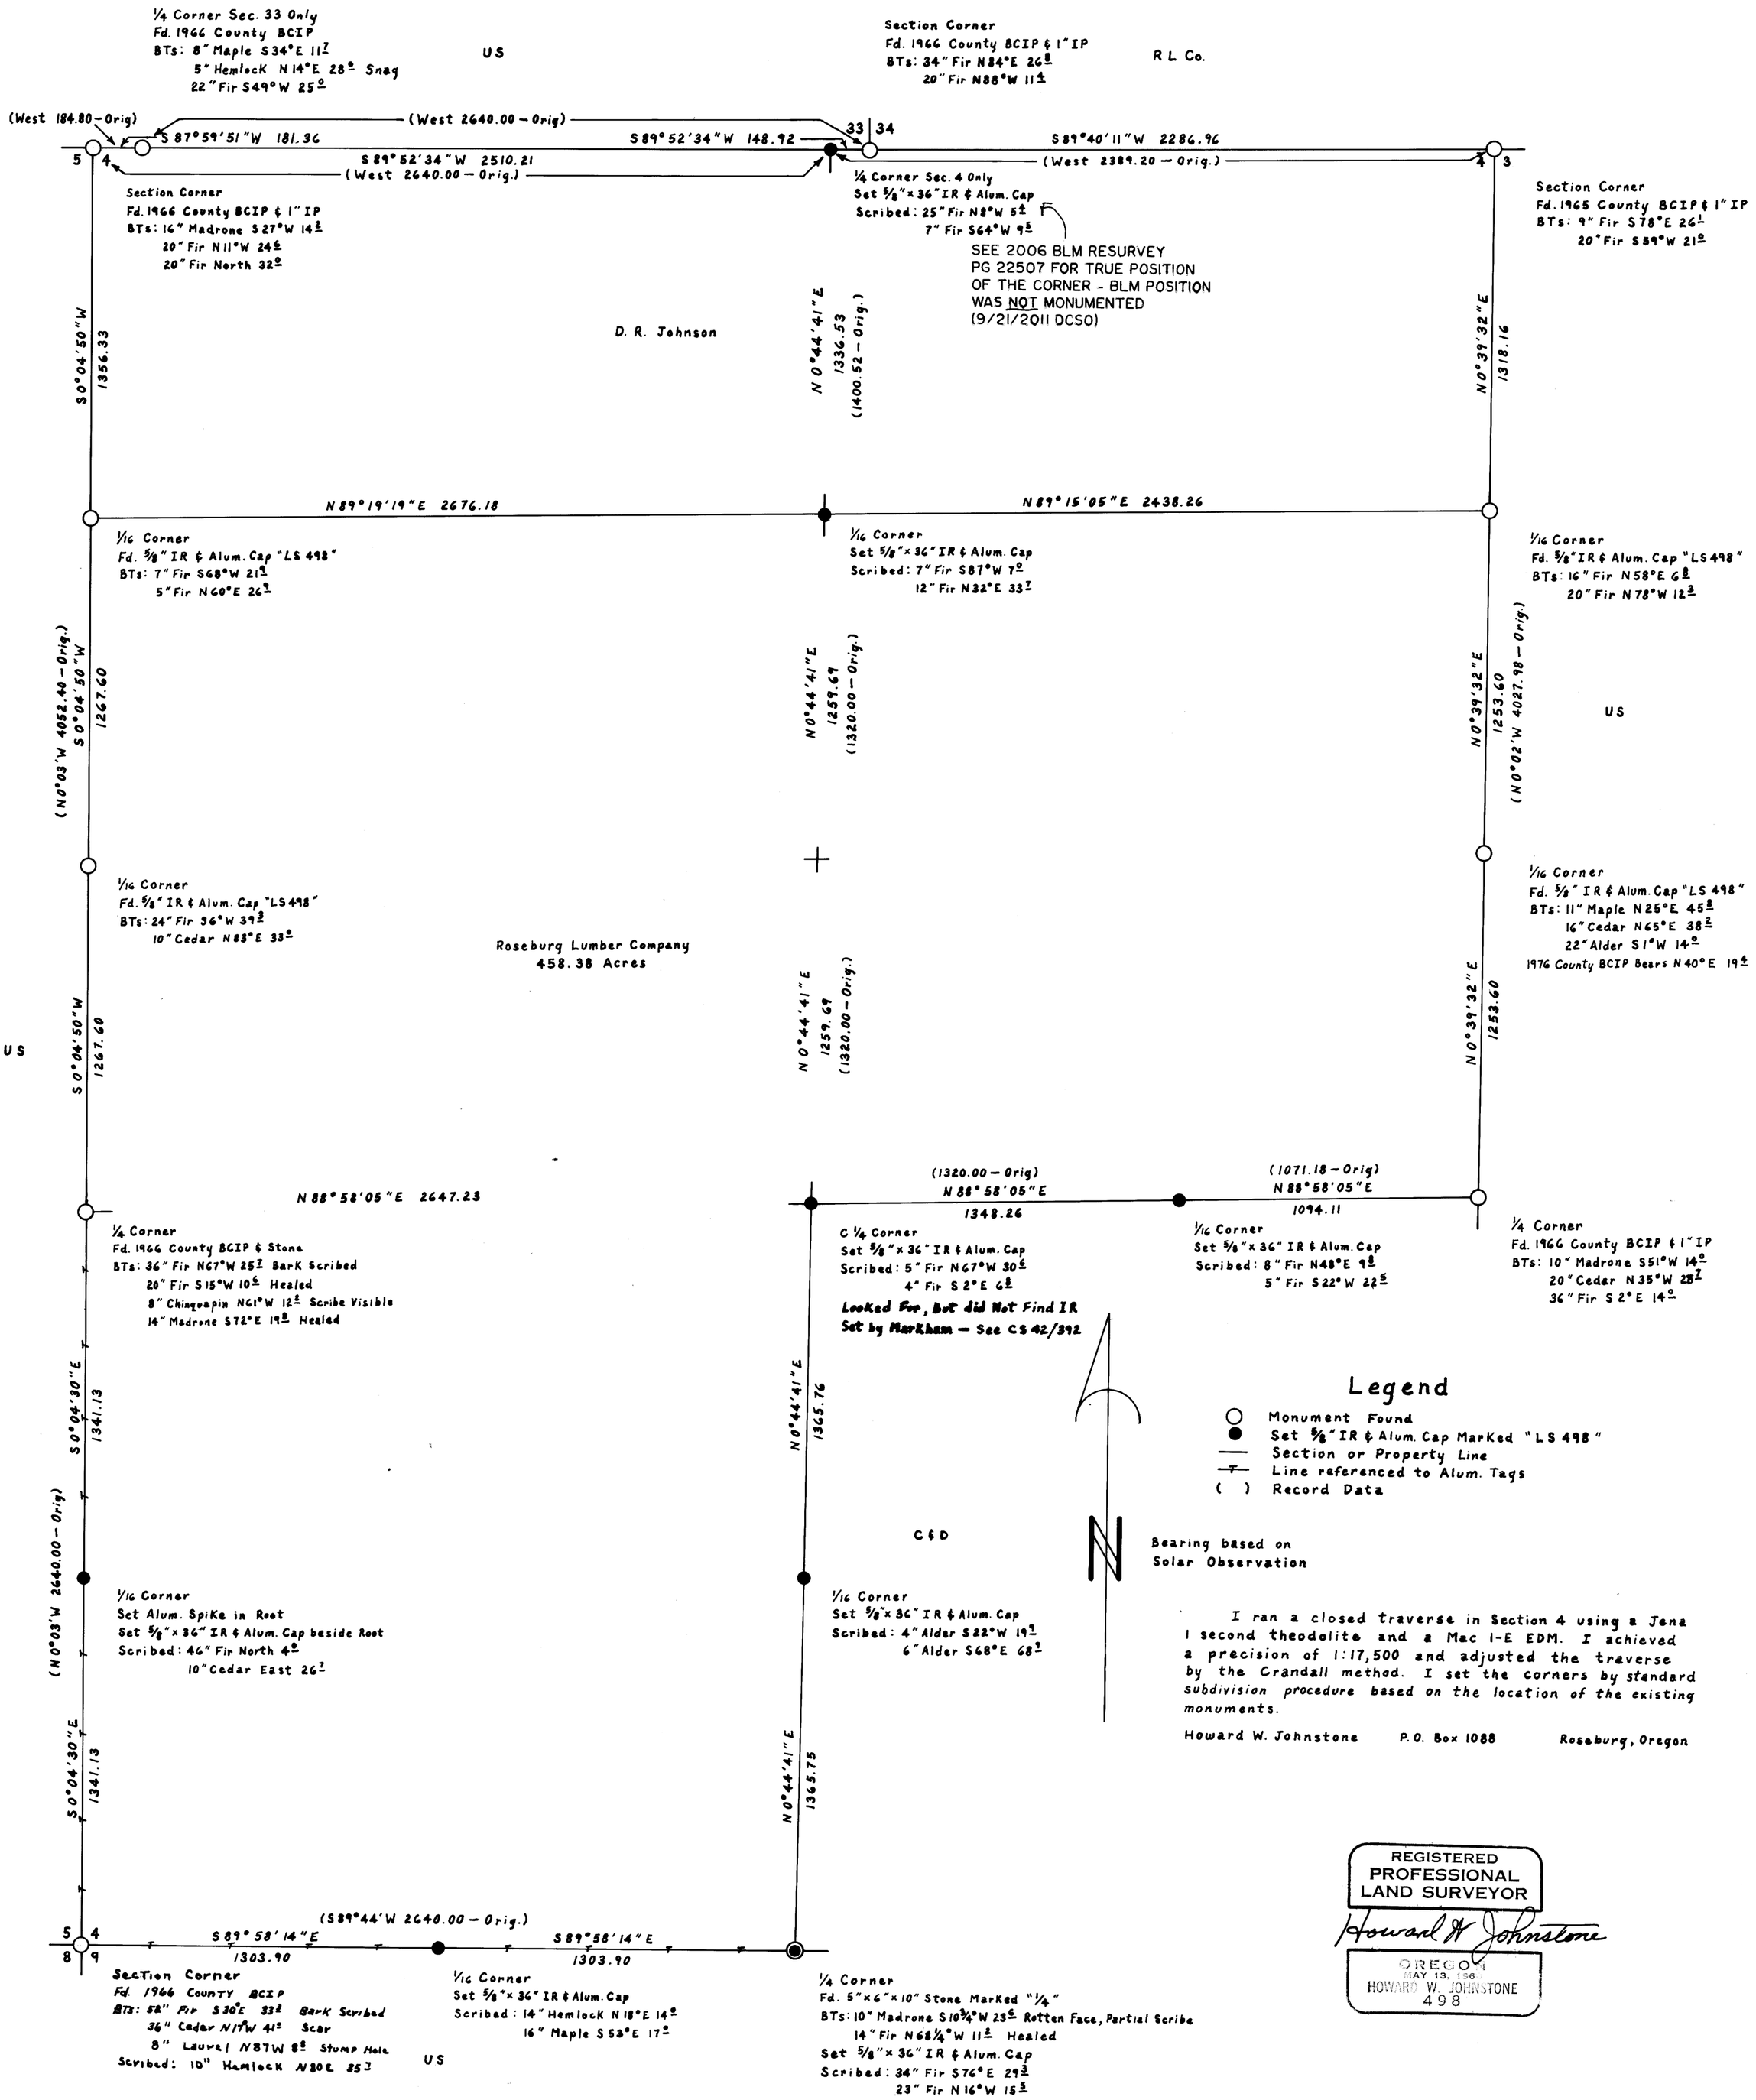

I ran a closed traverse in Section 4 using a Jena 1 second theodolite and a Mac 1-E EDM. I achieved a precision of 1:17,500 and adjusted the traverse by the Crandall method. I set the corners by standard subdivision procedure based on the location of the existing monuments.

Howard W. Johnstone P.O. Box 1088 Roseburg, Oregon

REGISTERED
PROFESSIONAL
LAND SURVEYOR
Howard W. Johnstone
OREGON
MAY 13, 1960
HOWARD W. JOHNSTONE
498

MAP FILE M92 - 44