MAP FILE M 92-72

COUNTY SURVEYORS FILE DATA
DO NOT REMOVE FROM OFFICE

FILED BS
RECEIVED BS
SEP 2 1982
COUNTY SURVEYOR
DOUGLAS COUNTY, ORE.
BS

S.E. ¼, SECTION 4, T.23S., R.5W. W.M.

August 23, 1982. Scale: 1" = 50'

For

Board of Engineering Examiners
Room 403, Labor + industries Building
Salem, Oregon 97310 Phone 378-4180
File No 2-82-132

by

Wilford N. Haines
Star Rt. 38 Box 2
Drain, Oregon. 97435
phone: 836-2303

original for
Nick Botner
Yoncalla, Oreg.

◎ These points were set for a proposed subdivision at points that I thought would make lots the size and shape that I wanted them.

When the project was aborted I pulled the rods out and dropped a 60 penny spike in its place so I could find the points if wanted

At the direction of the state board of Engineering Examiners I have reset ⅝"x40" rebars at the points with a brass disk inscribed "survey point Wilford N. Haines # 239"

As the project was aborted before it got that far, I do not have an accurate bearing or distance for the lines.

⊙ Fd. ⅝" x 40 rebars * These are points shown on Timber Subdivision Phase II Vol. 16 page 59

REGISTERED
OREGON
LAND SURVEYOR
Wilford N. Haines
MAY 7, 1948
WILFORD N. HAINES
239

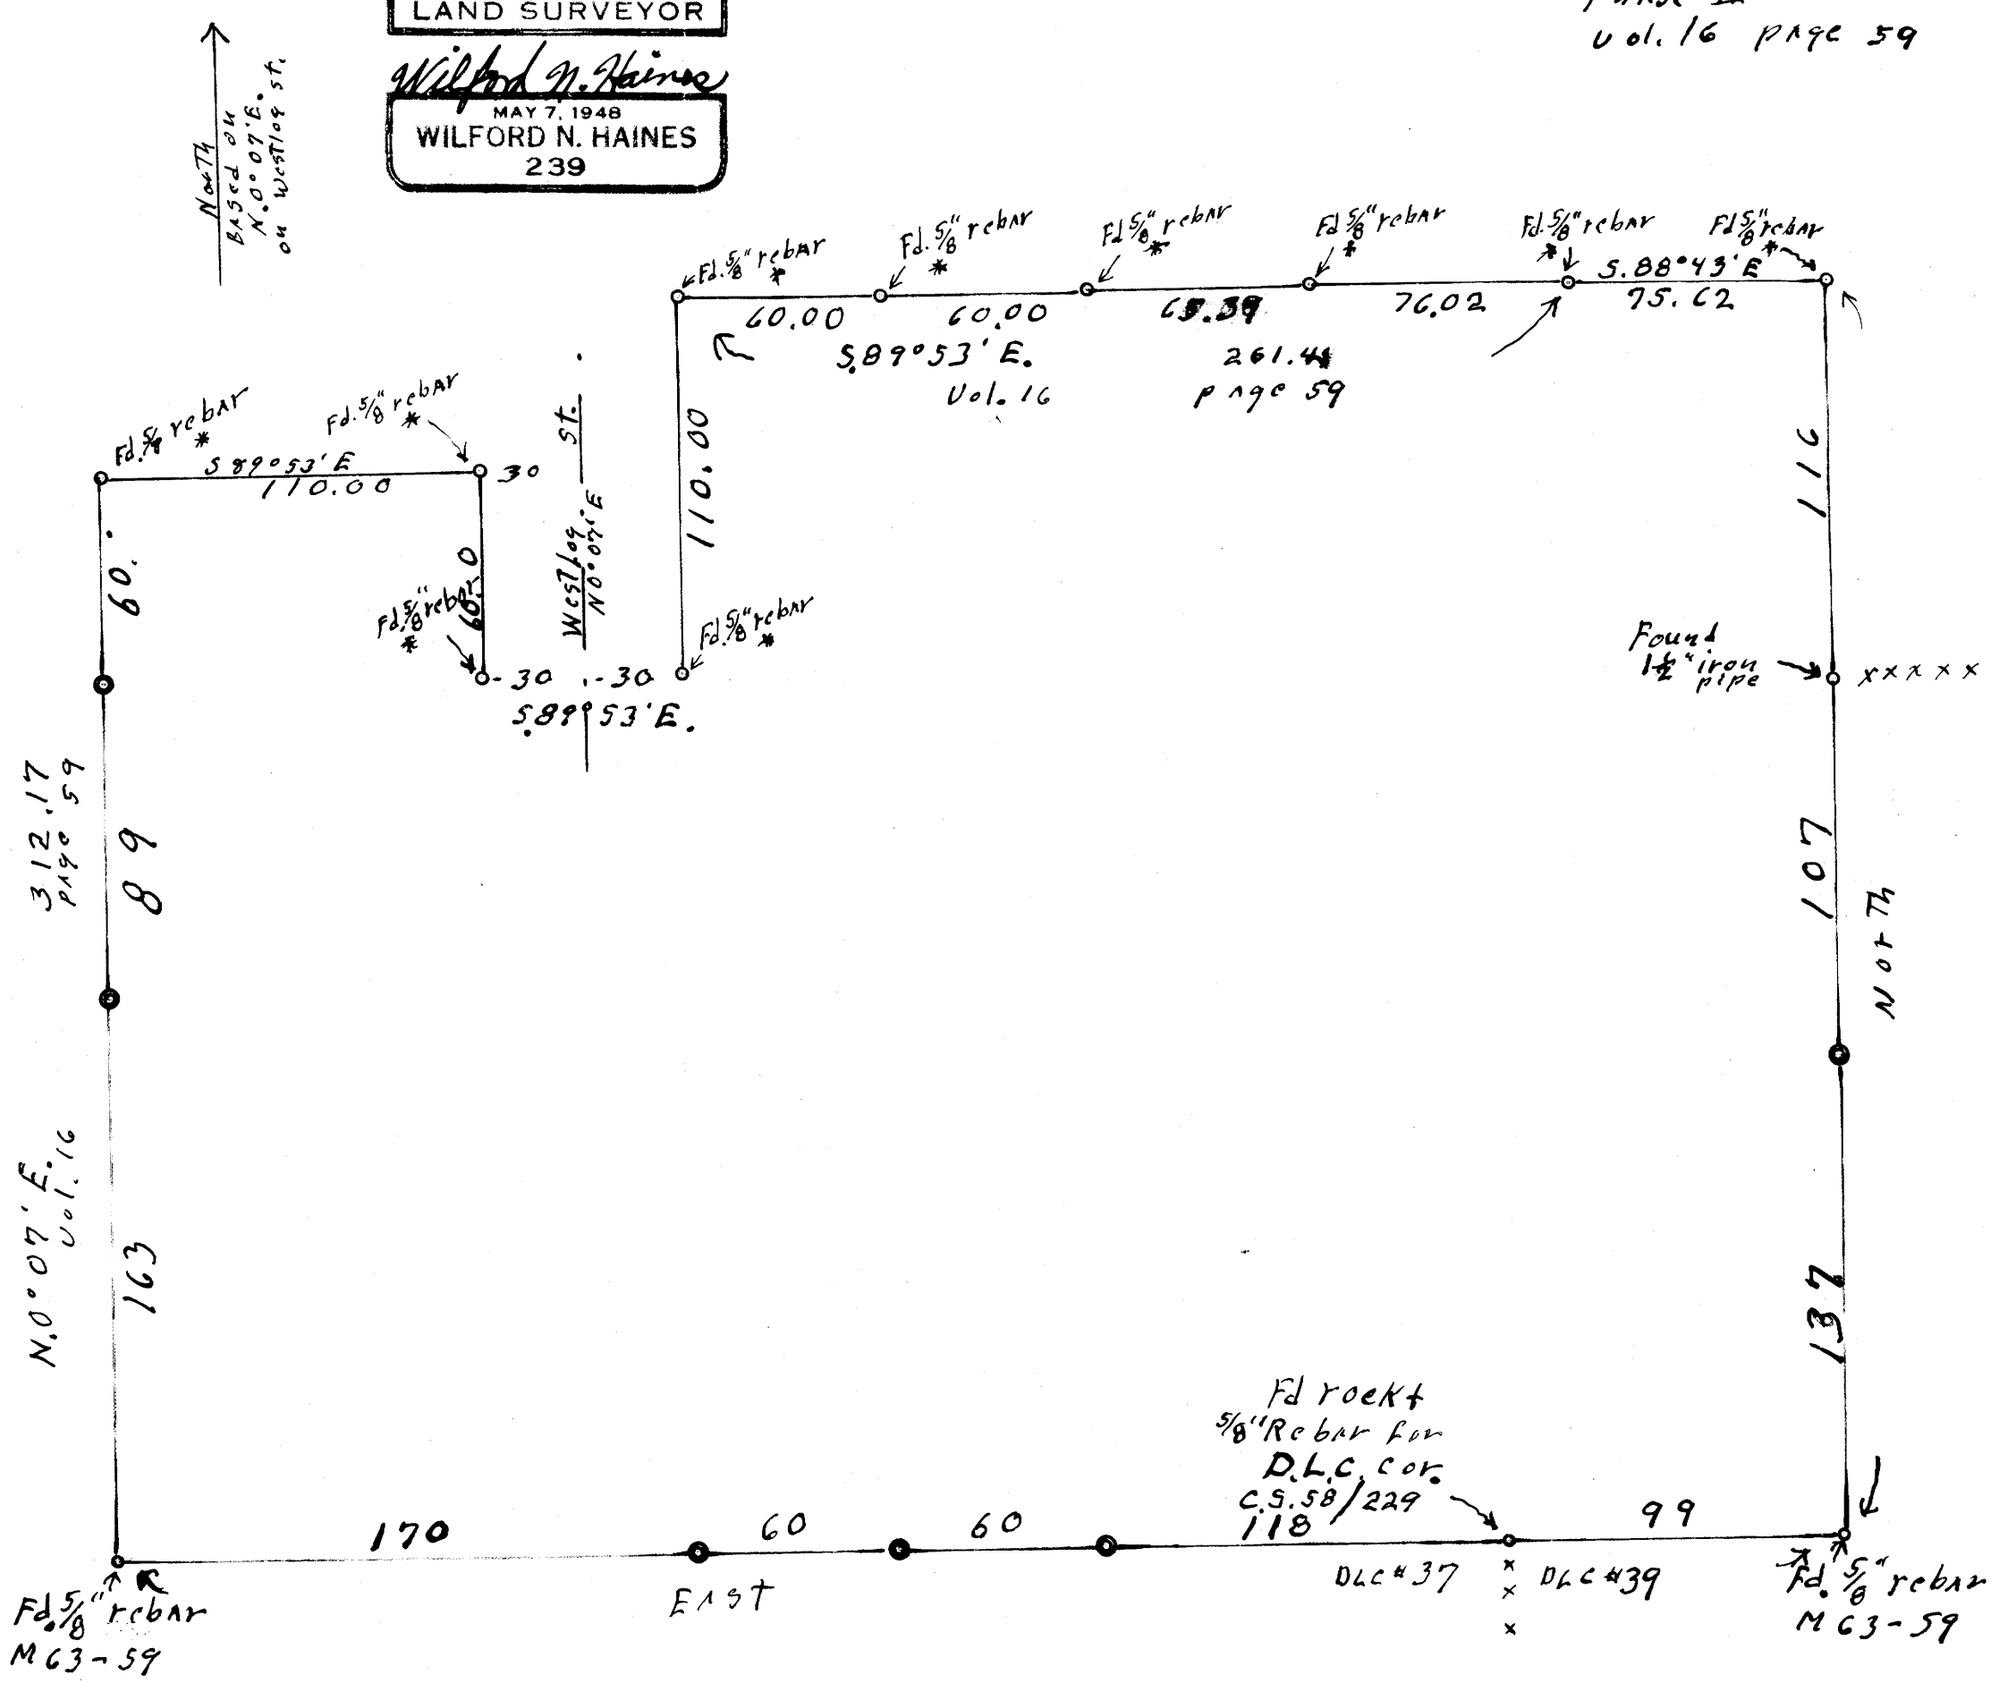

MAP FILE M 92-72