MAP FILE M 93 - 35A

MINOR LAND PARTITION
IN LOT 4
FROZEN CREEK TRACTS
NE¼ SECTION 5, T29S R4W W.M.

COUNTY SURVEYORS FILE DATA
DO NOT REMOVE FROM OFFICE

FILED BS
RECEIVED
DEC 29 1982
COUNTY SURVEYOR
DOUGLAS COUNTY, ORE.
BS

PARTITIONER: Clinton Brown
223A North Myrtle Route
Myrtle Creek, OR 97457

OWNER: William & Georgia Bryant
252 North Myrtle Road
Myrtle Creek, OR 97457

Number of Lots: Two (2)
Water Supply: North Myrtle Creek
Sewage Disposal: Septic

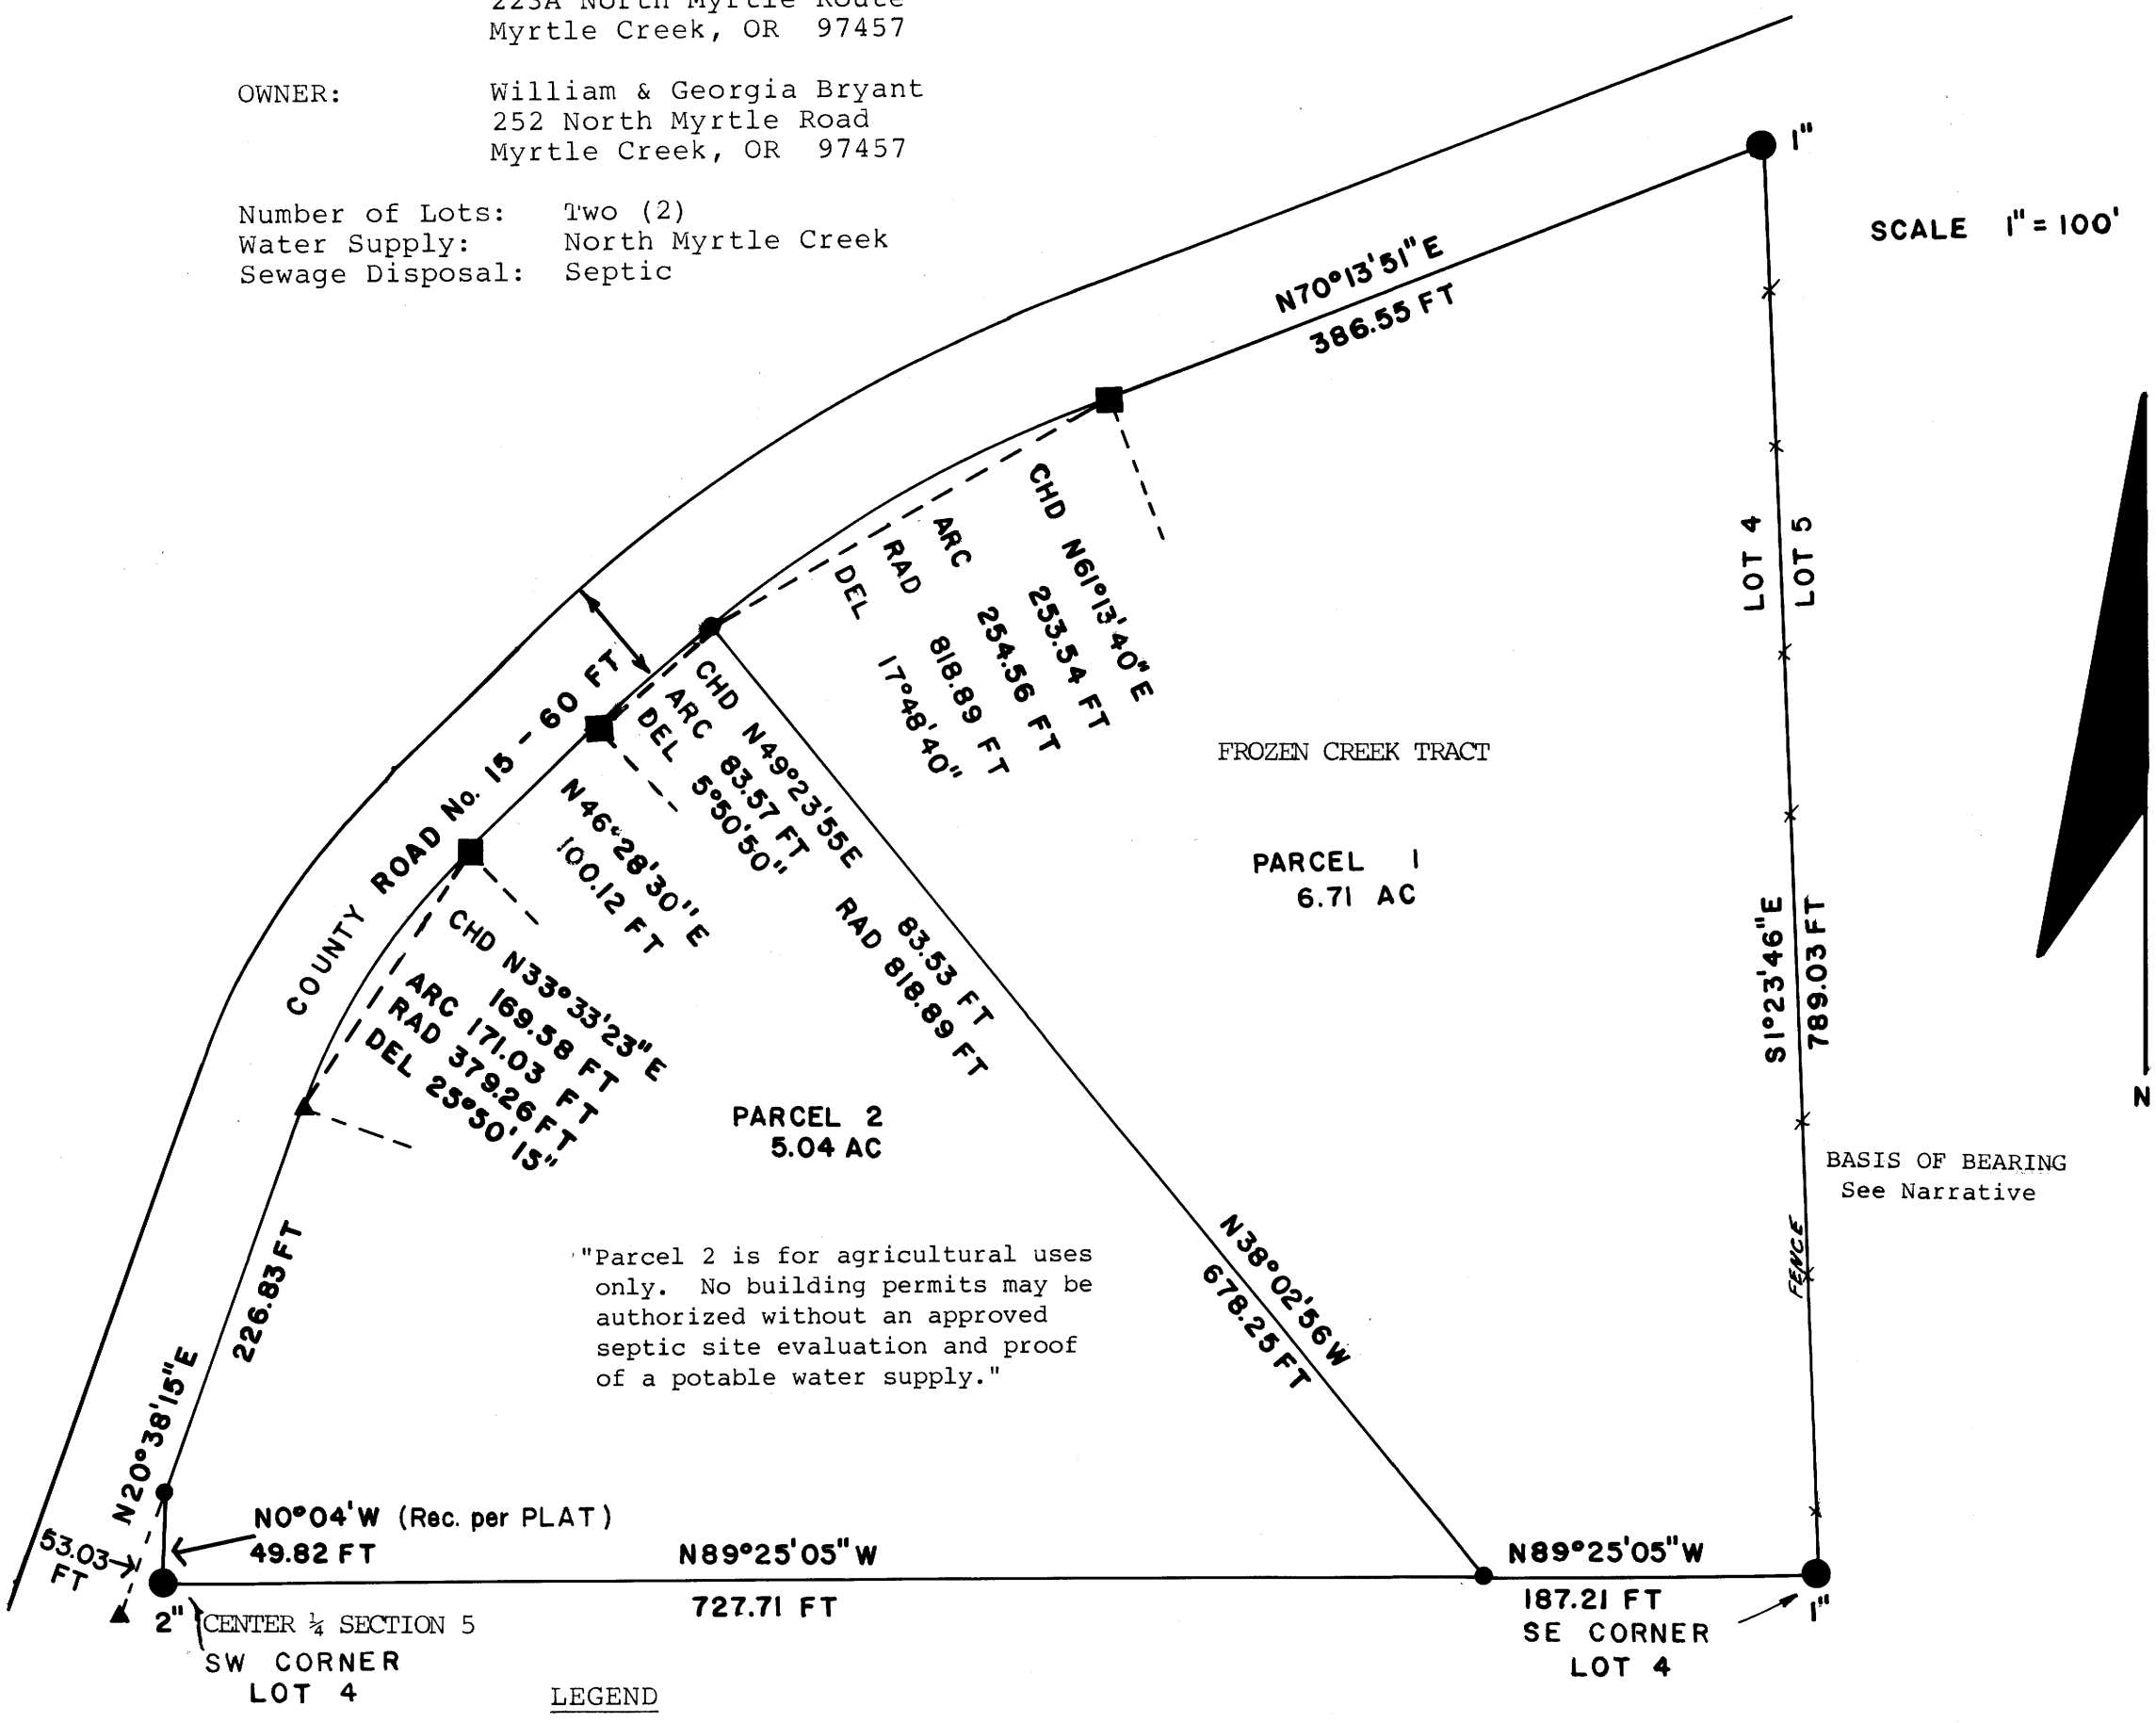

LEGEND

- ● FOUND IRON PIPE AS NOTED
- ▲ FOUND 3/4" IRON ROD (ROAD R/W)
- ■ LOOKED FOR R/W ROD (NOT FOUND)
- ● SET 5/8" x 30" IRON ROD
  3/4" BRASS WASHER LS 866 ATTACHED

UMPQUA SURVEYING COMPANY
Myrtle Creek, OR 97457
November 1982

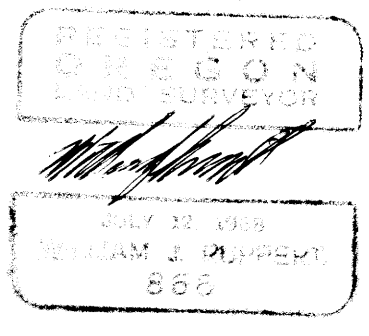

BS 8V 31-A

UAW

MAP FILE M 93 - 35A