COUNTY SURVEYORS FILE DATA
DO NOT REMOVE FROM OFFICE

FILED BS
RECEIVED BS
JAN 18 1983
COUNTY SURVEYOR
DOUGLAS COUNTY, ORE.
BS

MAP FILE M. 93-43

# SURVEY OF
# SEC. 20, T25S, R7W, W.M.

## SURVEYED FOR: CHAMPION INTERNATIONAL CORPORATION
## SURVEYED BY: T.E. SHRUM JR. P.L.S. 1706

DATE: 12-13-1982 SCALE: 1"=500'

T.E. SHRUM JR., LOGGING ENGINEER
CHAMPION INTERNATIONAL CORPORATION
P.O. BOX 1328
ROSEBURG, OR 97470

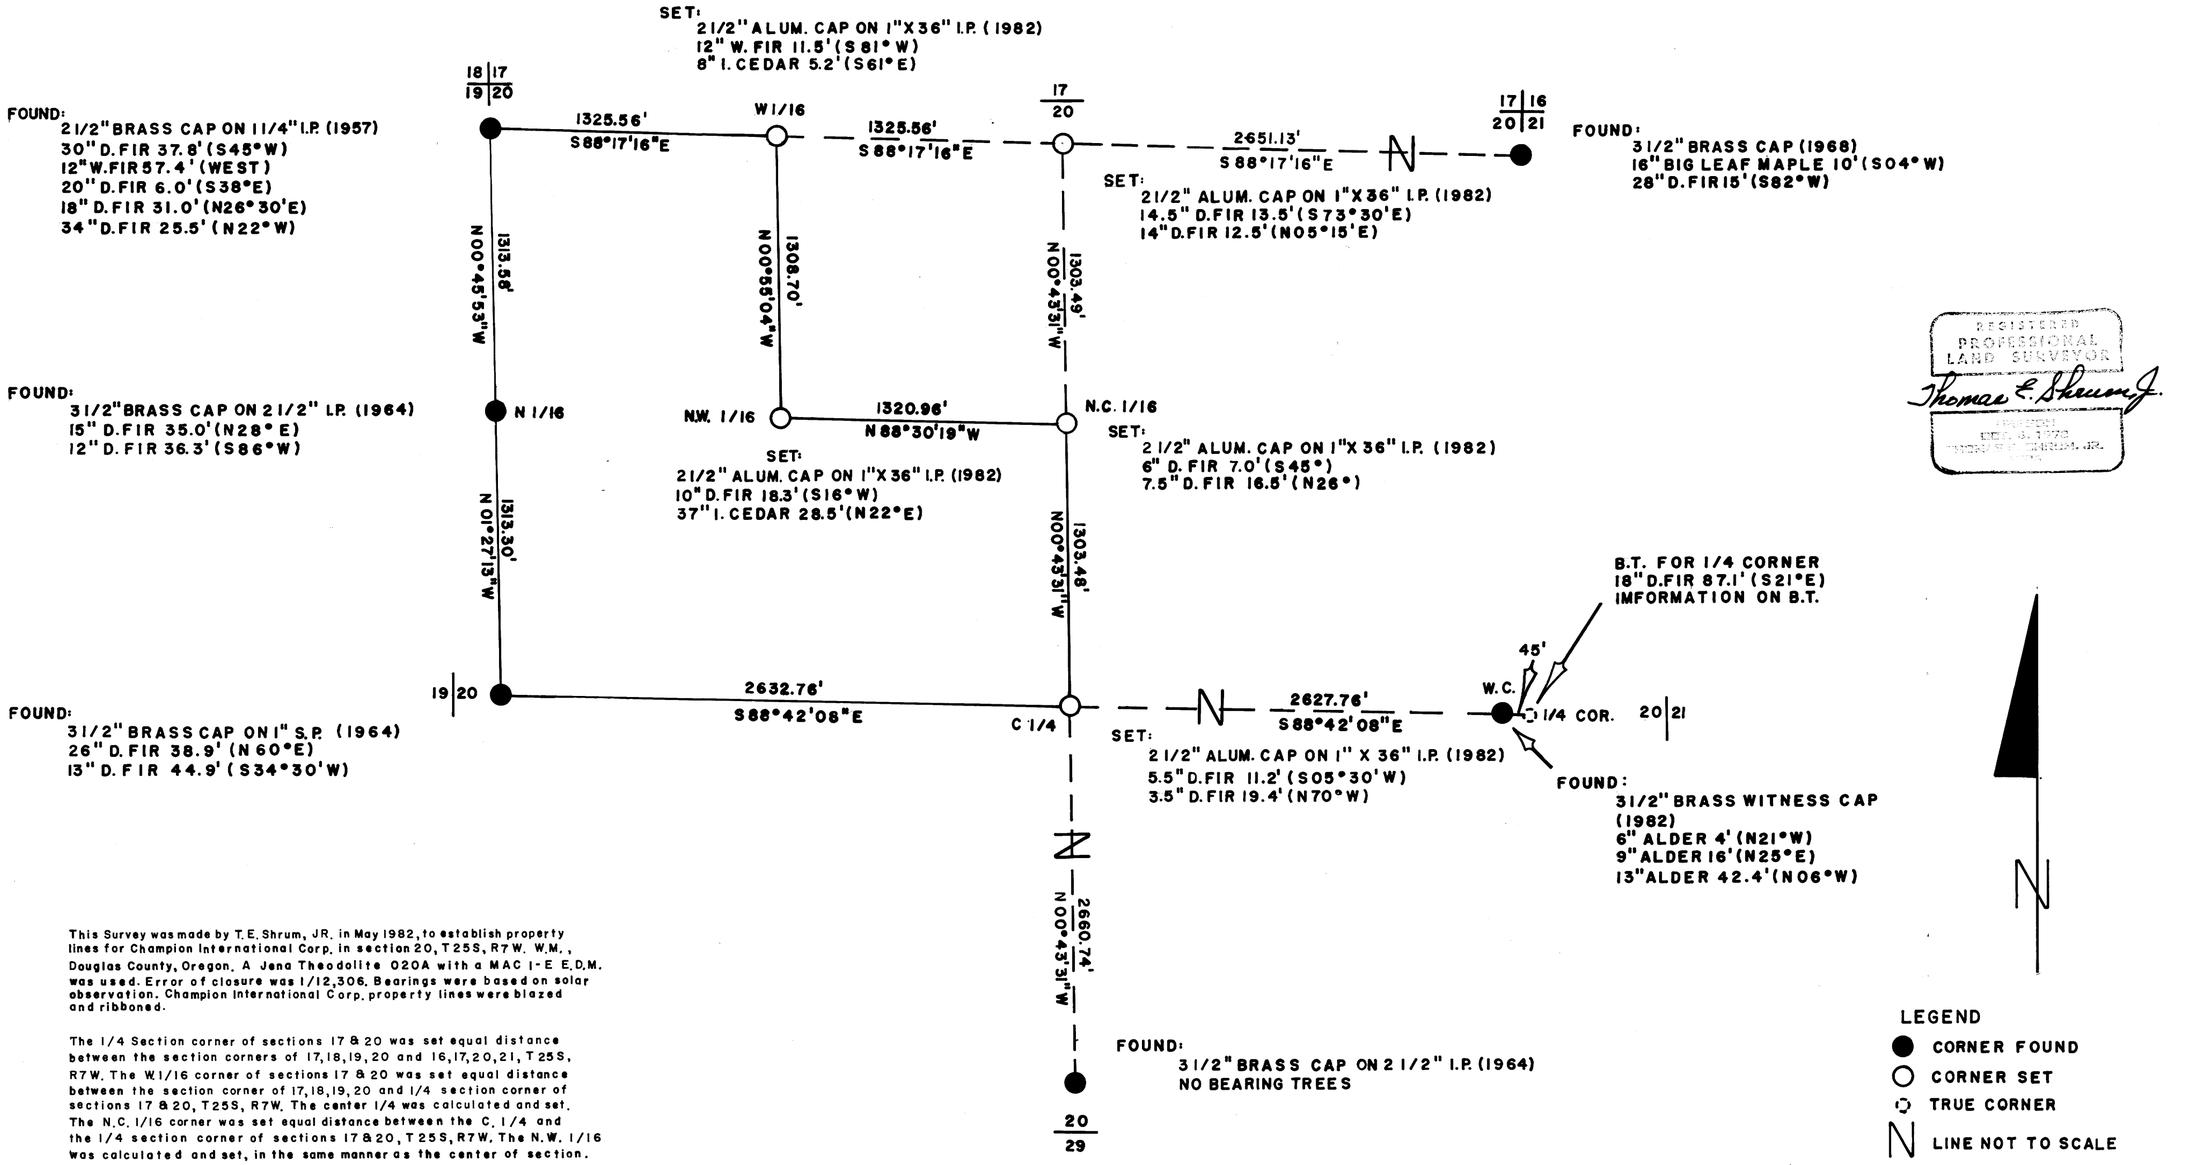





This Survey was made by T.E. Shrum, JR. in May 1982, to establish property lines for Champion International Corp. in section 20, T25S, R7W. W.M., Douglas County, Oregon. A Jena Theodolite 020A with a MAC 1-E E.D.M. was used. Error of closure was 1/12,306. Bearings were based on solar observation. Champion International Corp. property lines were blazed and ribboned.

The 1/4 Section corner of sections 17 & 20 was set equal distance between the section corners of 17, 18, 19, 20 and 16, 17, 20, 21, T25S, R7W. The W.1/16 corner of sections 17 & 20 was set equal distance between the section corner of 17, 18, 19, 20 and 1/4 section corner of sections 17 & 20, T25S, R7W. The center 1/4 was calculated and set. The N.C. 1/16 corner was set equal distance between the C. 1/4 and the 1/4 section corner of sections 17 & 20, T25S, R7W. The N.W. 1/16 was calculated and set, in the same manner as the center of section. The South 1/4 corner is on a fence line, there are no Bearing Trees evident. The actual East 1/4 corner falls in Hubbard Creek with one Bearing Tree evident. Field survey was to the Witness Corner, and coordinates for the true 1/4 corner derived from notes on file.

LEGEND
- ● CORNER FOUND
- ○ CORNER SET
- ◌ TRUE CORNER
- N LINE NOT TO SCALE

P.L.S. 1706: IS MARKED ON ALL SET MONUMENTS

MAP FILE M 93-43