Resurvey and Subdivision of Section 6, T31S, R7W, W.M. Oregon

FILED
RECEIVED
COUNTY SURVEYORS FILE DATE
NOT REMOVE FROM OFFICE
COUNTY SURVEYOR
DOUGLAS COUNTY, OREGON

For Roseburg Lbr. Company Scale 1" = 400' February 10, 1983

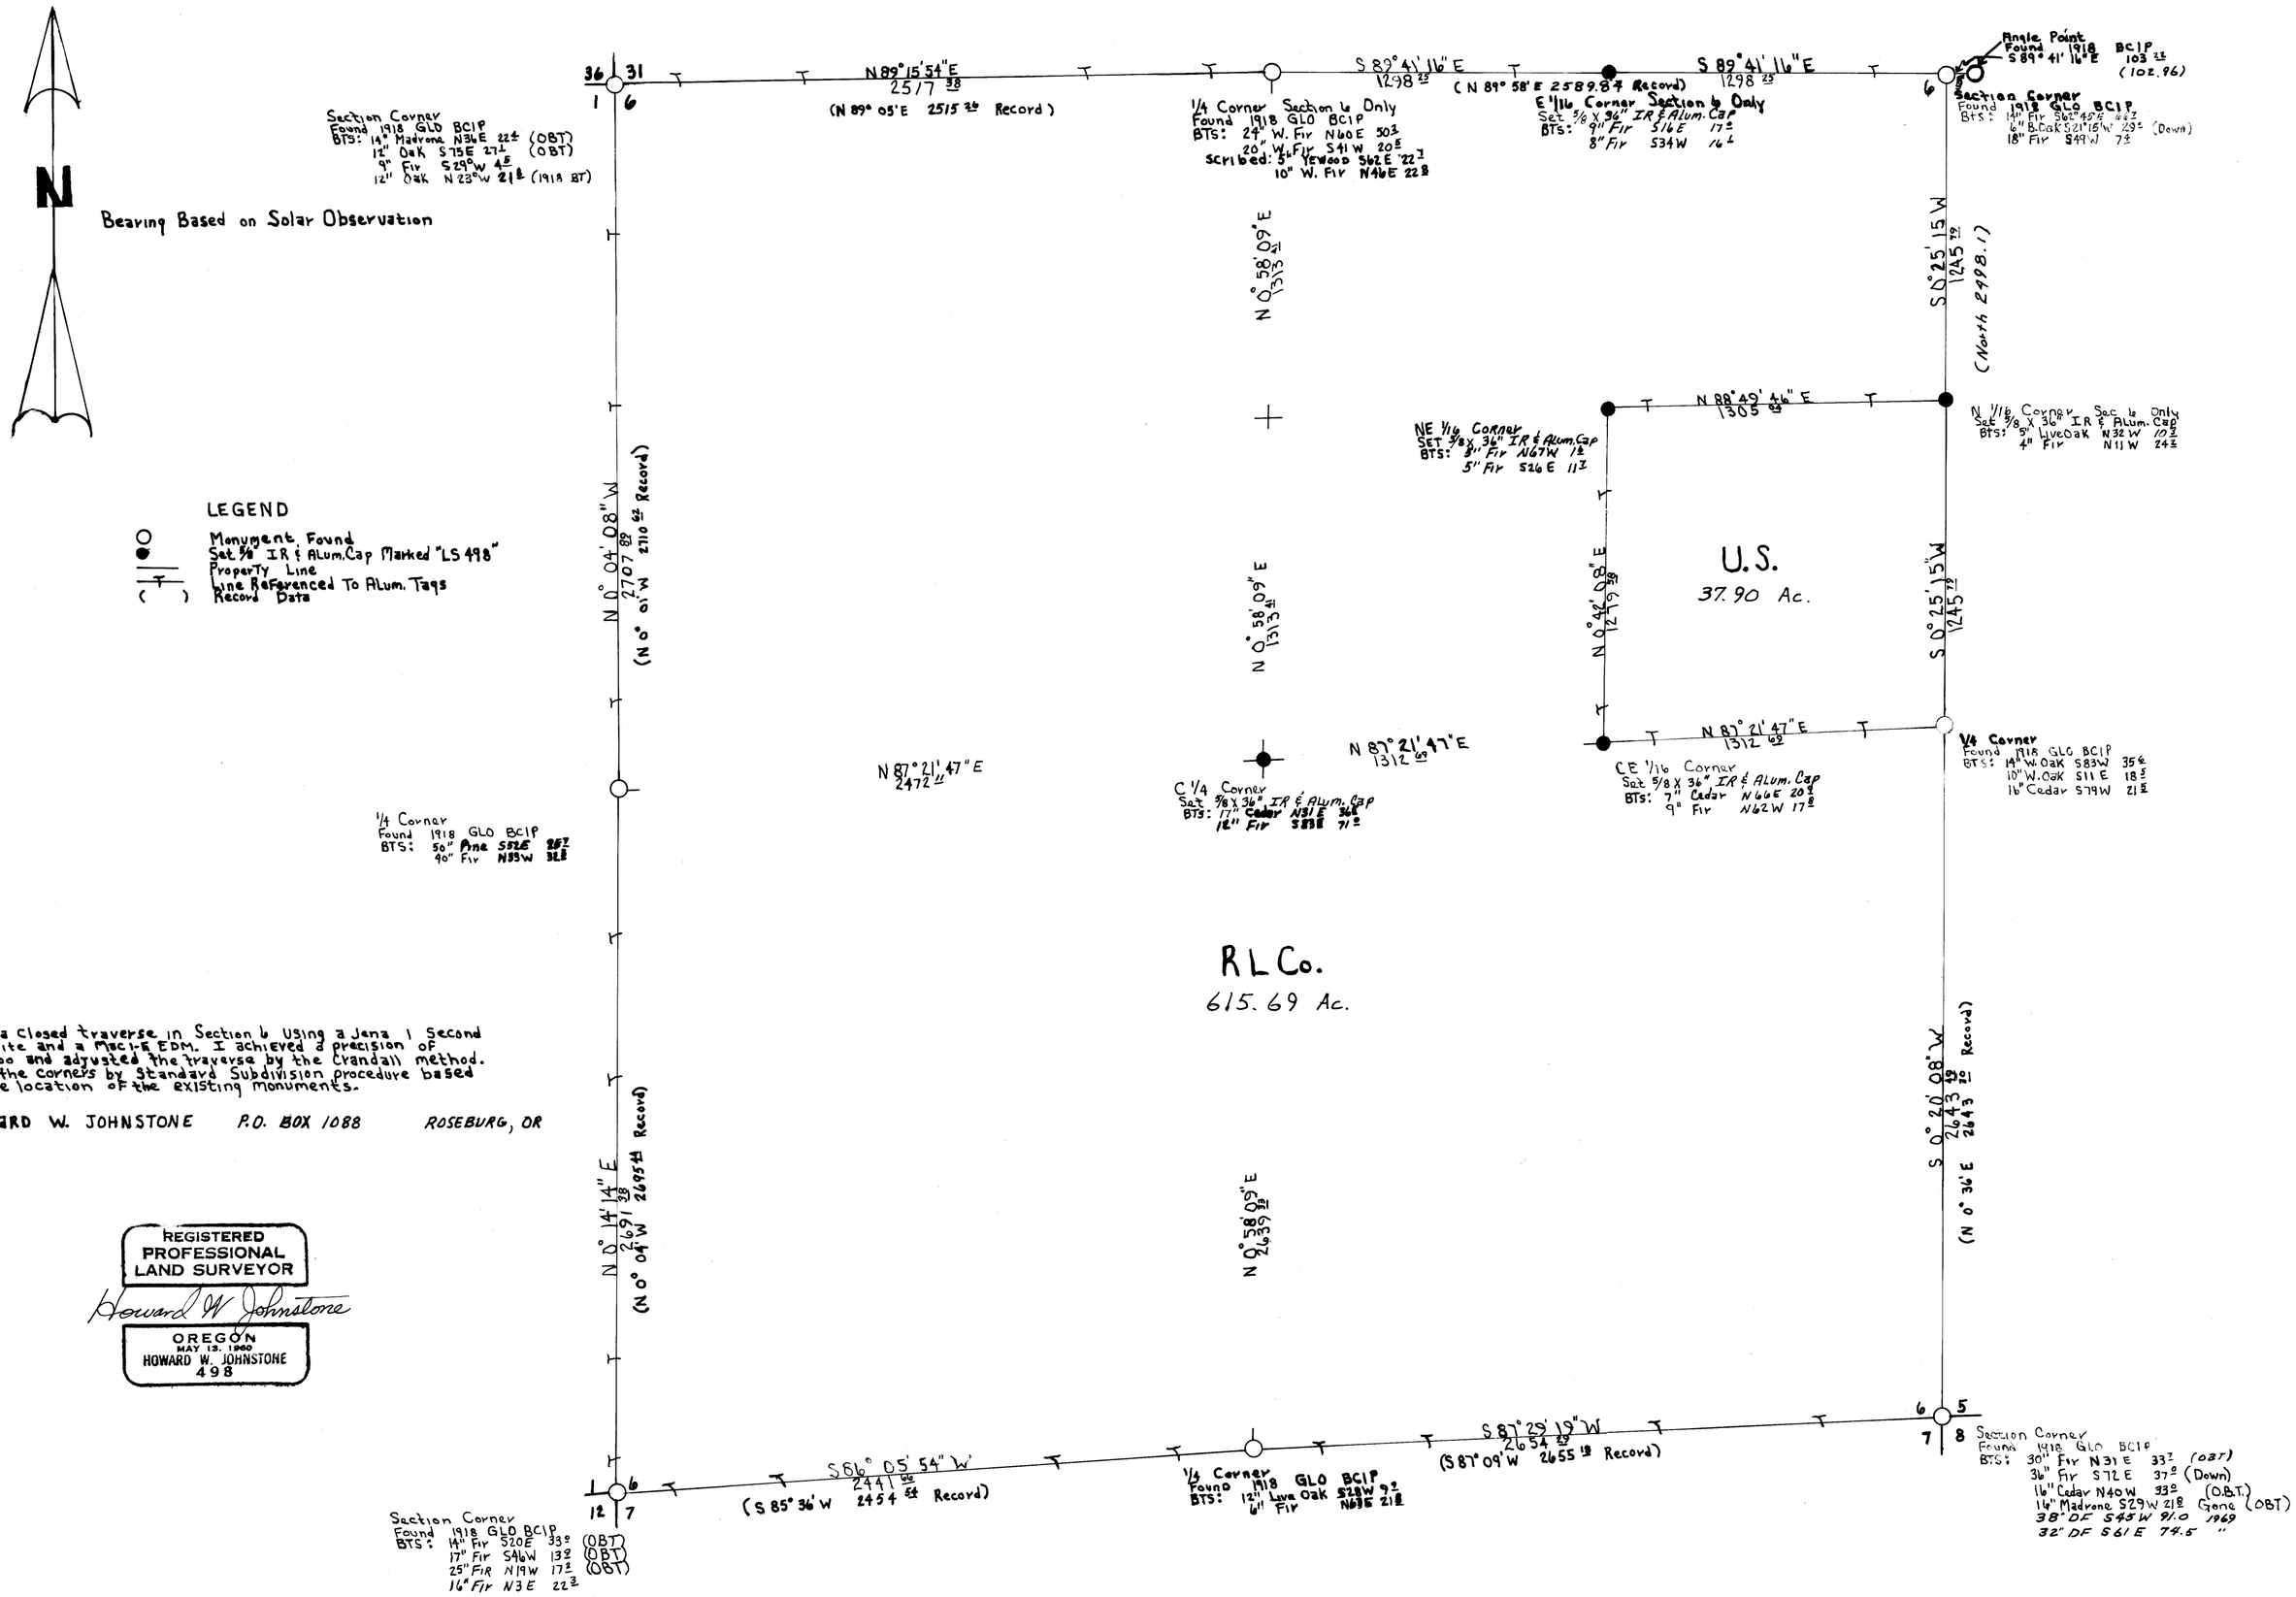

I ran a Closed traverse in Section 6 Using a Jena 1 Second Theodolite and a Mac-I-E EDM. I achieved a precision of 1:12,000 and adjusted the traverse by the Crandall method. I set the corners by Standard Subdivision procedure based on the location of the existing monuments.

HOWARD W. JOHNSTONE P.O. BOX 1088 ROSEBURG, OR

REGISTERED
PROFESSIONAL
LAND SURVEYOR
Howard W. Johnstone
OREGON
MAY 13, 1980
HOWARD W. JOHNSTONE
498

MAP FILE M 93-55

MAP FILE M 93-55