COUNTY SURVEYORS FILE DATA
DO NOT REMOVE FROM OFFICE

SURVEY IN N 1/2 OF SECTION 16, T.29S., R.6W., W.M.

SEE M42-35 FOR RECORD

MARCH 1983

SCALE: 1" = 200'

FILED
RECEIVED
MAR 30 1983
COUNTY SURVEYOR
DOUGLAS COUNTY, ORE.

MAP FILE M 93-65

FOR:
MR. & MRS. THOMAS HAIRE

BY:
ROMEY WARE, L.S.
2771 GARDEN VALLEY BLVD.
ROSEBURG, OREGON

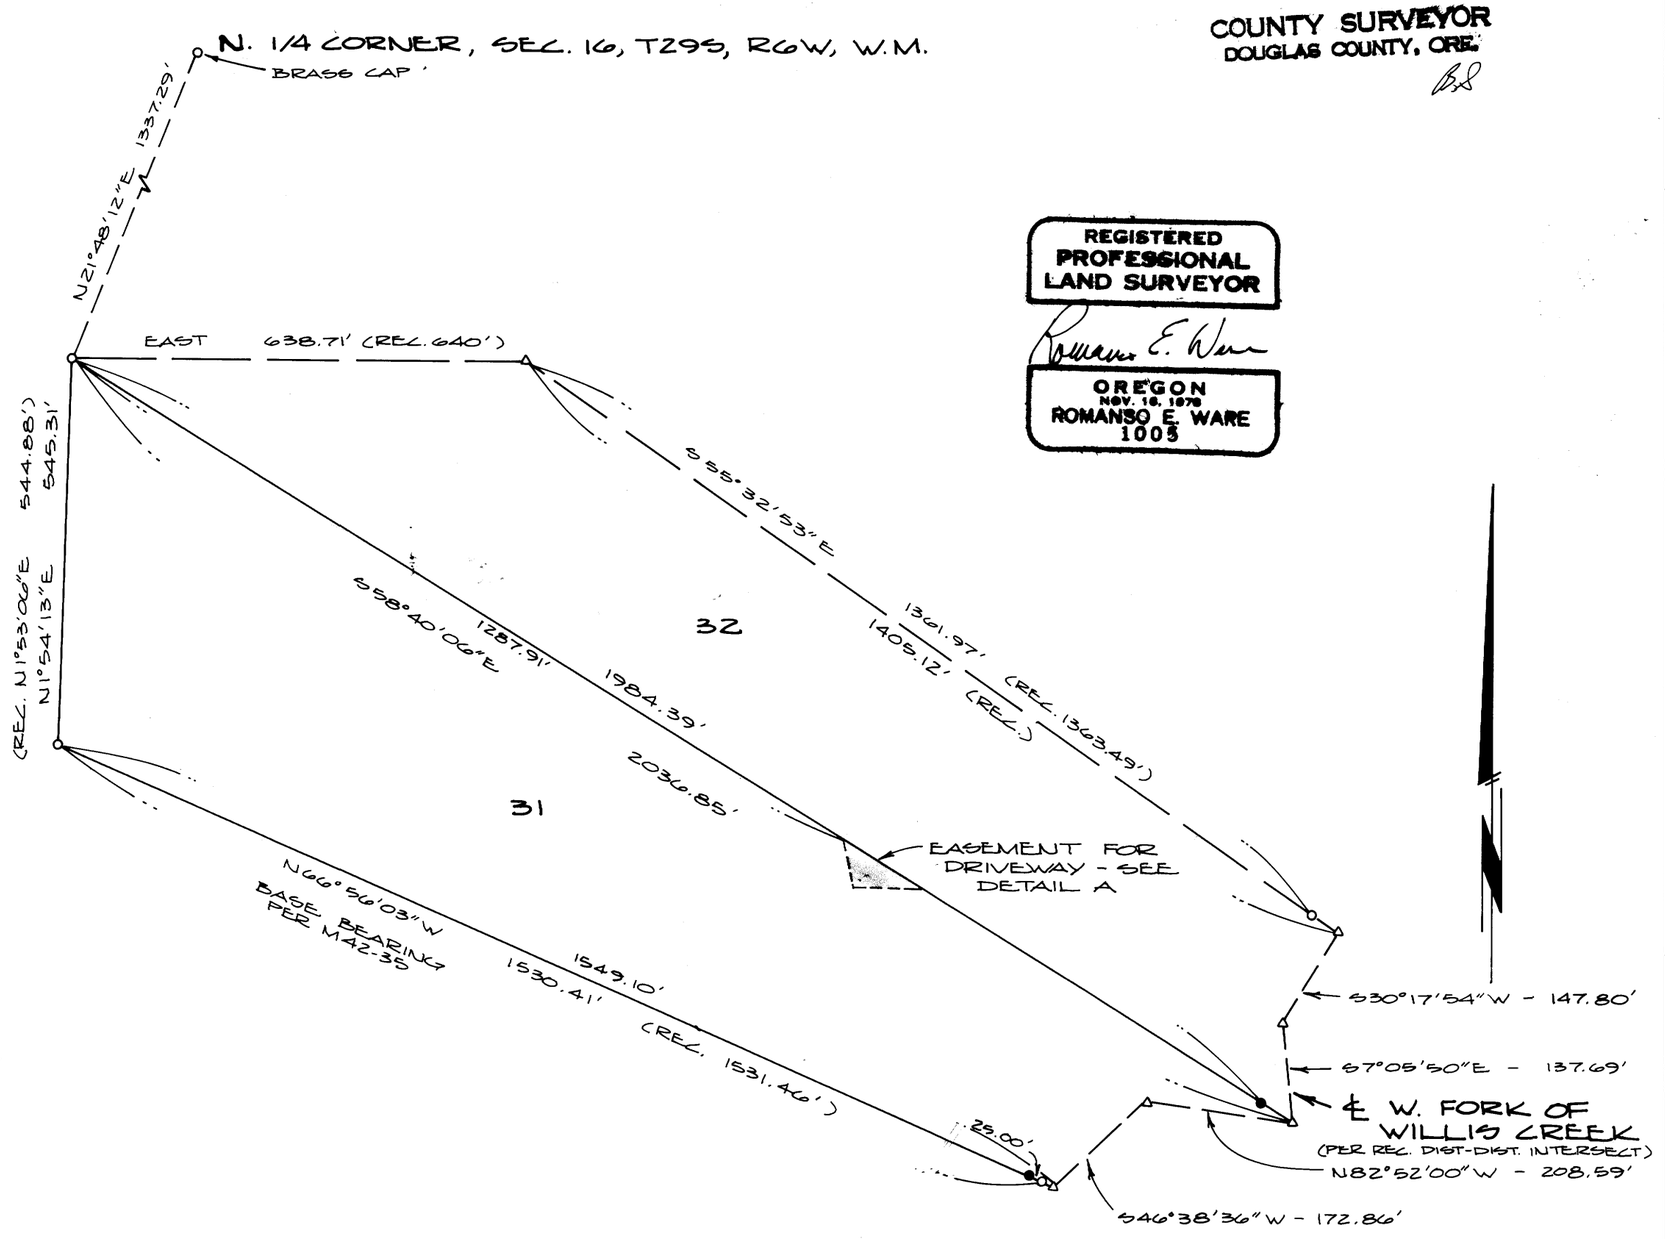

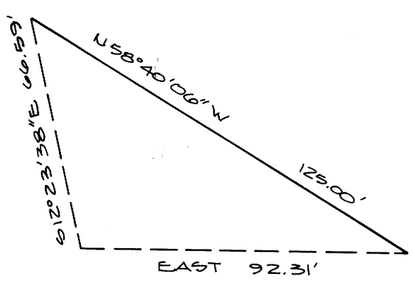

DETAIL A
EASEMENT FOR DRIVEWAY

REGISTERED PROFESSIONAL LAND SURVEYOR
Romanso E. Ware
OREGON
NOV. 16, 1978
ROMANSO E. WARE
1005

NARRATIVE:

SURVEY FOR THE PURPOSE OF FLAGGING THE WEST AND NORTHERLY LINES OF PARCEL 31 AND RESETTING THE MONUMENTS AS SHOWN ALONG WILLIS CREEK. THE NORTHERLY LINE WAS ESTABLISHED BY RECORD BEARING. FIELD CREWS CONSISTED OF R. WARE AND M. RIGGAN. EQUIPMENT WAS WILD T-16 MOUNTED WITH NIKKON NDIGO E.D.M. DRAFTING BY D. HOPKINS.

LEGEND:

● - SET 5/8" x 30" IRON ROD WITH CAP MKD. "R.E. WARE L.S. 1005"

○ - FOUND 5/8" IRON ROD UNLESS NOTED OTHERWISE

△ - COMPUTED POINT ONLY

MAP FILE M 93-65