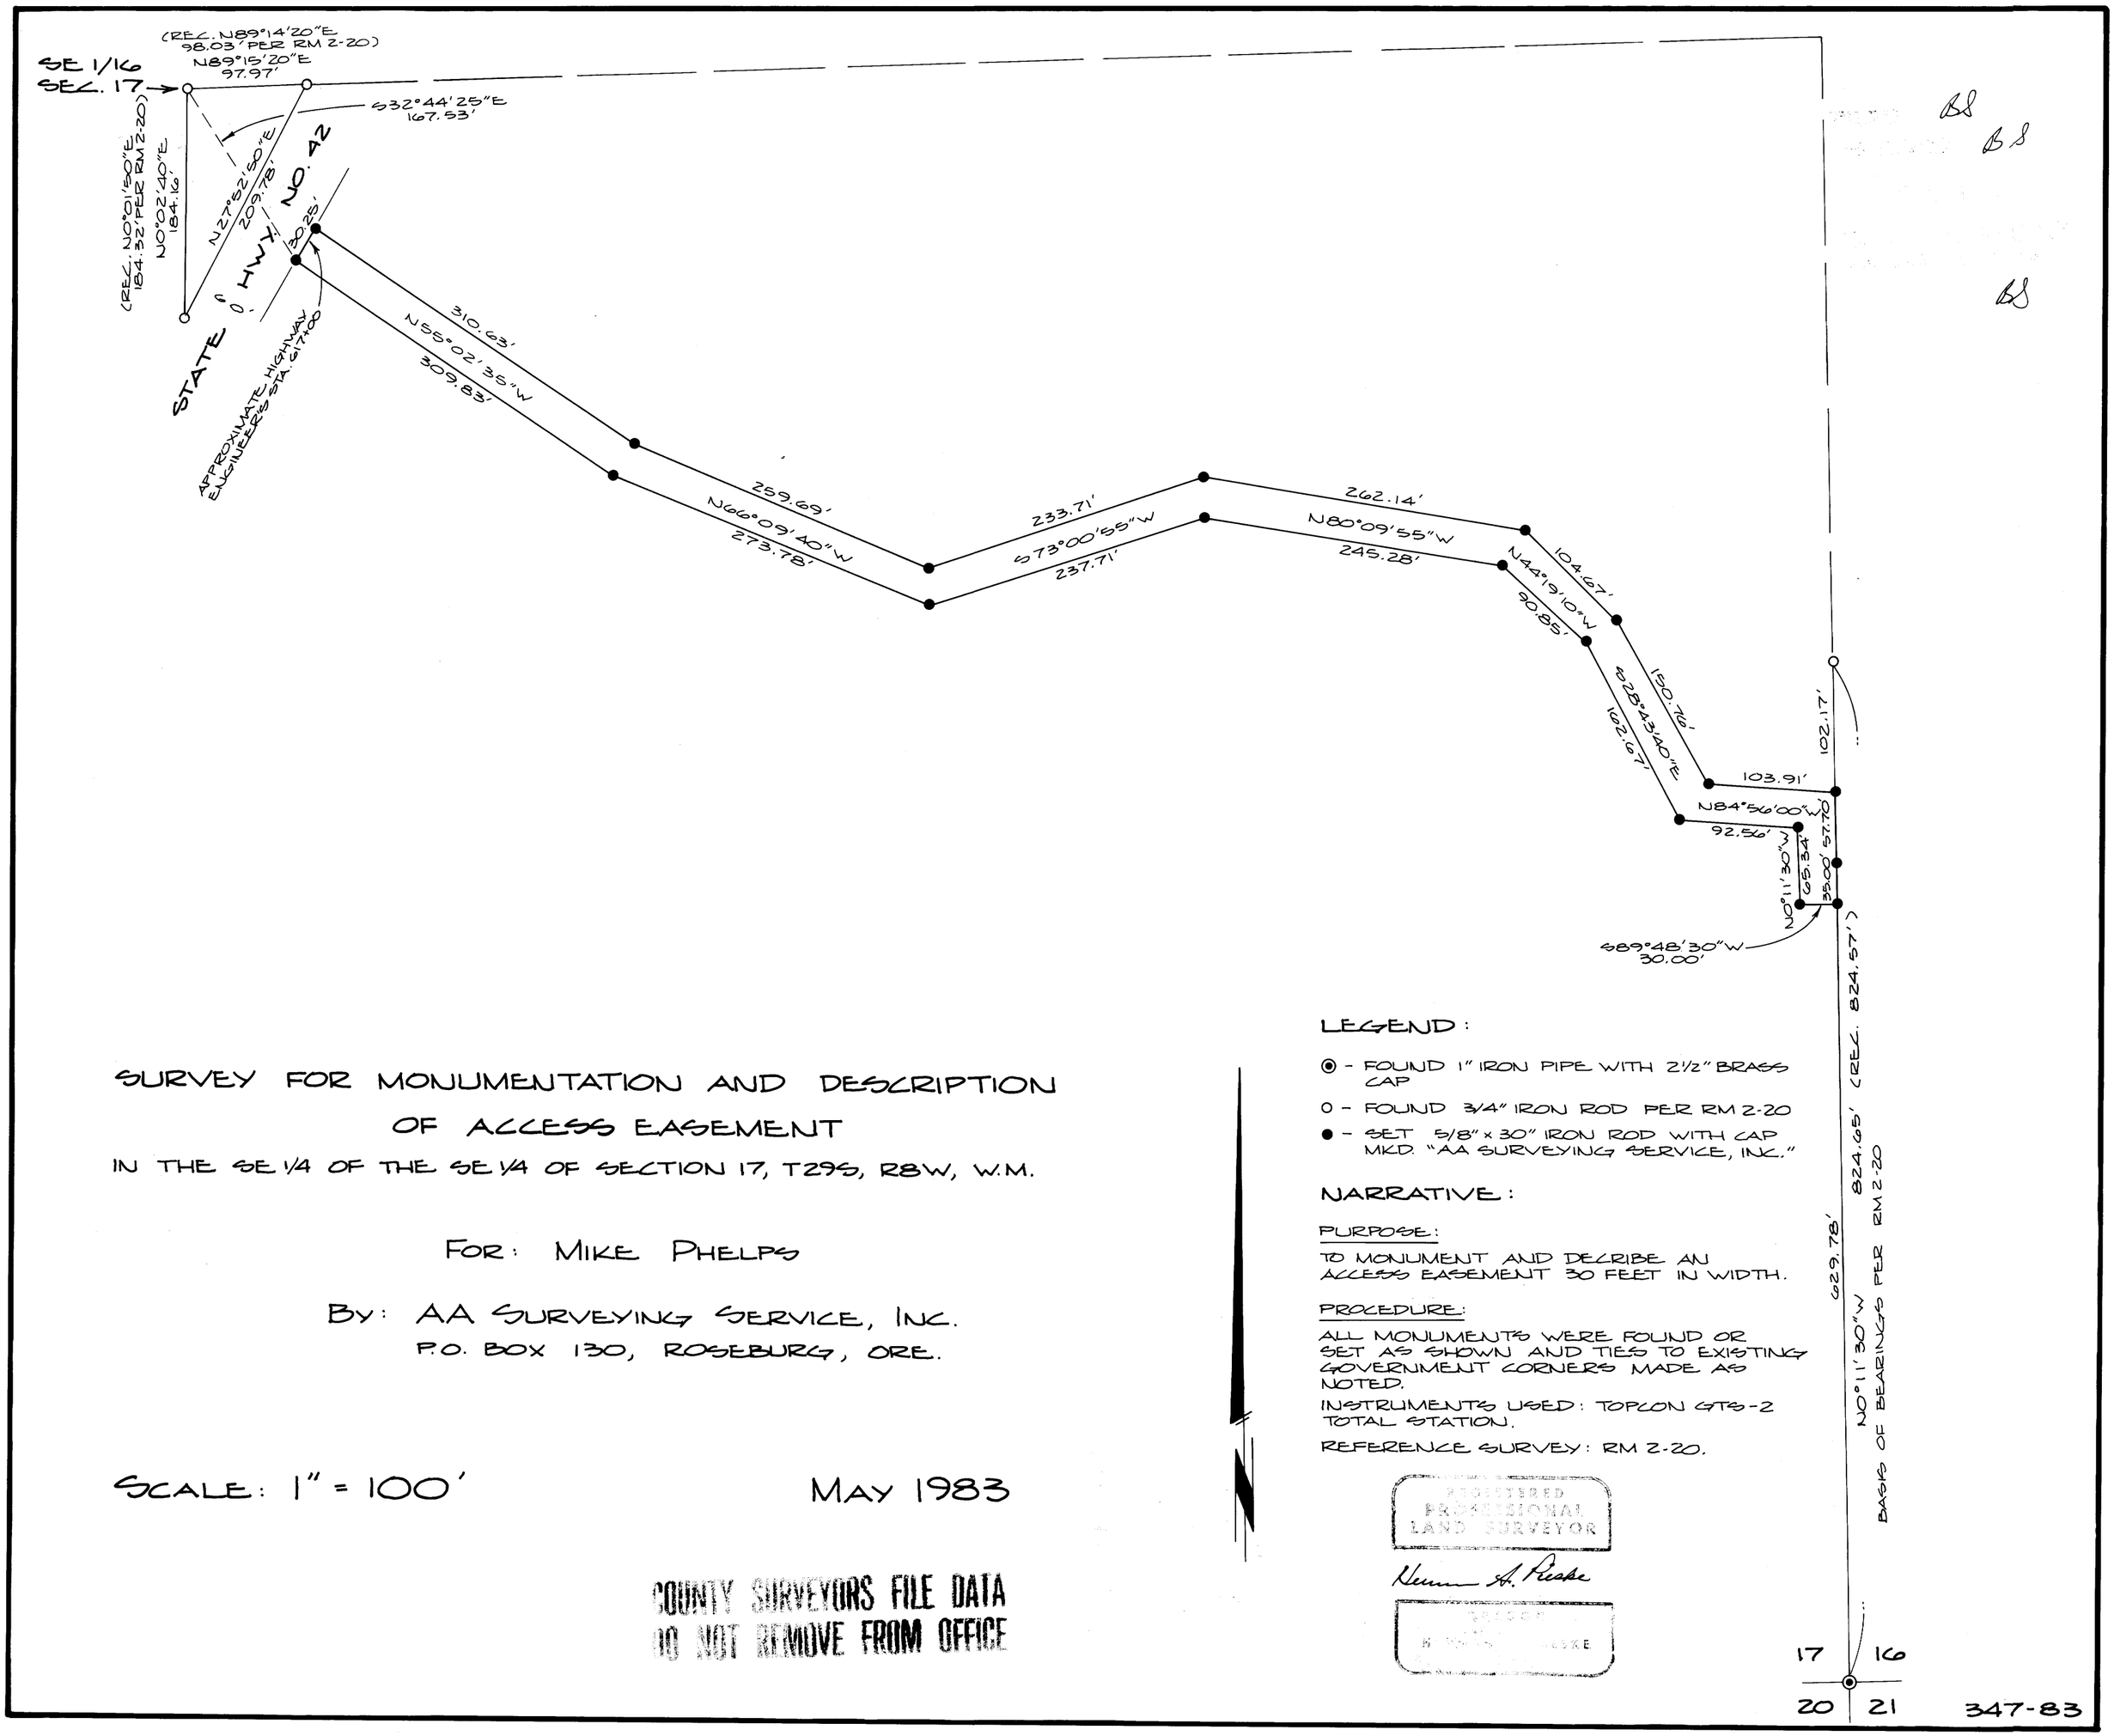

SURVEY FOR MONUMENTATION AND DESCRIPTION OF ACCESS EASEMENT

IN THE SE 1/4 OF THE SE 1/4 OF SECTION 17, T29S, R8W, W.M.

FOR: MIKE PHELPS

BY: AA SURVEYING SERVICE, INC.
P.O. BOX 130, ROSEBURG, ORE.

SCALE: 1" = 100'

MAY 1983

COUNTY SURVEYORS FILE DATA
DO NOT REMOVE FROM OFFICE

LEGEND:

- ⊙ - FOUND 1" IRON PIPE WITH 2½" BRASS CAP
- O - FOUND 3/4" IRON ROD PER RM 2-20
- ● - SET 5/8" x 30" IRON ROD WITH CAP MKD. "AA SURVEYING SERVICE, INC."

NARRATIVE:

PURPOSE:

TO MONUMENT AND DECRIBE AN ACCESS EASEMENT 30 FEET IN WIDTH.

PROCEDURE:

ALL MONUMENTS WERE FOUND OR SET AS SHOWN AND TIES TO EXISTING GOVERNMENT CORNERS MADE AS NOTED.

INSTRUMENTS USED: TOPCON GTS-2 TOTAL STATION.

REFERENCE SURVEY: RM 2-20.

REGISTERED PROFESSIONAL LAND SURVEYOR

Herman A. Peake

OREGON

HERMAN A. PEAKE

347-83

M 94-17