FILED BS
RECEIVED BS

COUNTY SURVEYORS FILE DATA
DO NOT REMOVE FROM OFFICE

MAY 26 1983

COUNTY SURVEYOR
DOUGLAS COUNTY, ORE.

SURVEY NARRATIVE TO COMPLY WITH PARAGRAPH 209.250 OREGON REVISED STATUTES.
BS

MAP FILE M 94-19

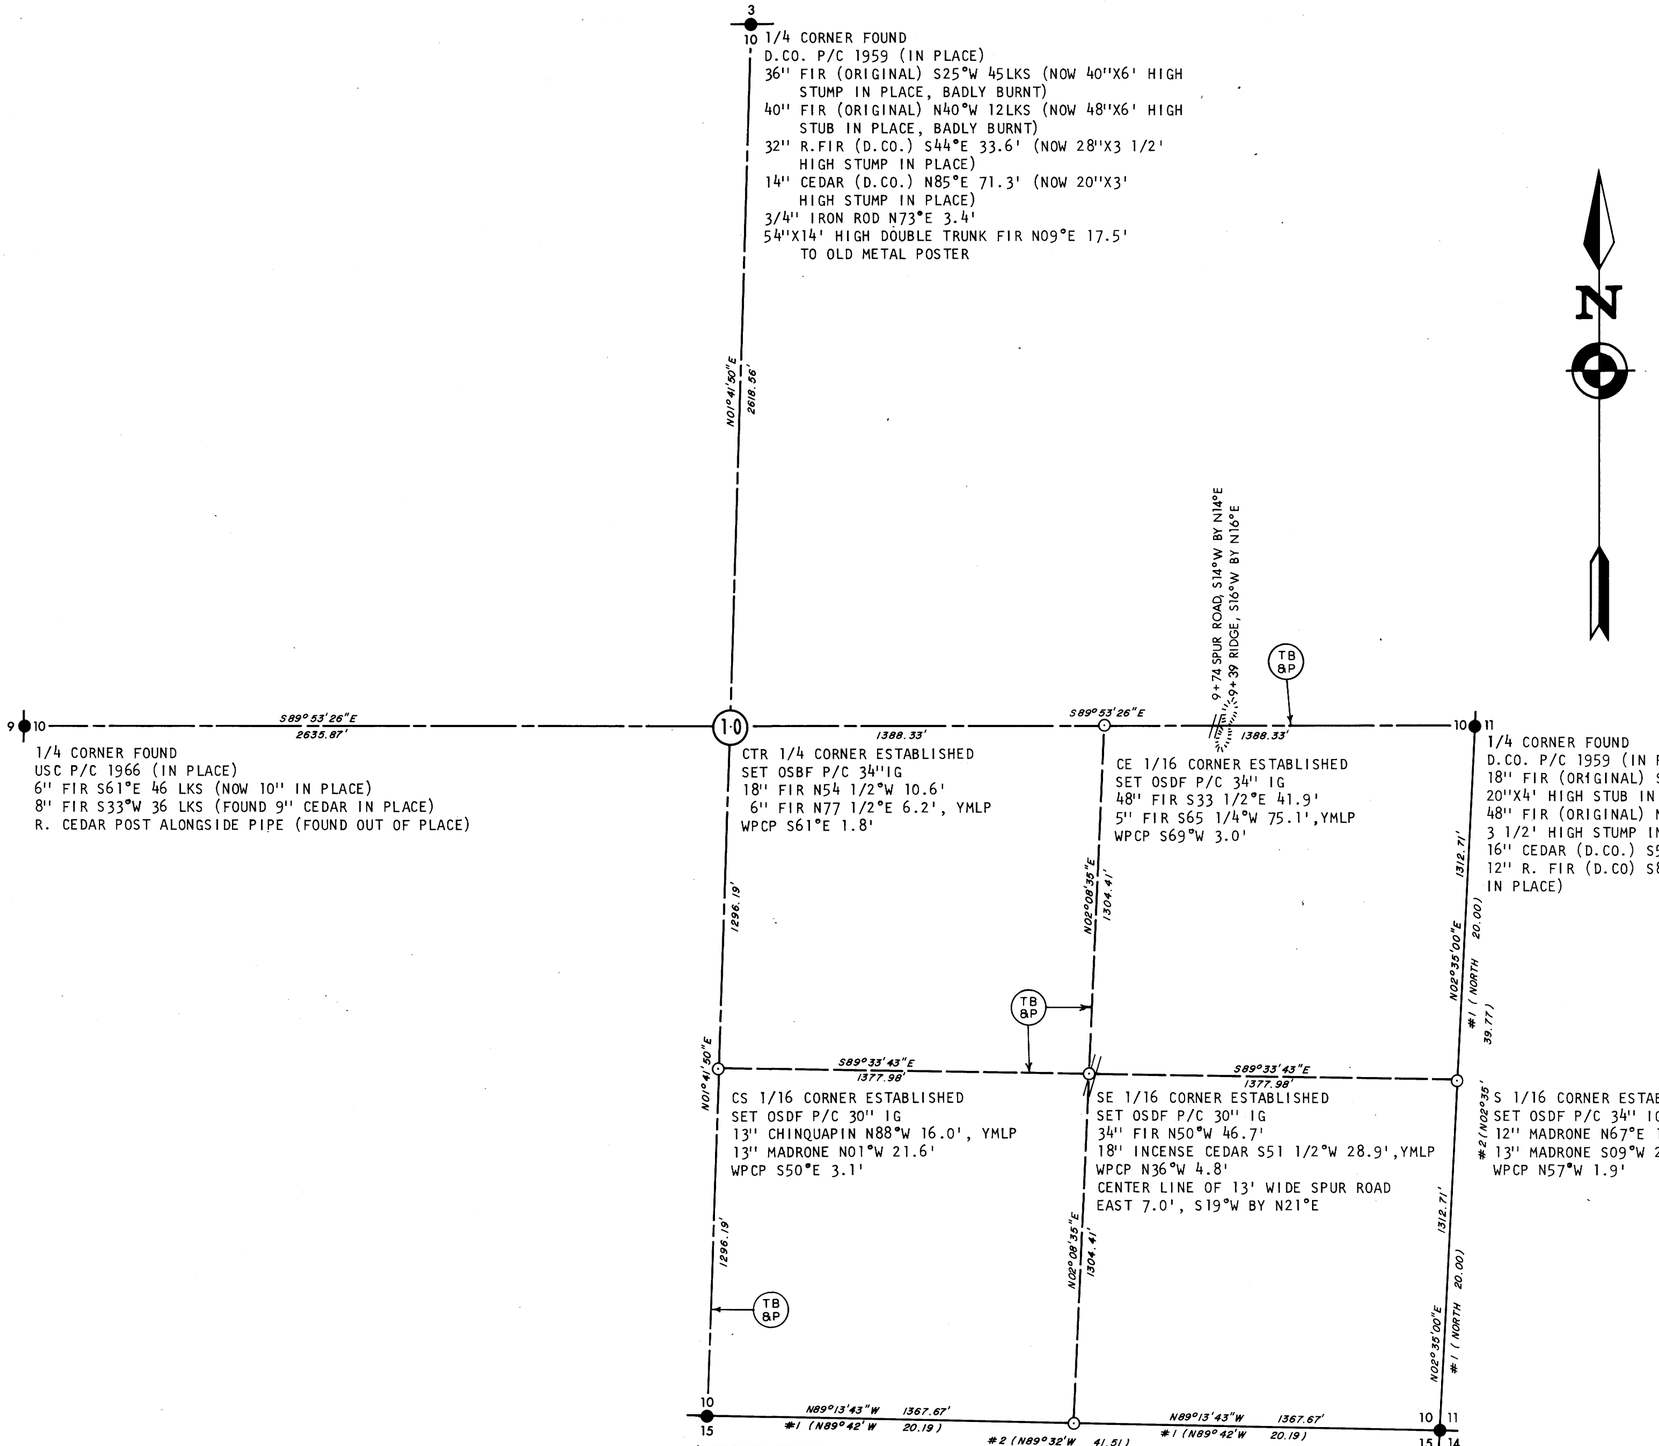

LEGEND

OSDF P/C=OREGON STATE DEPARTMENT OF FORESTRY
1 1/2"X36" ALUMINUM PIPE WITH 3 3/4" ALUMINUM CAP WITH MAGNETIC INSERT
USC P/C =UNITED STATES CADASTRAL 2 1/2" IRON PIPE WITH 3" BRASS CAP
D.CO.P/C=DOUGLAS COUNTY 1" IRON PIPE WITH 2 1/2" BRASS CAP
⊙ =MONUMENT SET
● =MONUMENT FOUND
WPCP =4"X4"X72" WHITE PAINTED CEDAR POST
YMLP =YELLOW METAL LOCATION POSTER
IG =IN GROUND
TB & P → =TRUE BLAZED AND POSTED
#1 ( ) =RECORD BEARINGS AND DISTANCES IN CHAINS (W.H. BYARS, 1881, CONTARCT NO.420)
#2 ( ) =RECORD BEARINGS AND DISTANCES IN CHAINS (USC,1966)
ESTABLISHED=NEW CORNER SET

BASIS OF BEARING

BEARINGS BASED ON THE 1966 UNITED STATES CADASTRAL SURVEY OF THE SECTION LINE BETWEEN THE ONE QUARTER CORNER COMMON TO SECTIONS 10 AND 11 AND THE SECTION CORNER COMMON TO SECTIONS 10,11,14 AND 15.

PURPOSE

TO SEPARATE STATE FOREST LANDS AND PRIVATE LANDS LOCATED IN SECTION 10, TOWNSHIP 32 SOUTH, RANGE 6 WEST, WILLAMETTE MERIDIAN.

PROCEDURE

A RANDOM TRAVERSE WAS USED TO CONNECT THE CONTROLLING CORNERS GOVERNING THE SUBDIVISION OF SECTION 10, TOWNSHIP 32 SOUTH, RANGE 6 WEST, WILLAMETTE MERIDIAN. THIS SECTION WAS SUBDIVIDED USING THE PROCEDURES AS OUTLINED IN THE "MANUAL OF INSTRUCTIONS FOR THE SURVEY OF THE PUBLIC LANDS OF THE U.S." BEARINGS TO ACCESSORIES FOR ESTABLISHED CORNERS WERE TAKEN WITH A STAFF COMPASS SET AT 20°30'EAST MAGNETIC DECLINATION. NEW CORNERS AND ACCESSORIES MARKED ACCORDING TO "MANUAL OF INSTRUCTIONS FOR THE SURVEY OF THE PUBLIC LANDS OF THE U.S." DISTANCE MEASURED TO BEARING TREE FACE. FOR DETAILED REPORT ON FOUND CORNERS SEE COUNTY RECORDS.

SURVEYED BY:

REGISTERED PROFESSIONAL LAND SURVEYOR
Lloyd D. Smith
OREGON
JULY 22, 1977
LLOYD D. SMITH
1101

LLOYD D. SMITH
300 5th STREET, BAY PARK
COOS BAY, OREGON

SURVEY FOR:
STATE OF OREGON-DEPARTMENT OF FORESTRY

SECTION 10, T.32S., R.6W., W.M.

DOUGLAS COUNTY, OREGON
THEODOLITE & E.D.M. SURVEY BY: LLOYD D. SMITH, J.MC INTOSH, A. KOREIVA AND D. TAYLOR
DRAWN BY: J. MC INTOSH
APRIL 27, 1983
SCALE:1"=400'

B-251
FB 5/9/83

MAP FILE M 94-19

B-251