
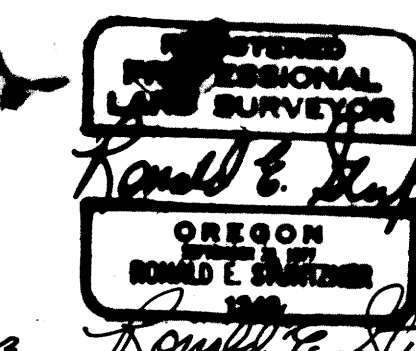


CORNER NOTES

MARCH 18, 1983

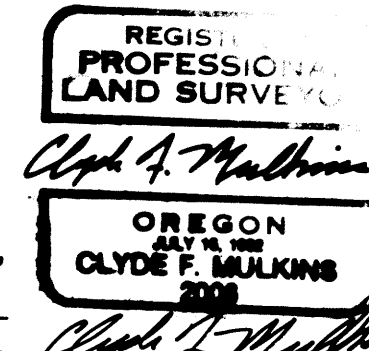

- 1 T185 R9W  
S31  
S32  
1929  
Fd. G.L.O. BCIP, mkd. as shown, established in 1929, from which: fd. 32 in. Doug fir, est. 1929, bears S10°W, 7.8 ft., with healed face; set 27 in. Doug fir, bears S51°E, 45.2 ft., scribed "T195 R9W CC S5 BT".
- 2 SC  
T185 R9W  
S31 S32  
1929  
Fd. G.L.O. BCIP, mkd. as shown, proportioned in 1929, from which: fd. 82 in. Doug fir, est. 1929, bears N17½°E, 59.1 ft., with healed face; set 34 in. Doug fir, bears N52°W, 24.8 ft., scribed "T185 R9W S31 BT".
- 3 T185 R9W  
S6  
EW1/256  
T195 R9W  
1983  
PLS 2006  
Set standard U.S.F.S. monument, mkd. as shown, from which: set 12 in. Maple, bears S72°W, 6.7 ft., scribed "EW1/256 S6 BT"; set 28 in. Doug fir, bears S18°E, 25.3 ft., scribed "EW1/256 S6 BT", face bears N10°E.
- 4 T185 R9W  
S6  
T195 R9W  
1983  
PLS 2006  
Set standard U.S.F.S. monument, mkd. as shown, from which: set 12 in. Hemlock, bears S32°W, 28.8 ft., scribed "N½ S6 BT"; set 18 in. Hemlock, bears S28°E, 16.0 ft., scribed "N½ S6 BT".
- 5 T185 R9W  
SC  
S31  
1977  
PLS 1091  
Fd. 2½ in. BCIP perpetuating a corner proportion in 1929, mkd. as shown, from which: fd. 48" Doug fir stump, est. 1929, bears N84°W, 70.8 ft.; fd. 32 in. Doug fir stump, est. 1929, bears N53°W, 42.2 ft.; fd. 18" Alder, bears N57°W, 64.7 ft., bark scribed; fd. 10 in. Doug fir, bears N11°E, 138.0 ft., visible scribe.
- 6 T185 R9W  
S31  
S1/56  
R10W R9W  
T195  
CC  
1929  
Fd. G.L.O. BCIP mkd. as shown, perpetuated in 1929, from which: fd. 32 in. Doug fir, est. 1929, bears S52°W, 72.0 ft., healed face; fd. 15 in. Doug fir, est. 1929, bears S42½°E, 4.0 ft., healed face.
- 7 SC  
T185  
R10W R9W  
S31 S32  
1929  
Fd. G.L.O. BCIP, mkd. as shown, perpetuated in 1929, from which: fd. 24 in. Doug fir, est. 1929, bears N12½°W, 54.0 ft., healed face; fd. 38 in. Doug fir, est. 1929, bears N65½°E, 72.6 ft., healed face.
- 8 T195  
N1/16  
S1  
PLS 752  
1978  
Fd. standard U.S.F.S. monument, mkd. as shown, from which: fd. 21 in. Alder, bark scribed "N1/16 S1 BT", bears S18°W, 13.4 ft.; fd. 13 in. Alder, bark scribed "N1/16 S1 BT", bears N87°W, 56.8 ft.
- 9 S6  
T195  
R9W  
1958  
Fd. B.L.M. BCIP mkd. as shown, proportioned in 1958, from which: fd. 18" Cedar, est. 1958, bears S53½°E, 77.3 ft., healed face; fd. up-rooted maple, est. 1958, record N77½°E, 76.6 ft.; set 36 in. Cedar, bears S81°E, 81.6 ft., scribed "½ S6 BT".
- 10 S6  
T195  
S1  
R10W  
1957  
Fd. B.L.M. BCIP mkd. as shown, perpetuated in 1957, from which: fd. 38 in. Doug fir, original B.T., bears N42°W, 39.4 ft., healed face; fd. 30 in. Doug fir, original B.T., bears S60°W, 73.9 ft., healed face.
- 11 T195 R9W  
S6  
S1/16  
PLS 752  
1979  
Fd. standard U.S.F.S. monument mkd. as shown, est. 1979 by private surveyor, from which: fd. 49 in. Doug fir, bears N1°E, 56.5 ft., healed face with "BT" scribe visible; fd. 26 in. Hemlock, bears N56°E, 14.9 ft., scribed "S1/16 S6 BT".
- 12 T195  
S6  
S1  
R10W R9W  
1958  
Fd. B.L.M. BCIP mkd. as shown, est. 1958, from which: fd. 15 in. Doug fir, est. 1958, bears N56°E, 71.6 ft., healed face; fd. 18 in. Doug fir, bears S55°E, 76.1 ft., visible scribe; fd. 16 in. Doug fir, bears S10°W, 75.4 ft., visible scribe; fd. 13 in. Doug fir bears N51°W, 2.3 ft., healed blaze.
- 13 S6  
S7  
T195 R9W  
1958  
Fd. B.L.M. BCIP, mkd. as shown, perpetuated in 1958, from which: fd. 12" original Doug fir snag, bears N24°E, 9.6 ft.; fd. 27 in. Doug fir snag, est. in 1958, bears N22°E, 25.3 ft., healed face; fd. 25 in. Hemlock, est. in 1958, bears S27°E, 56.6 ft., open face scribing visible; fd. 19 in. Hemlock, bears S68°E, 13.7 ft., healed face.
- 14 T195 R9W  
E1/16 S6  
S7  
1983  
PLS 2006  
Set standard U.S.F.S. monument, mkd. as shown, from which: set 15 in. Hemlock, bears S29°W, 19.8 ft., scribed "E1/16 S7 BT"; set 19 in. Doug fir, bears N34°E, 21.2 ft., scribed "E1/16 S6 BT".
- 15 T195 R9W  
S6 S5  
S7 S8  
1958  
Fd. B.L.M. BCIP, mkd. as shown, proportioned in 1958, from which: fd. 32 in. Doug fir, est. in 1958, bears S84°W, 229.0 ft., healed face; fd. 23 in. Doug fir, est. in 1958, bears N25°W, 67.3 ft., healed face; fd. 21 in. Doug fir, est. in 1958, bears N83°E, 167.0 ft., healed face; fd. 26 in. Doug fir, est. in 1958, bears S75°E, 139.3 ft., healed face.
- 16 EEW 1/256  
S5  
S8  
1983  
PLS 2006  
Set standard U.S.F.S. monument, mkd. as shown, from which: set 28 in. Hemlock, bears S30°E, 8.1 ft., scribed "EEW1/256 S8 BT"; set 22 in. Hemlock, bears N44°W, 6.6 ft. scribed "EEW1/256 S5 BT".
- 17 S5  
S8  
1958  
Fd. B.L.M. BCIP, mkd. as shown, proportioned in 1958, from which: fd. 21 in. Alder, est. in 1958, bears N64°W, 55.3 ft., visible scribe "½ BT"; fd. 40 in. Doug fir, est. in 1958, bears S28°E, 49.5 ft., healed face.
- 18 T195 R9W  
E1/16 S5  
S8  
1983  
PLS 2006  
Set standard U.S.F.S. monument, mkd. as shown, from which: set 14 in. Hemlock, bears S20°W, 30.9 ft., scribed "E1/16 S8 BT", set 40 in Doug fir, bears N09°E, 30.9 ft., scribed "E1/16 S5 BT".
- 19 RM  
T195 R9W  
S5  
5.00  
S8 S46E  
S8  
1983  
PLS 2006  
Fd. original corner tree, 11 in. Doug fir snag, from which: fd. 32 in. Doug fir, original BT, bears S50°W, 17.2 ft., healed face; fd. 12 in. Doug fir, original BT, bears S63°E, 5.9 ft., open face with "R9W S9" visible scribing; fd. 11 in. Doug fir snag, original BT, bears N69°E, 8.5 ft., healed face; fd. 14 in. Doug fir, original BT, bears N35°W, 3.9 ft., healed face; fd. 24 in. Doug fir, est. in 1958, bears N61½°E, 33.0 ft., healed face; set 18 in. Doug fir, bears S8°E, 36.7 ft., scribed "T195 R9W S9 BT"; set standard U.S.F.S. reference monument, mkd. as shown, bears N88°46'W, 5.00 ft.
- 20 NSS 1/256  
S5 S4  
1978  
PLS 1342  
Fd. standard U.S.F.S. monument, mkd. as shown, from which: fd. 34 in. Doug fir, bears S62½°W, 5.8 ft., face pitched over; fd. 15 in. Doug fir, bears N63°E, 16.5 ft., face pitched over.
- 21 T195 R9W  
S1/16  
S5 S4  
1978  
PLS 1342  
Fd. standard U.S.F.S. monument, mkd. as shown, from which: fd. 27 in. Doug fir, bears S18°E, 15.5 ft., scribed "S4 1/16 BT"; fd. 34 in. Doug fir bears S70°W, 19.1 ft., visible scribe.
- 22 T195 R9W  
S5 S4  
SNS 1/256  
1978  
PLS 1342  
Fd. standard U.S.F.S. monument, mkd. as shown, from which: fd. 24 in. Alder, bears S34°W, 77.3 ft., bark scribed "SNS 1/256 BT"; fd. 32 in. Alder, bears S55°E, 35.8 ft., bark scribed "SNS 1/256 BT".
- 23 S6  
S5 S4  
T195 R9W  
1958  
Fd. B.L.M. BCIP mkd. as shown, proportioned in 1958, from which: 1958, 12 in. Doug fir, bears S38½°E, 104" (REC. S38.5 E 29 lks.) healed face; 1958, 7 in. Doug fir bears N59.5°W, 30.4 ft., (REC. N59.5°W, 31.0 ft.), DOWN SNAG; set 26 in. Doug fir, bears N72°W, 56.9 ft., scribed "½ S5 BT".  
MY 1978 ALDER BT IS UPROOTED STUMP, SEE REPLACED BT ABOVE
- 24 T195 R9W  
SSN 1/256  
1978  
PLS 1342  
Fd. standard U.S.F.S. monument, mkd. as shown, established in 1978, from which: fd. 32 in. Hemlock, bears N45°W, 12.8 ft., visible scribed; fd. 29 in. Hemlock, bears N39°E, 11.1 ft., visible scribe.
- 25 T185 R9W  
S33  
S5 S4  
T195 R9W  
CC  
1929  
Fd. G.L.O. BCIP, mkd. as shown, perpetuated in 1929, from which: fd. 42 in. Doug fir, original BT, bears S30°W, 42.2 ft., healed face; fd. 42 in. Doug fir snag, original BT, bears S6°E, 26.4 ft., open face, visible scribe "T195 R"; set 37 in. Doug fir, bears S32°E, 64.9 ft., scribed "T195 R9W CC S4 BT".
- 26 AP  
S5  
T195 R9W  
1929  
Fd. G.L.O. BCIP, mkd. as shown, perpetuated in 1929 as an angle point on the township line, originally established as a standard corner to Sections 4 and 5, from which: fd. 44 in. Doug fir, est. 1929, bears S44°W, 42.2 ft., healed face; fd. 36 in. Doug fir, est. in 1929, bears S41½°E, 37.6 ft., face healed.
- 27 SC  
T185 R9W  
S32 S33  
1929  
Fd. G.L.O. BCIP, mkd. as shown, proportioned in 1929, from which: fd. 12 in. Doug fir, est. in 1929, bears N74°W, 9.8 ft., face healed; fd. Doug fir snag, est. in 1929, bears N23°E 22.1 ft., visible scribing "S R9W S33 SC"; fd. 14 in. Doug fir, bears N1°E, 10.9 ft., I scribe "T185, R9W S33 BT".
- 28 T185 R9W  
S5  
T195 R9W  
1983  
PLS 2006  
Set standard U.S.F.S. monument, mkd. as shown, from which: set 18 in. Doug fir, bears S86°W, 15.3 ft., scribed "N½ S5 BT"; set 10 in. Doug fir, bears S16°W, 7.1 ft., scribed "N½ S5 BT".
- 29 SC  
S32 S33  
1929  
Fd. G.L.O. BCIP, mkd. as shown, proportioned in 1929, from which: fd. 12 in. Alder, est. in 1929, bears N24°W, 20.6 ft., bark scribed; fd. 30 in. Doug fir, est. in 1929, bears N52°E, 9.3 ft., healed face.
- 30 S6  
S5  
T195 R9W  
1958  
Fd. B.L.M. BCIP, mkd. as shown, perpetuated in 1958, from which: fd. 33 in. Doug fir snag, original BT, bears N66°W, 61.4 ft.; fd. 45 in. Doug fir snag, original BT, bears S61°E, 27.7 ft.; fd. 25 in. Doug fir, est. in 1958, bears S75°E, 25.2 ft., healed face; fd. 32 in. Doug fir, est. in 1958, bears N60°W, 28.5 ft., healed face.
- 31 WC  
C-E-W-E1/256  
S6 ← 44.2  
1983  
PLS 2006  
Set standard U.S.F.S. monument, mkd. as shown from which: true CEW1/256 Sec. 6 bears N89°33'06" W, 44.20 ft., in Jump Creek; set 10 in. Alder, bears N47½°W, 22.7 ft., scribed "X BT"; set 12 in. Hemlock, bears N48½°E, 69.0 ft., scribed "X BT".
- 32 S6  
C-W-W-E  
1/256 +  
1983  
PLS 2006  
Set standard U.S.F.S. monument, mkd. as shown from which: set 10 in. Hemlock, bears S45°E, 5.3 ft., scribed "CWWE 1/256 S6 BT"; set 16 in. Alder, bears N26°W, 19.6 ft., bark scribed "CWWE 1/256 S6 BT".
- 33 T195 R9W  
C½ S6  
1983  
PLS 2006  
Set standard U.S.F.S. monument, mkd. as shown, from which: set 10 in. Hemlock bears N82°E, 9.5 ft., scribed "C½ S6 BT"; set 14 in. Hemlock bears N12°E, 7.7 ft., scribed "C½ S6 BT".
- 34 T195 R9W  
S1/16  
C  
S  
C  
S6  
1983  
PLS 2006  
Set standard U.S.F.S. monument, mkd. as shown, from which: set 32 in. Doug fir, bears N4°E, 14.8 ft., scribed "CS1/16 S6 BT"; set 29 in. Doug fir, bears S21°E, 14.0 ft., scribed "CS1/16 S6 BT".
- 35 S6  
C-W-W-SE  
1/256  
1983  
PLS 2006  
Set standard U.S.F.S. monument, mkd. as shown, from which: set 14 in. Doug fir, bears N62°E, 17.4 ft., scribed "CWWE1/256 S6 BT"; set 12 in. Doug fir, bears S48°W, 12.4 ft., scribed "CWWE1/256 S6 BT".
- 36 T195 R9W  
SE1/16 S6  
1983  
PLS 2006  
Set standard U.S.F.S. monument, mkd. as shown, from which: set 16 in. Hemlock, bears N87°W, 29.3 ft., scribed "SE1/16 S6 BT"; set 25 in. Alder, bears S25°E, 33.4 ft., bark scribed "SE1/16 S6 BT".
- 37 T195 R9W  
S1/16  
S6 S5  
1983  
PLS 2006  
Set standard U.S.F.S. monument, mkd. as shown, from which: set 24 in. Alder, bears N58°W, 23.2 ft., bark scribed "S1/16 S6 BT"; set 23 in. Hemlock, bears S60°E, 27.0 ft., scribed "S1/16 S5 BT".
- 38 T195 R9W  
SW1/16 S5  
1983  
PLS 2006  
Set standard U.S.F.S. monument, mkd. as shown, from which: set 10 in. Alder, bears N84°W, 55.3 ft., bark scribed "SW1/16 S5 BT"; set 24 in. Alder, bears S64°E, 39.9 ft., bark scribed "SW1/16 S5 BT".
- 39 S5  
C-N-SW  
1/64  
1983  
PLS 2006  
Set standard U.S.F.S. monument, mkd. as shown, from which: set 8 in. Doug fir, bears S13°W, 10.7 ft., scribed "CNSW1/64 S5 BT"; set 12 in. Doug fir, bears S60°E, 15.9 ft., scribed "CNSW1/64 S5 BT".
- 40 S5  
NE-SW  
1/64  
1983  
PLS 2006  
Set standard U.S.F.S. monument, mkd. as shown, from which: set 14 in. Hemlock, bears S13°W, 36.9 ft., scribed "NESW1/64 S5 BT"; set 10 in. Alder, bears S46°E, 10.4 ft., bark scribed "NESW1/64 S5 BT".
- 41 S5  
C-N-N-S  
1/256  
1983  
PLS 2006  
Set standard U.S.F.S. monument, mkd. as shown, from which: set 24 in. Doug fir, bears N28°E, 12.5 ft., scribed "CNNS1/256 S5 BT"; set 21 in. Doug fir, bears S14°E, 8.4 ft., scribed "CNNS1/256 S5 BT".
- 42 WC  
T195 R9W  
C  
S1/16  
C  
S5  
1983  
PLS 2006  
Set standard U.S.F.S. monument, mkd. as shown, from which: true CS1/16 Sec. 6 bears N89°02'37" W, 30.00 ft., in N. Fork Smith River; set 32 in. Doug fir, bears N8°E, 49.2 ft., scribed "X BT"; set 15 in. Alder, bears S86°W, 14.6 ft., bears "X BT".
- 43 S5  
C-W-W-SE  
1/256  
1983  
PLS 2006  
Set standard U.S.F.S. monument, mkd. as shown, from which: set 16 in. Hemlock, bears East, 12.7 ft., scribed "CWWE1/256 S5 BT"; set 10 in. Hemlock, bears N74°W, 14.6 ft., scribed "CWWE1/256 S5 BT".
- 44 S5  
C-W-SW-SE  
1/256  
1983  
PLS 2006  
Set standard U.S.F.S. monument, mkd. as shown, from which, set 10 in. Hemlock, bears N28°W, 28.2 ft., scribed "CWSWE1/256 S5 BT"; set 11 in. Alder, bears S22°W, 7.1 ft., bark scribed "CWSWE1/256 S5 BT".
- 45 S5  
C-E-SW-SE  
1/256  
1983  
PLS 2006  
Set standard U.S.F.S. monument, mkd. as shown, from which: set 24 in. Doug fir, bears N36°E, 13.8 ft., scribed "CESWSE1/256 S5 BT"; set 36 in. Doug fir, bears N70°W, 68.0 ft., scribed "CESWSE1/256 S5 BT".
- 46 S5  
NE-SW-SE  
1/256  
1983  
PLS 2006  
Set standard U.S.F.S. monument, mkd. as shown, from which: set 6 in. Doug fir, bears N81°E, 10.5 ft., scribed "NESWSE1/256 S5 BT"; set 4 in. Doug fir, bears S87°W, 11.3 ft., scribed "NESWSE1/256 S5 BT".
- 47 T195 R9W  
SE1/16 S5  
1983  
PLS 2006  
Set standard U.S.F.S. monument, mkd. as shown, from which: set 22 in. Doug fir, bears N84°E, 54.9 ft., scribed "SE1/16 S5 BT"; set 36 in. Doug fir, bears S67°W, 28.1 ft., scribed "SE1/16 S5 BT".

MAP FILE M-94-218