COUNTY SURVEYORS FILE DATA
DO NOT REMOVE FROM OFFICE

RECORD OF SURVEY

COOKED WASSEN CADASTRAL SURVEY
FOR THE U.S.D.A. FOREST SERVICE
SILUSLAW NATIONAL FOREST

SECTIONS 3, 4 & 5, T21S, R10W, W.M.
DOUGLAS COUNTY, OREGON
NOVEMBER 1983

NOTES:

1. BASIS OF BEARINGS & BEARINGS CHECKS ARE FROM SOLAR OBSERVATIONS.
2. ( ) INDICATES DATA OF RECORD
3. [ ] INDICATES DATA OF RECORD PER M91-24, SURVEY FILED BY RICHARD J. HINTZ, L.S.497
4. / / / / INDICATES LINES POSTED THIS SURVEY

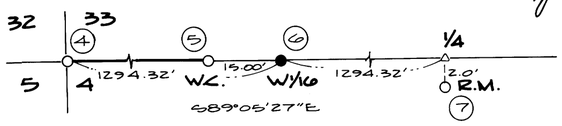

DETAIL A

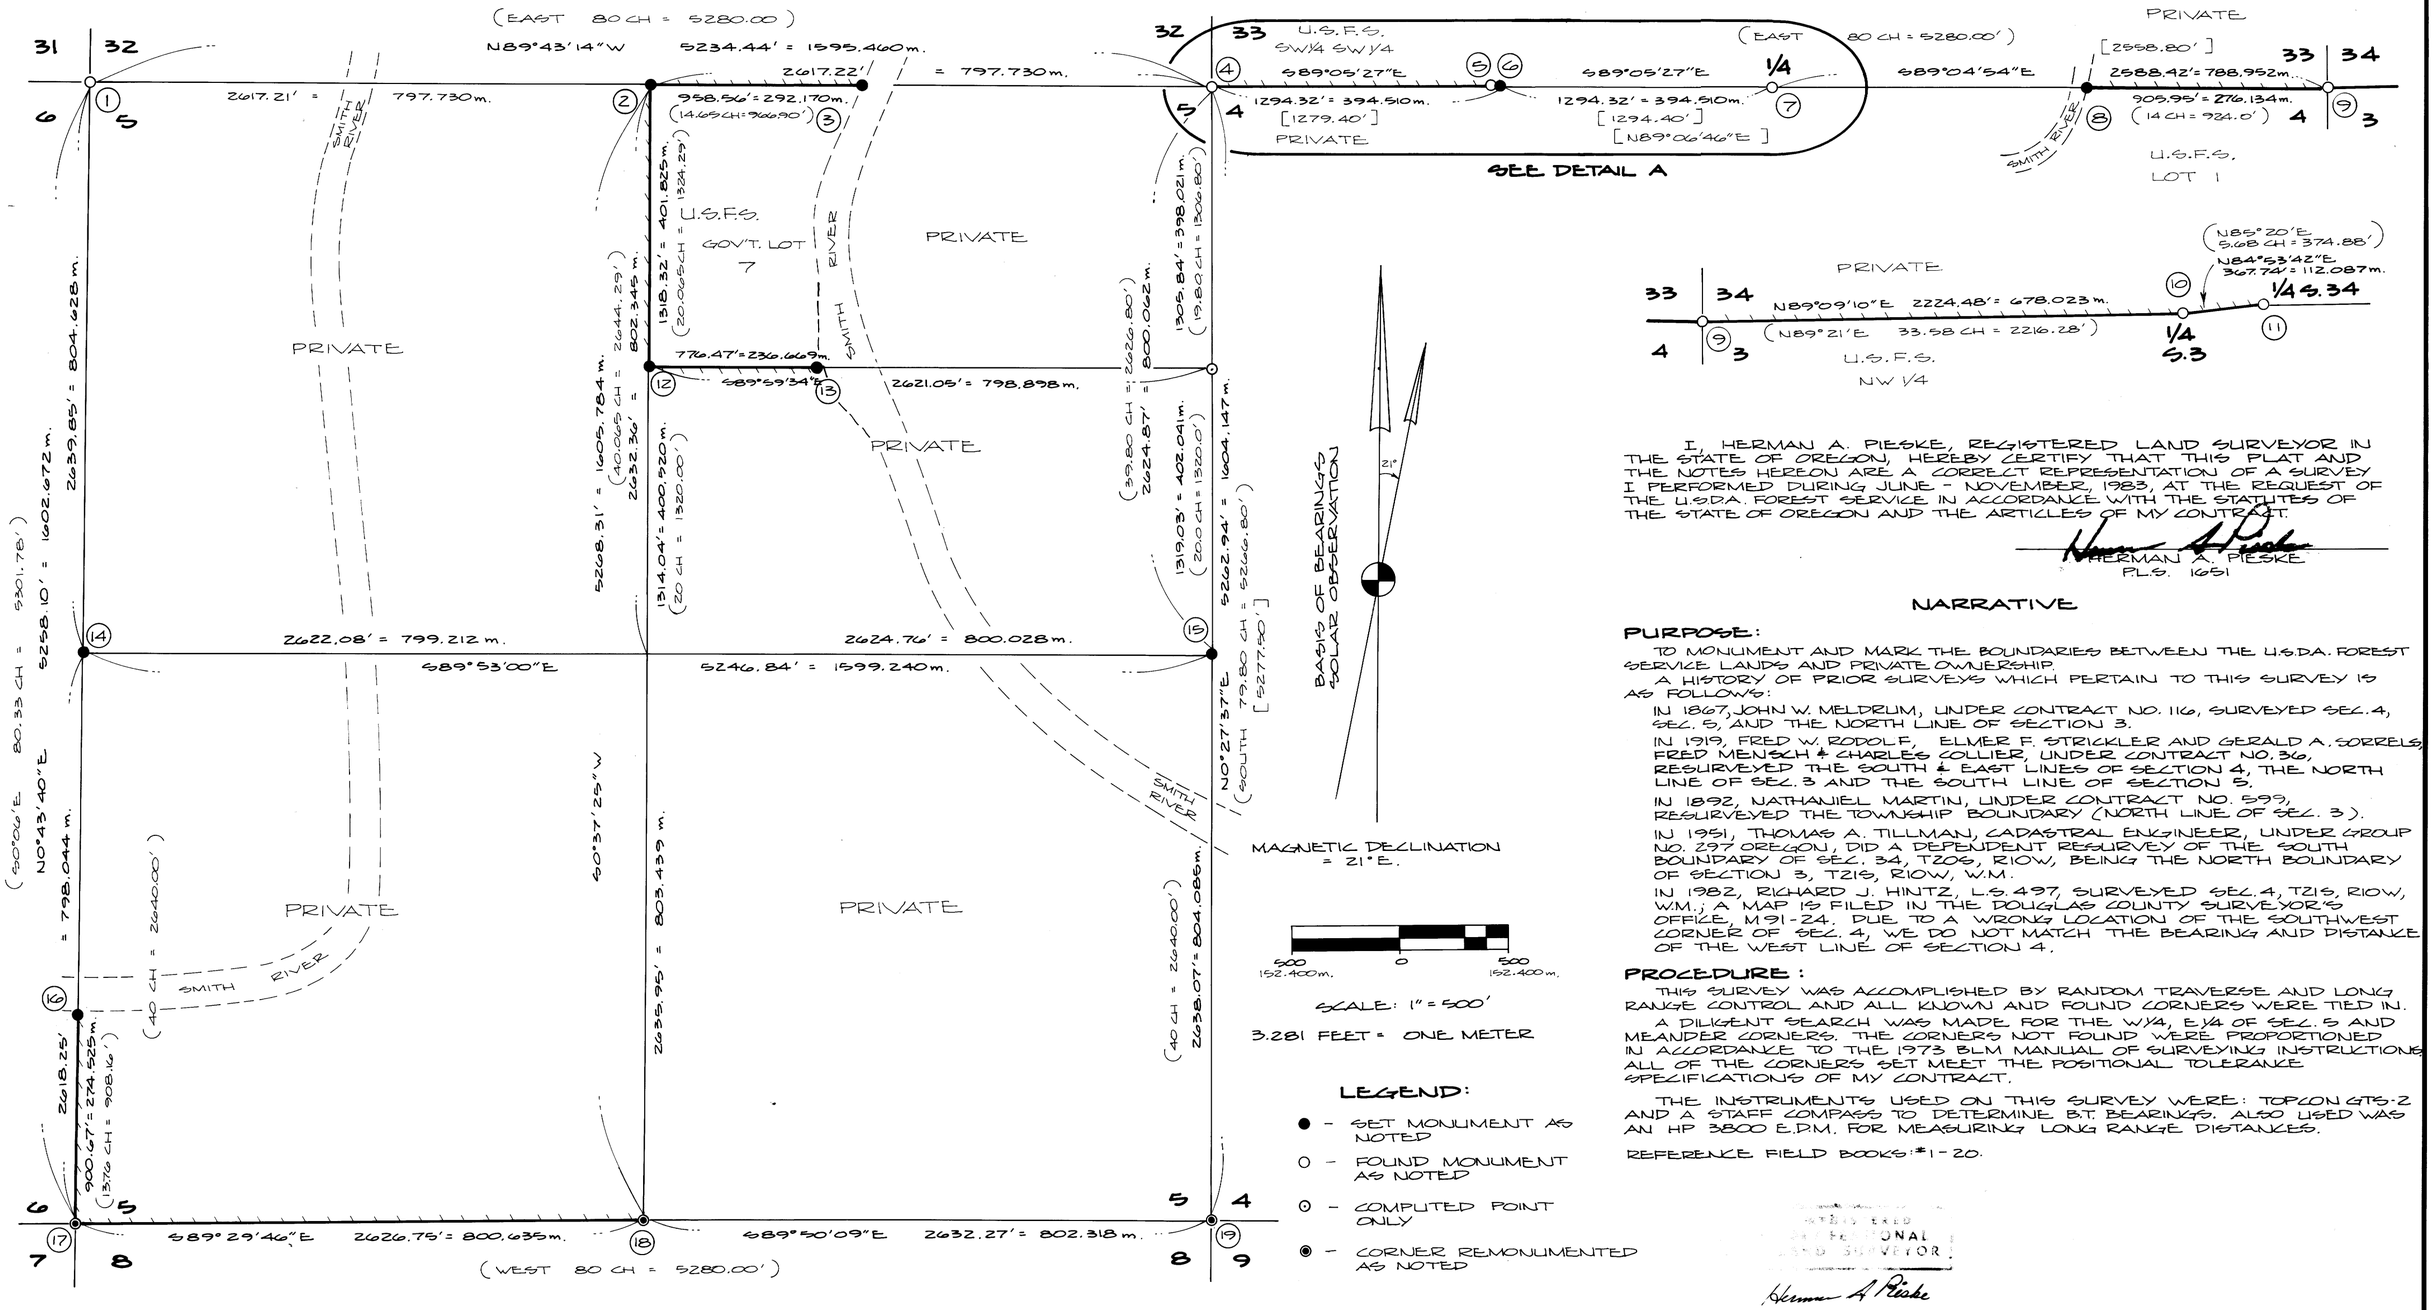

I, HERMAN A. PIESKE, REGISTERED LAND SURVEYOR IN THE STATE OF OREGON, HEREBY CERTIFY THAT THIS PLAT AND THE NOTES HEREON ARE A CORRECT REPRESENTATION OF A SURVEY I PERFORMED DURING JUNE - NOVEMBER, 1983, AT THE REQUEST OF THE U.S.D.A. FOREST SERVICE IN ACCORDANCE WITH THE STATUTES OF THE STATE OF OREGON AND THE ARTICLES OF MY CONTRACT.

HERMAN A. PIESKE
P.L.S. 1651

LEGEND:

- ● - SET MONUMENT AS NOTED
- ○ - FOUND MONUMENT AS NOTED
- ⊙ - COMPUTED POINT ONLY
- ◉ - CORNER REMONUMENTED AS NOTED

NARRATIVE

PURPOSE:

TO MONUMENT AND MARK THE BOUNDARIES BETWEEN THE U.S.D.A. FOREST SERVICE LANDS AND PRIVATE OWNERSHIP.

A HISTORY OF PRIOR SURVEYS WHICH PERTAIN TO THIS SURVEY IS AS FOLLOWS:

IN 1867, JOHN W. MELDRUM, UNDER CONTRACT NO. 116, SURVEYED SEC. 4, SEC. 5, AND THE NORTH LINE OF SECTION 3.

IN 1919, FRED W. RODOLF, ELMER F. STRICKLER AND GERALD A. SORRELS, FRED MENSCH & CHARLES COLLIER, UNDER CONTRACT NO. 36, RESURVEYED THE SOUTH & EAST LINES OF SECTION 4, THE NORTH LINE OF SEC. 3 AND THE SOUTH LINE OF SECTION 5.

IN 1892, NATHANIEL MARTIN, UNDER CONTRACT NO. 599, RESURVEYED THE TOWNSHIP BOUNDARY (NORTH LINE OF SEC. 3).

IN 1951, THOMAS A. TILLMAN, CADASTRAL ENGINEER, UNDER GROUP NO. 297 OREGON, DID A DEPENDENT RESURVEY OF THE SOUTH BOUNDARY OF SEC. 34, T20S, R10W, BEING THE NORTH BOUNDARY OF SECTION 3, T21S, R10W, W.M.

IN 1982, RICHARD J. HINTZ, L.S. 497, SURVEYED SEC. 4, T21S, R10W, W.M.; A MAP IS FILED IN THE DOUGLAS COUNTY SURVEYOR'S OFFICE, M91-24. DUE TO A WRONG LOCATION OF THE SOUTHWEST CORNER OF SEC. 4, WE DO NOT MATCH THE BEARING AND DISTANCE OF THE WEST LINE OF SECTION 4.

PROCEDURE:

THIS SURVEY WAS ACCOMPLISHED BY RANDOM TRAVERSE AND LONG RANGE CONTROL AND ALL KNOWN AND FOUND CORNERS WERE TIED IN.

A DILIGENT SEARCH WAS MADE FOR THE W1/4, E1/4 OF SEC. 5 AND MEANDER CORNERS. THE CORNERS NOT FOUND WERE PROPORTIONED IN ACCORDANCE TO THE 1973 BLM MANUAL OF SURVEYING INSTRUCTIONS. ALL OF THE CORNERS SET MEET THE POSITIONAL TOLERANCE SPECIFICATIONS OF MY CONTRACT.

THE INSTRUMENTS USED ON THIS SURVEY WERE: TOPCON GTS-2 AND A STAFF COMPASS TO DETERMINE B.T. BEARINGS. ALSO USED WAS AN HP 3800 E.D.M. FOR MEASURING LONG RANGE DISTANCES.

REFERENCE FIELD BOOKS: #1-20.

REGISTERED PROFESSIONAL LAND SURVEYOR

PREPARED BY:

AA SURVEYING SERVICE, INC., P.O. BOX 130, ROSEBURG, OREGON 97470

CONTRACT NO. 53-04T0-3-0870N

M95-59A
M95-59A #2
FILE