BUREAU OF LAND MANAGEMENT FILE DATA
DO NOT REMOVE FROM OFFICE

Resurvey of S ½ & NW ¼ And Subdivision of SW ¼ of Sec. 34, T30S, R3W, W.M.

For Roseburg Lumber Company — Scale: 1" = 400' — August 26, 1983

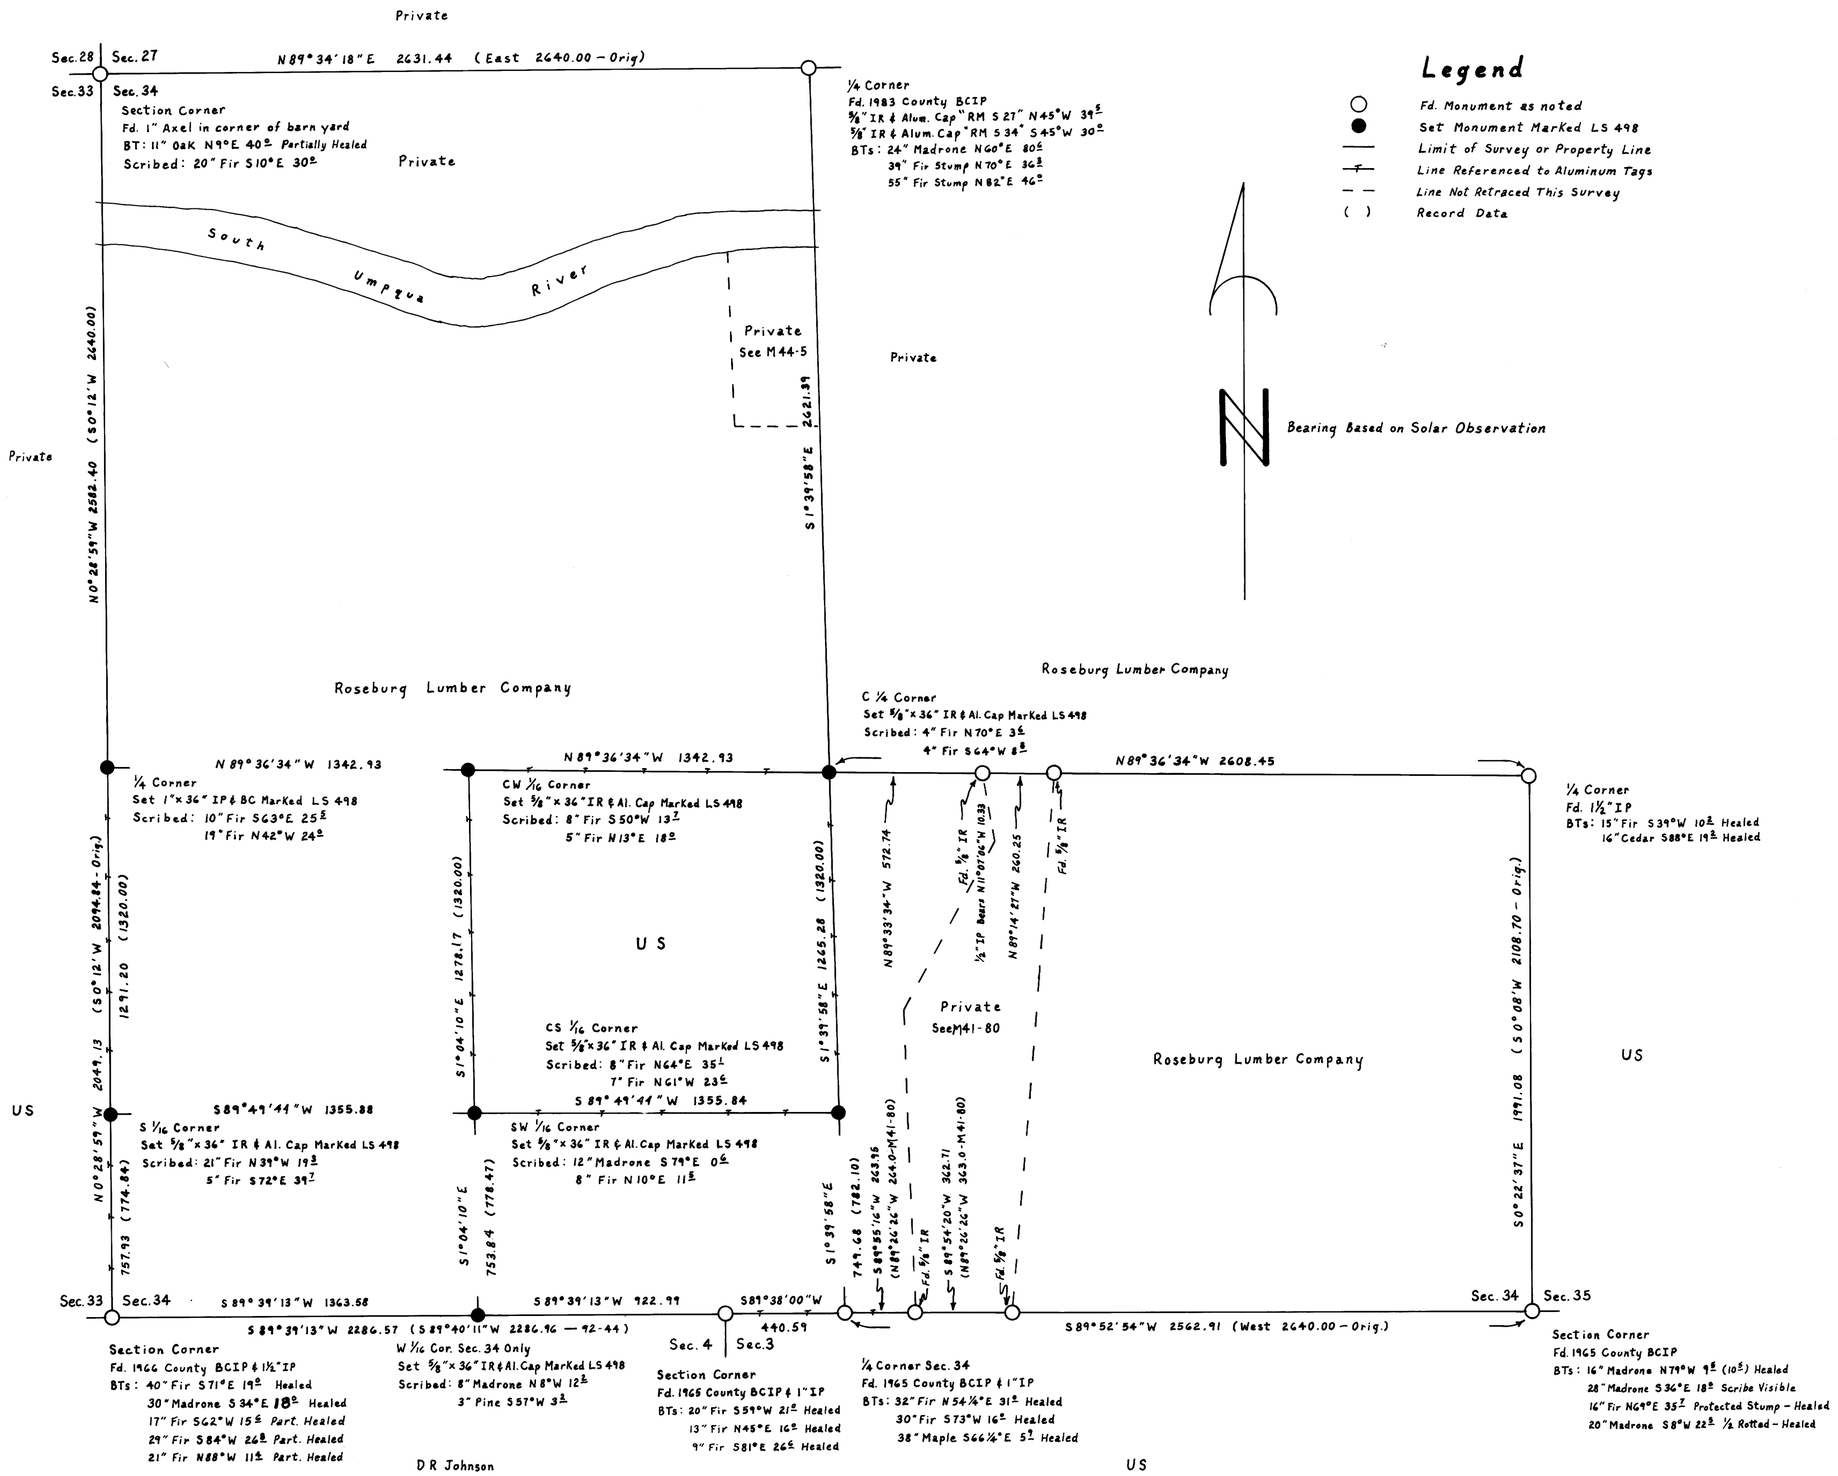

Legend

- Fd. Monument as noted
- Set Monument Marked LS 498
- Limit of Survey or Property Line
- Line Referenced to Aluminum Tags
- Line Not Retraced This Survey
- ( ) Record Data

Bearing Based on Solar Observation

I ran a closed Traverse in Section 34 using a Jena one second theodolite and a Mac 1-E EDM. I achieved a precision of 1:97,453 on the exterior and 1:56,465 on the interior. I adjusted both traverses by the Crandall method. I set the ¼ corner and South 1/16 corner to Sections 33 and 34 and the Center South 1/16 corner and Southwest 1/16 corner to Section 34 by proportion based on the original distances.

Howard W. Johnstone P.O. Box 1088 Roseburg, Oregon

REGISTERED PROFESSIONAL LAND SURVEYOR
Howard W. Johnstone
OREGON
MAY 13, 1960
HOWARD W. JOHNSTONE
498

M95-6