SURVEY TO MARK PROPERTY LINES

COUNTY SURVEYORS FILE DATA
DO NOT REMOVE FROM OFFICE

FOR CAPITAL VENEER

IN SECTION 14, T29S, R9W, W.M.

SCALE: 1" = 500' JANUARY 1984

M95-754

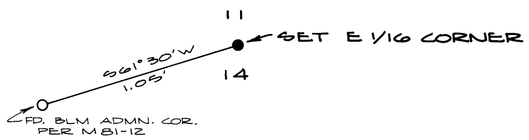

DETAIL A

NOT TO SCALE

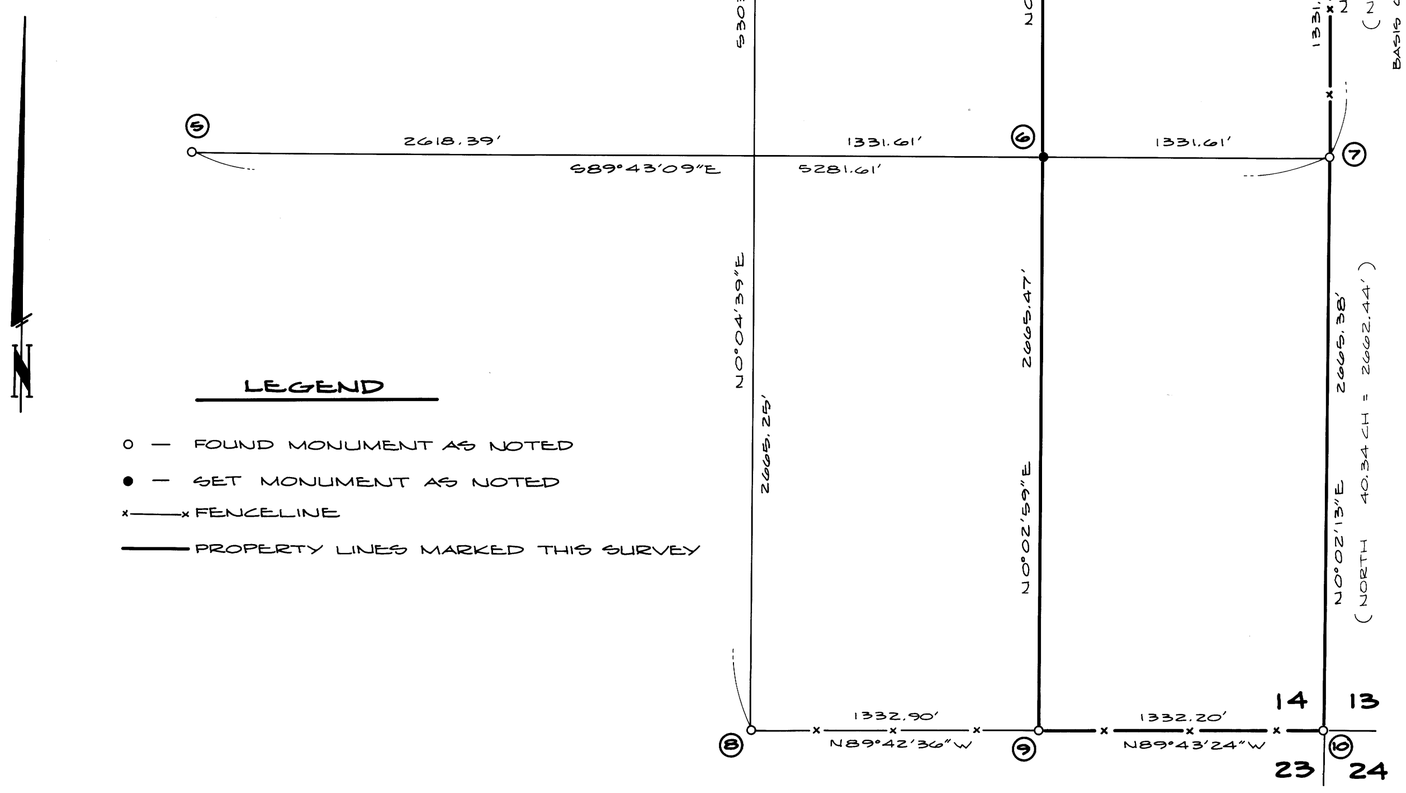

NARRATIVE

PURPOSE:

TO SURVEY AND MARK THE BOUNDARY LINES OF THE E½ E½ OF SECTION 14.

PROCEDURE:

I FOUND AND TIED INTO OUR CLOSED LOOP TRAVERSE THE FOLLOWING CORNERS ALONG THE PERIMETER OF SECTION 14: THE N¼, NE COR., E¼, SE COR., S¼, W¼ AND E1/16 COR. ON THE SOUTH LINE. I FOUND THE E1/16 COR. ON THE NORTH LINE SET BY A BLM ADMINISTRATIVE SURVEY, FILED AS M 81-12. I DID NOT ACCEPT THIS CORNER AS IT WAS SLIGHTLY OFF FOR LINE AND DISTANCE, I SET THE E1/16 COR. ON THE NORTH LINE AND THE CE1/16 COR. OF THE SECTION. BASE OF BEARING PER GLO PLAT-1966.

EQUIPMENT USED ON THIS SURVEY:

TOPCON GTS-1, TOPCON GTS-2, LEITZ 20C AND TOPCON EDM DCM-2.

REGISTERED
PROFESSIONAL
LAND SURVEYOR

OREGON
MAY 13, 1960
EUGENE A. BLOOM
492

MAP PREPARED BY:

AA SURVEYING SERVICE, INC. - P.O. BOX 130 - ROSEBURG, OREGON 97470

M95-754